


number	date	description
	DEC. 4 1970	A) REVISED SHAFTS. B) INCLUDED V.D.'S & E.L.T.'S C) CONFORMED TO EAST BID AS PER APPENDUM NO. 1.

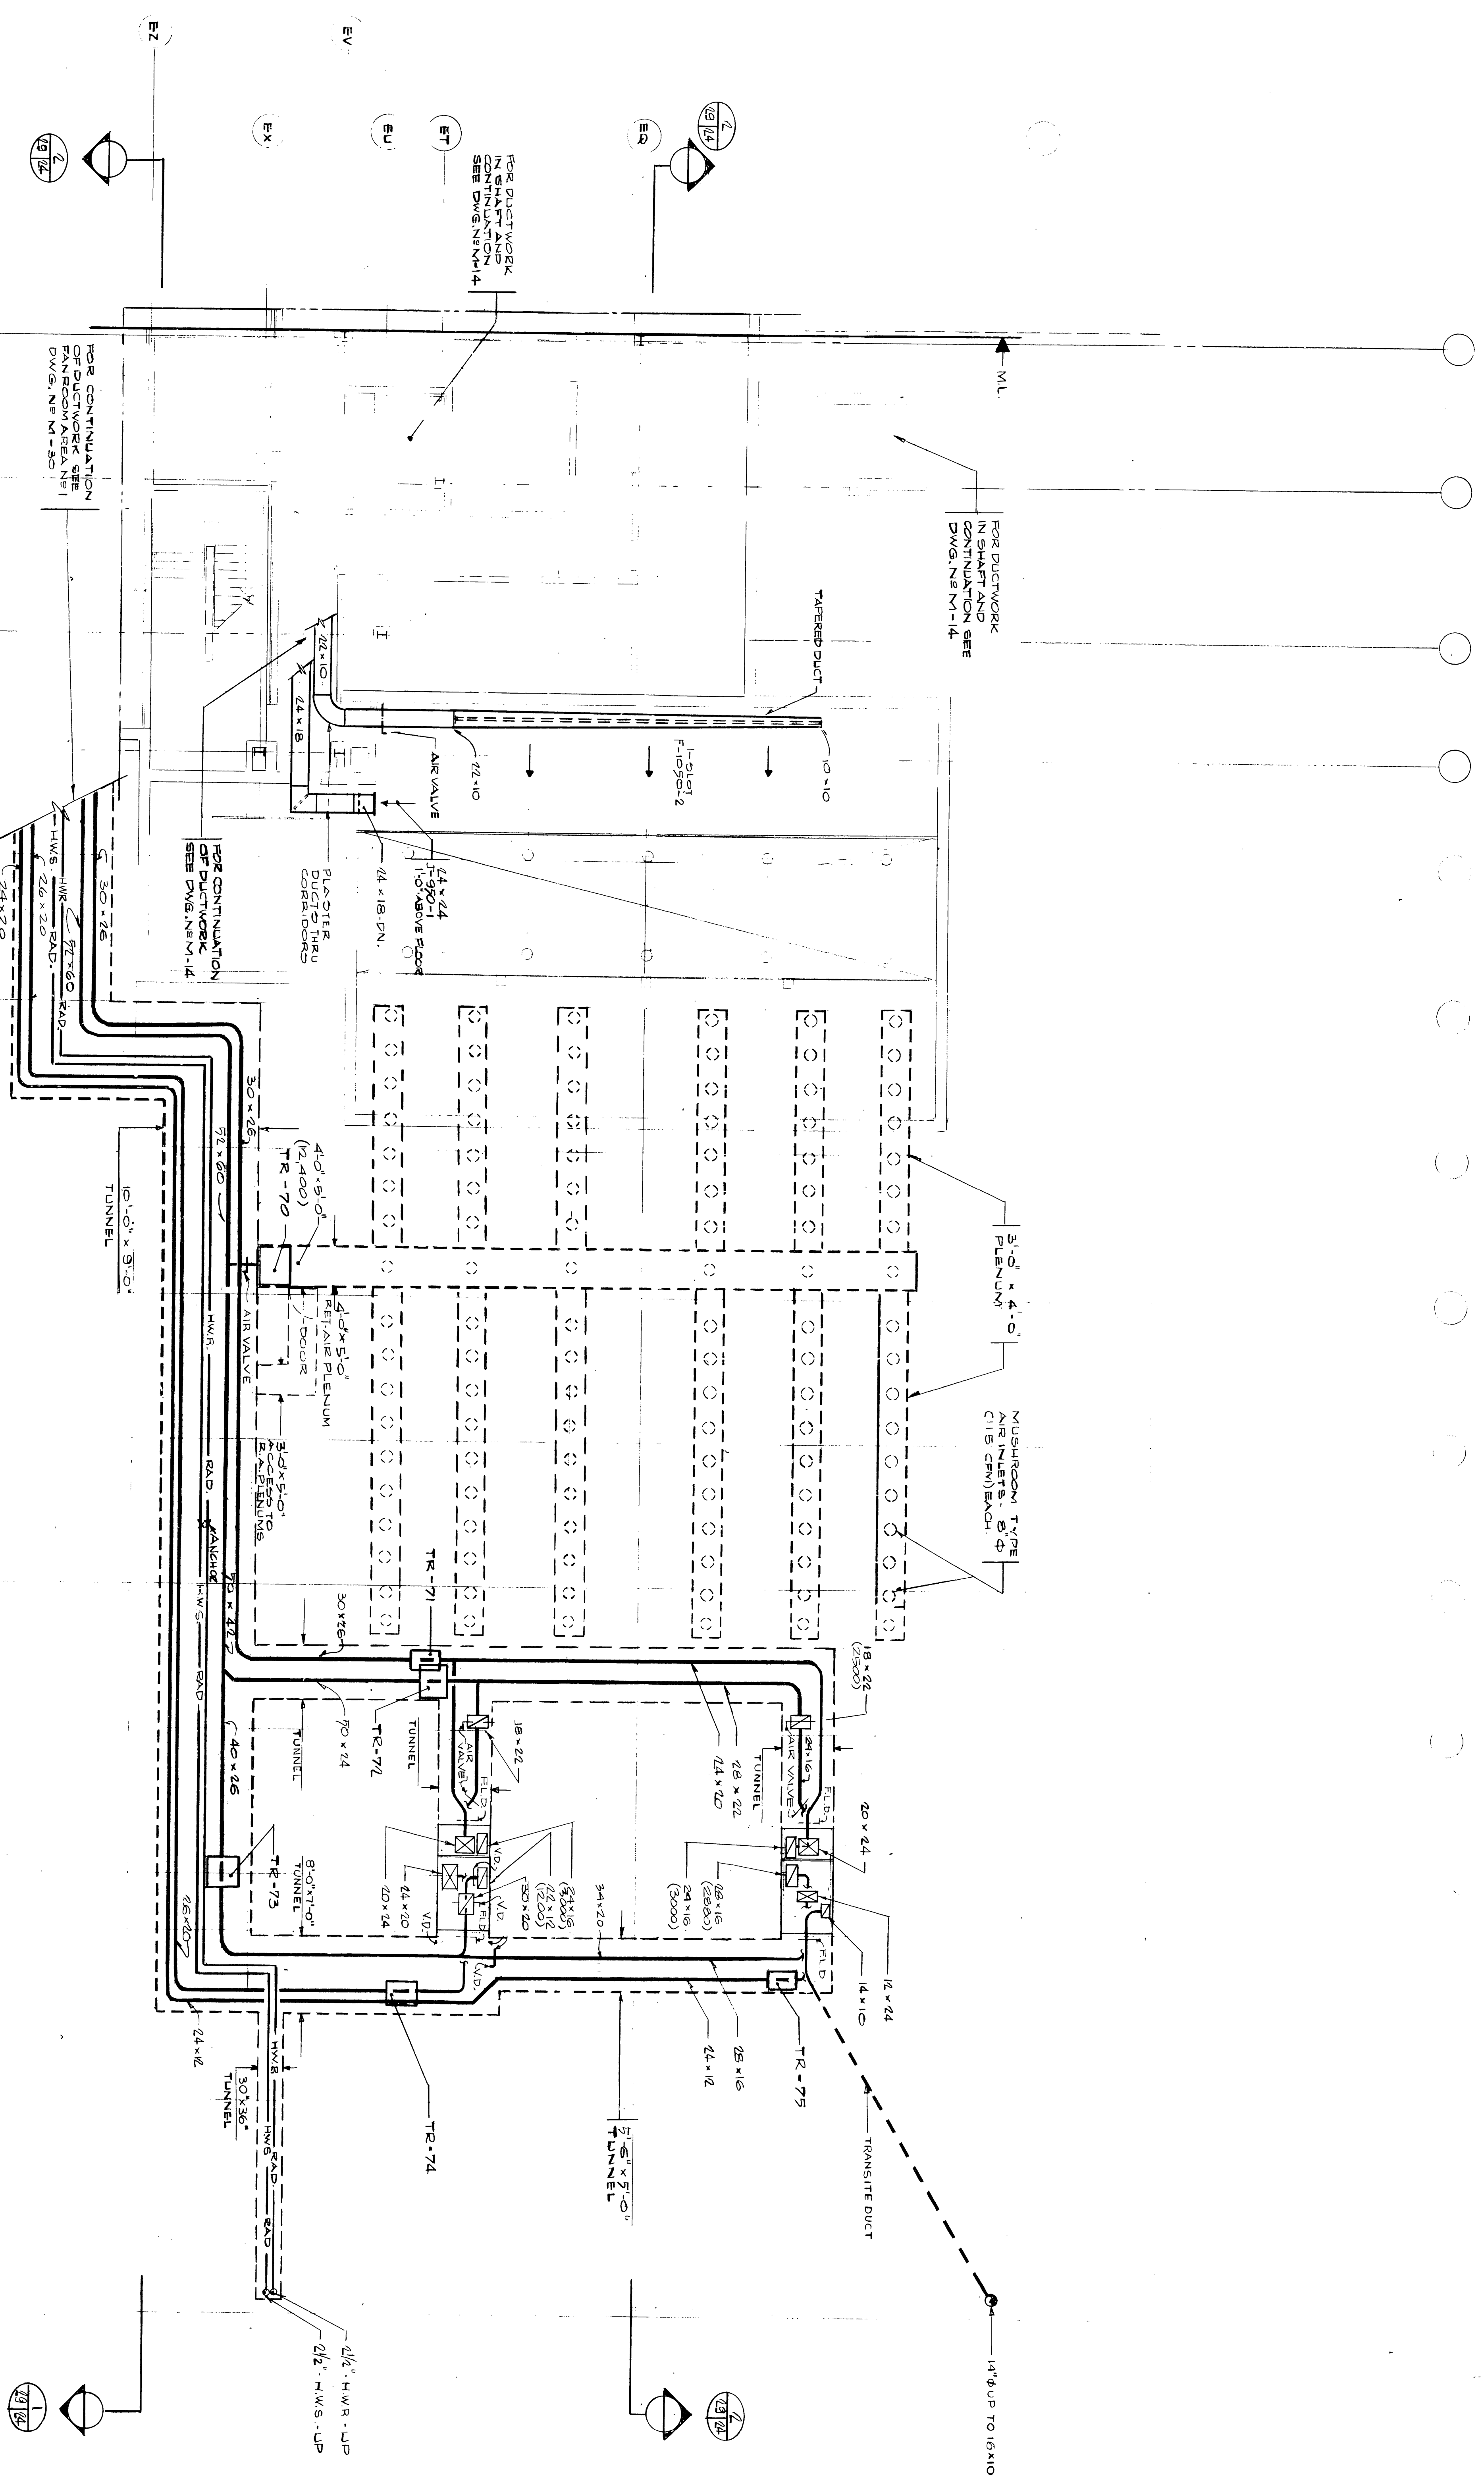


AS BUILT

STATE UNIVERSITY OF NEW YORK COLLEGE AT
POTSDAM
 STATE UNIVERSITY CONSTRUCTION PLANO
POTSDAM MUSIC CENTER

EDWARD LARRABEE BARNES FAMA
 PETER G. ROLLAND & ASSOCIATES
 CONSULTING ASSOCIATES
 EITUNGEN & SCHLOSSBERG ASSOCIATES

ARCHITECTS
 INTERIOR DESIGNERS
 MECHANICAL ENGINEERS
 ELECTRICAL ENGINEERS

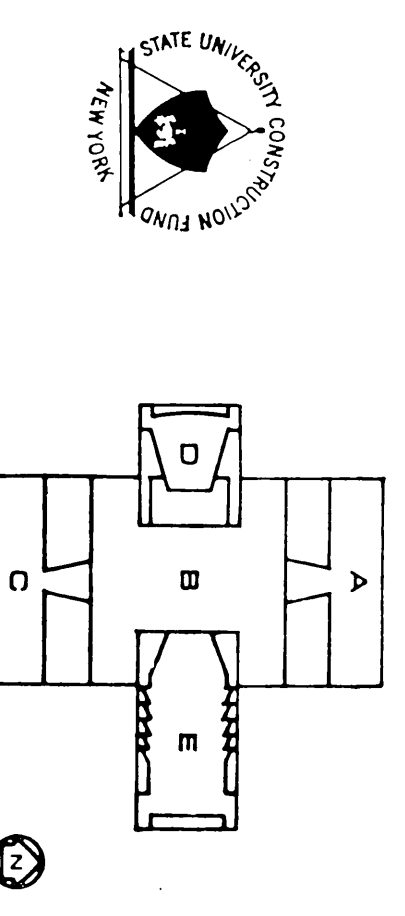

PROJECT NUMBER: 2022154
BUILDING "E"
BASEMENT PLAN
PMc M-24
10/1/2022