



SIENNA ENVIRONMENTAL TECHNOLOGIES, LLC

429 Franklin St. · Suite 102 · Buffalo, NY 14202 · Ph: 716-332-3134 · Fax: 716-332-3136

December 31, 2008

Mr. Jeffrey Robbins
C&S Engineers
499 Colonel Eileen Collins Boulevard
Syracuse, New York 13212

**Re: Summary of Asbestos Containing Materials by Building
Upgrade Electrical Distribution System – Various Buildings
SUCF Project No. 12290
SUNY Potsdam
Potsdam, New York**

Dear Mr. Robbins:

Enclosed please find a copy of the summary of asbestos containing materials in client-defined areas of twenty two buildings on the SUNY Potsdam campus located at 44 Pierrepont Avenue, Potsdam, New York. A comprehensive pre-renovation asbestos and lead inspection report shall be sent as a separate document after all results are evaluated in our office.

If after reviewing this summary you have any questions, or if we can be of assistance in any other way, please do not hesitate to call. Thank you for the opportunity to be of service to C&S Engineers and SUNY Potsdam.

Sincerely,



Susanne Kelley
President

RAY 120908 SIE
MOR
MAC
STL

FLG
CAR
KEL
TIM
STW
CRM
SAT
THA
DUN
SIS
BRI
BAR
MER
MAX
LEH
CRN



SIENNA ENVIRONMENTAL TECHNOLOGIES, LLC

429 Franklin St. • Suite 102 • Buffalo, NY 14202 • Ph: 716-332-3134 • Fax: 716-332-3136

Summary of Asbestos Containing Materials

Introduction

Sienna Environmental Technologies was retained by C&S Engineers to perform an investigation of select areas of twenty two buildings on the SUNY Potsdam Campus in Potsdam, New York for the presence of suspect asbestos-containing materials. The inspection was limited to suspect materials present at client-defined locations of the buildings to be disturbed during the proposed renovation of the electrical distribution systems.

Sienna was charged with:

- * Locating suspect asbestos containing materials at client defined locations
- * Sampling of these materials to ascertain asbestos content
- * Identifying the locations, quantities and conditions of confirmed asbestos containing materials

Samples were analyzed using PLM, Polarized Light Microscopy in accordance with NYS DOH ELAP Item #198.1 and/or #198.6. For materials classified as non-friable organically bound materials (NOBs), additional analysis was performed under Transmission Electron Microscopy (TEM) in accordance with NYS DOH ELAP Item #198.4. The results of the analyses confirmed whether or not a suspect material contained asbestos.



SIENNA ENVIRONMENTAL TECHNOLOGIES, LLC

429 Franklin St. • Suite 102 • Buffalo, NY 14202 • Ph: 716-332-3134 • Fax: 716-332-3136

Executive summary

The asbestos survey included identification, sampling, analysis and quantification of suspect materials within client defined areas of twenty two buildings located on the SUNY Potsdam campus which may be disturbed by current renovation plans.

A. Suspect asbestos-containing materials

The inspection was conducted between December 9, 2008 and December 17, 2008 and revealed the following materials as requiring sampling and analysis:

Raymond Hall

HAN Number	Description
RAY-100A / 200A	Drywall
RAY-100B / 200B	Drywall joint compound
RAY-101	Cinder block mortar
RAY-201	1x1 Spine dot and fissure ceiling tile
RAY-202	2x2 dot and texture ceiling tile

Morey Hall

HAN Number	Description
MOR-100A / 200A	Sand finish plaster skim coat
MOR-100B / 200B	Sand finish plaster base coat
MOR-101A / 202A	Smooth plaster skim coat
MOR-101B / 202B	Smooth plaster base coat
MOR-102A / 201A	Drywall
MOR-102B / 201B	Drywall joint compound

MacVicar Hall

HAN Number	Description
MCV-100A / 200A	Sand finish plaster skim coat
MCV-100B / 200B	Sand finish plaster base coat
MCV-201A	Ceiling smooth plaster skim coat
MCV-201B	Ceiling smooth plaster base coat

Stillman Hall

HAN Number	Description
STL-100A / 200A	Drywall
STL-100B / 200B	Drywall joint compound
STL-201	2x2 dot and large fissure ceiling tile



SIENNA ENVIRONMENTAL TECHNOLOGIES, LLC

429 Franklin St. • Suite 102 • Buffalo, NY 14202 • Ph: 716-332-3134 • Fax: 716-332-3136

Flagg Hall

HAN Number	Description
FLG-100	Cinder block mortar
FLG-101A / 201A	Plaster skim coat
FLG-101B / 201B	Plaster base coat
FLG-102A	Drywall
FLG-102B	Drywall joint compound
FLG-200	2x2 dot and texture ceiling tile
FLG-202	Popcorn ceiling finish
FLG-300	Brick floor mortar
FLG-400A	Cloth on mud fitting
FLG-400B	Mud fitting
FLG-600	Vibration dampener

Carson Hall

HAN Number	Description
CAR-100A / 200A	Drywall
CAR-100B / 200B	Drywall joint compound
CAR-101	Cinder block mortar
CAR-102A	Plaster skim coat
CAR-102B	Plaster base coat
CAR-201	2x2 large fissure ceiling tile
CAR-202A	Textured plaster skim coat
CAR-202B	Textured plaster base coat

Kellas Hall

HAN Number	Description
KEL-100	Cinder block mortar
KEL-101	Brick mortar
KEL-102A / 200A	Plaster skim coat
KEL-102B / 200B	Plaster base coat
KEL-103A	Drywall
KEL-103B	Drywall joint compound
KEL-201	2x4 ceiling tile
KEL-500	Spray-on Insulation

Timmerman Hall

HAN Number	Description
TIM-100A / 200A	Plaster skim coat
TIM-100B / 200B	Plaster base coat
TIM-101	Cinder block mortar
TIM-102A	Grout of 2x2 ceramic tile
TIM-102B	Mortar of 2x2 ceramic tile



SIENNA ENVIRONMENTAL TECHNOLOGIES, LLC

429 Franklin St. · Suite 102 · Buffalo, NY 14202 · Ph: 716-332-3134 · Fax: 716-332-3136

Stowell Hall

HAN Number	Description
STO-100	Cinder block mortar
STO-101	Glazed block mortar
STO-102	Cementitious panel
STO-103A / 202A	Plaster skim coat
STO-103B / 202B	Plaster base coat
STO-104	Mortar of white brick
STO-200	2x4 dot and fissure ceiling tile
STO-201	2x4 dot ceiling tile

Crumb Library

HAN Number	Description
CRU-100A	Plaster skim coat
CRU-100B	Plaster base coat
CRU-101	Cinder block mortar
CRU-102	Brick mortar
CRU-200	1x1 dot and fissure ceiling tile
CRU-201	2x2 dot and texture ceiling tile

Satterlee Hall

HAN Number	Description
SAT-100A / 201A	Plaster skim coat
SAT-100B / 201B	Plaster base coat
SAT-101A	Sand plaster skim coat
SAT-101B	Sand plaster base coat
SAT-102	Glazed block mortar
SAT-103	Cinder block mortar
SAT-104A	Drywall
SAT-104B	Drywall joint compound
SAT-200	1x1 splined ceiling tile
SAT-202	1x1 textured ceiling tile
SAT-203	2x2 dot and texture ceiling tile
SAT-204	2x2 dot ceiling tile

Thatcher Hall

HAN Number	Description
THA-100	Cinder block mortar
THA-101A	Grout of ceramic tile
THA-101B	Thinset of ceramic tile
THA-102A	Plaster skim coat
THA-102B	Plaster base coat
THA-200	1x1 fissure ceiling tile
THA-201	2x2 Gypsum ceiling tile



SIENNA ENVIRONMENTAL TECHNOLOGIES, LLC

429 Franklin St. • Suite 102 • Buffalo, NY 14202 • Ph: 716-332-3134 • Fax: 716-332-3136

Dunn Hall

HAN Number	Description
DUN-100A	Drywall
DUN-100B	Drywall joint compound
DUN-101	Glazed block mortar
DUN-200	2x2 dot ceiling tile
DUN-201A	1x1 dot ceiling tile
DUN-201B	Glue daub of 201A
DUN-202	2x2 large dot ceiling tile
DUN-203A	Plaster skim coat
DUN-203B	Plaster base coat
DUN-204	Textured finish
DUN-300	Terrazzo

Sisson Hall

HAN Number	Description
SIS-100A	Plaster skim coat
SIS-100B	Plaster base coat
SIS-101	Lightweight concrete
SIS-102	Wallpaper
SIS-200	Insulation material
SIS-201A	1x1 texture ceiling tile
SIS-201B	Glue daub of 201A
SIS-202	2x2 dot ceiling tile
SIS-203	Texture ceiling

Brainerd Hall

HAN Number	Description
BRA-100A / 202A	Plaster skim coat
BRA-100B / 202B	Plaster base coat
BRA-101	Cinder block mortar
BRA-200	2x4 dot ceiling tile
BRA-201	Popcorn ceiling finish
BRA-203A	Drywall
BRA-203B	Drywall joint compound
BRA-300	Brick mortar



SIENNA ENVIRONMENTAL TECHNOLOGIES, LLC

429 Franklin St. • Suite 102 • Buffalo, NY 14202 • Ph: 716-332-3134 • Fax: 716-332-3136

Barrington Student Union


HAN Number	Description
BAR-100A	Plaster skim coat
BAR-100B	Plaster base coat
BAR-101A	Drywall
BAR-101B	Drywall joint compound
BAR-102	Wallpaper
BAR-103	Cinder block mortar
BAR-200	2x4 dot and fissure ceiling tile
BAR-201	2x2 dot and fissure ceiling tile
BAR-202	2x2 smooth ceiling tile
BAR-203	1x1 ceiling tile
BAR-204	Popcorn ceiling finish

Merritt Hall

HAN Number	Description
MER-100A / 200A	Plaster skim coat
MER-100B / 200B	Plaster base coat
MER-101	Glazed block mortar
MER-102A	Drywall
MER-102B	Drywall joint compound
MER-103A	Grout of ceramic tile
MER-103B	Thinset of ceramic tile
MER-104	Cinder block mortar
MER-105	Textured wall finish
MER-201A	1x1 dot ceiling tile
MER-201B	Glue daub of 201A
MER-202	2x2 cementitious ceiling tile
MER-203	2x2 dot and fissure ceiling tile
MER-300A	18x6 black floor tile
MER-300B	Black mastic of 300A
MER-301	Terrazzo

Maxcy Hall

HAN Number	Description
MAX-100	Cinder block mortar
MAX-101	Brick mortar
MAX-200	2x4 dot ceiling tile
MAX-201	Popcorn ceiling finish

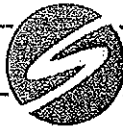

SIENNA ENVIRONMENTAL TECHNOLOGIES, LLC

429 Franklin St. • Suite 102 • Buffalo, NY 14202 • Ph: 716-332-3134 • Fax: 716-332-3136

Lehmann Dining Hall

HAN Number	Description
LEH-100A	Drywall
LEH-100B	Drywall joint compound

Crane Music Complex

HAN Number	Description
CRA-100	Cinder block mortar
CRA-101A	Drywall
CRA-101B	Drywall joint compound
CRA-102	Cementitious wall board

Heating Plant / Service Center

HAN Number	Description
HPL-100	Cinder block mortar
HPL-101	Brick mortar

Knowles Dining Hall

HAN Number	Description
KNO-100	Brick mortar



SIENNA ENVIRONMENTAL TECHNOLOGIES, LLC

429 Franklin St. • Suite 102 • Buffalo, NY 14202 • Ph: 716-332-3134 • Fax: 716-332-3136

B. Confirmed asbestos-containing materials

Sampling and analysis of the suspect materials under Polarized Light Microscopy, and where necessary under Transmission Electron Microscopy, confirmed the following materials as asbestos containing building materials (laboratory reports and chains of custody are attached):

Raymond Hall

Material #	Description - Component	Condition
RAY-100B/200B	Drywall joint compound – Walls and ceilings	I

Morey Hall

- All samples were analyzed as less than 1% asbestos. Materials are considered asbestos-containing when they are analyzed as greater than 1% asbestos.

MacVicar Hall

- All samples were analyzed as less than 1% asbestos. Materials are considered asbestos-containing when they are analyzed as greater than 1% asbestos.

Stillman Hall

- All samples were analyzed as less than 1% asbestos. Materials are considered asbestos-containing when they are analyzed as greater than 1% asbestos.

Flagg Hall

- All samples were analyzed as less than 1% asbestos. Materials are considered asbestos-containing when they are analyzed as greater than 1% asbestos.

Carson Hall

Material #	Description - Component	Condition
CAR-202A	Textured plaster skim coat – Ceilings	I

Kellis Hall

- All samples were analyzed as less than 1% asbestos. Materials are considered asbestos-containing when they are analyzed as greater than 1% asbestos.

Timmerman Hall

- All samples were analyzed as less than 1% asbestos. Materials are considered asbestos-containing when they are analyzed as greater than 1% asbestos.



SIENNA ENVIRONMENTAL TECHNOLOGIES, LLC

429 Franklin St. • Suite 102 • Buffalo, NY 14202 • Ph: 716-332-3134 • Fax: 716-332-3136

Stowell Hall

Material #	Description - Component	Condition
STO-102	Cementitious panel – Room 116 walls	I

Crumb Library

- All samples were analyzed as less than 1% asbestos. Materials are considered asbestos-containing when they are analyzed as greater than 1% asbestos.

Satterlee Hall

- All samples were analyzed as less than 1% asbestos. Materials are considered asbestos-containing when they are analyzed as greater than 1% asbestos.

Thatcher Hall

- All samples were analyzed as less than 1% asbestos. Materials are considered asbestos-containing when they are analyzed as greater than 1% asbestos.

Dunn Hall

- All samples were analyzed as less than 1% asbestos. Materials are considered asbestos-containing when they are analyzed as greater than 1% asbestos.

Slisson Hall

- All samples were analyzed as less than 1% asbestos. Materials are considered asbestos-containing when they are analyzed as greater than 1% asbestos.

Brainerd Hall

- All samples were analyzed as less than 1% asbestos. Materials are considered asbestos-containing when they are analyzed as greater than 1% asbestos.

Barrington Student Union

- All samples were analyzed as less than 1% asbestos. Materials are considered asbestos-containing when they are analyzed as greater than 1% asbestos.

Merritt Hall

Material #	Description - Component	Condition
MER-202	2x2 Cementitious ceiling tile – Ceiling over pool	I
MER-300A/300B	18x6 Floor tile and mastic – Women's locker room	I



SIENNA ENVIRONMENTAL TECHNOLOGIES, LLC

429 Franklin St. • Suite 102 • Buffalo, NY 14202 • Ph: 716-332-3134 • Fax: 716-332-3136

Maxcy Hall

- All samples were analyzed as less than 1% asbestos. Materials are considered asbestos-containing when they are analyzed as greater than 1% asbestos.

Lehmann Dining Hall

- All samples were analyzed as less than 1% asbestos. Materials are considered asbestos-containing when they are analyzed as greater than 1% asbestos.

Crane Music Complex

Material #	Description - Component	Condition
CRA-102	Transite wall board – Snell upper level control rooms	I

Heating Plant / Service Center

- All samples were analyzed as less than 1% asbestos. Materials are considered asbestos-containing when they are analyzed as greater than 1% asbestos.

Knowles Dining Hall

- All samples were analyzed as less than 1% asbestos. Materials are considered asbestos-containing when they are analyzed as greater than 1% asbestos.

Condition Notes: I = Intact D = Damaged SD = Significantly Damaged



SIENNA ENVIRONMENTAL TECHNOLOGIES, LLC

429 Franklin St. · Suite 102 · Buffalo, NY 14202 · Ph: 716-332-3134 · Fax: 716-332-3136

LABORATORY REPORT

Attn: Jeffrey Robbins
C & S Engineers
499 Col. Eileen Collins Blvd
Syracuse, NY 13212
Phone: 315-455-2000 Fax: 315-455-9667
Project: SET954 **Raymond Hall**

Date Received: 12/12/2008
Date Analyzed: 12/18/2008
Sienna ID: P145

Polarized Light Microscopy (PLM) by NY State ELAP Method 198.1

Sample	Description	Location	% Fibrous	% Non-Fibrous	% Asbestos Type
1209-RAY-100A-1 P145-1	Gray, Fibrous, Non-Homogenous	Drywall - 8th Floor	20%	80%	NAD
1209-RAY-100A-2 P145-2	Gray, Fibrous, Non-Homogenous	Drywall - 7th Floor	20%	80%	NAD
1209-RAY-100B-1 P145-3	White, Fibrous, Homogenous	Joint Compound - 8th Floor	0%	100%	NAD
1209-RAY-100B-2 P145-4	White, Non-Fibrous, Homogenous	Joint Compound - 7th Floor	5%	95%	NAD
1209-RAY-100B-3 P145-5	White, Non-Fibrous, Homogenous	Joint Compound - 5th Floor	0%	100%	NAD
1209-RAY-100B-4 P145-6	White, Non-Fibrous, Homogenous	Joint Compound - 4th Floor	5%	95%	NAD
1209-RAY-100B-5 P145-7	White, Non-Fibrous, Homogenous	Joint Compound - 2nd Floor	5%	95%	1.8% Chrysotile
1209-RAY-101-1 P145-8	Gray, Non-Fibrous, Homogenous	Cinder Block Mortar - 6th Floor	0%	100%	NAD
1209-RAY-101-2 P145-9	Gray, Non-Fibrous, Homogenous	Cinder Block Mortar - 5th Floor	0%	100%	NAD
1209-RAY-200B-1 P145-10	White, Non-Fibrous, Homogenous	Celling Joint Comp - 8th Floor Kitchen	0%	100%	NAD
1209-RAY-200B-2 P145-11	White, Non-Fibrous, Homogenous	Celling Joint Comp - 1st Floor	0%	100%	NAD
1209-RAY-201-1 P145-12	Gray, Fibrous, Homogenous	1x1 Spline Dot & Fissure - 6th Floor	80%	20%	NAD
1209-RAY-201-2 P145-13	Gray, Fibrous, Homogenous	1x1 Spline Dot & Fissure - 6th Floor	75%	25%	NAD

Tracy Skalski
Analyst(s)


Approved Signatory

Disclaimers: NAD = No asbestos detected. Results relate only to samples provided by client. This report shall not be reproduced, except in full, without written approval by Sienna. Samples analyzed as NAD or Trace (<1%) cannot be guaranteed. Quantitative transmission electron microscopy is currently the only reliable method that can be used to determine if this material can be considered or treated as non-asbestos containing. Analysis performed by Sienna Environmental Technologies, NY ELAP #11727.



SIENNA ENVIRONMENTAL TECHNOLOGIES, LLC

429 Franklin St. • Suite 102 • Buffalo, NY 14202 • Ph: 716-332-3134 • Fax: 716-332-3136

LABORATORY REPORT


Attn: Jeffrey Robbins
C & S Engineers
499 Col. Eileen Collins Blvd
Syracuse, NY 13212
Phone: 315-455-2000 Fax: 315-455-9667
Project: SET954 Raymond Hall

Date Received: 12/12/2008
Date Analyzed: 12/18/2008
Sienna ID: P145

Polarized Light Microscopy (PLM) by NY State ELAP Method 198.1

Sample	Description	Location	% Fibrous	% Non-Fibrous	% Asbestos Type
1209-RAY-202-1 P145-14	Gray, Fibrous, Homogenous	2x2 Dot & Texture CT - 6th Floor	30%	70%	NAD
1209-RAY-202-2 P145-15	Gray, Fibrous, Homogenous	2x2 Dot & Texture CT - 6th Floor	30%	70%	NAD

Tracy Skalski
Analyst(s)

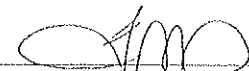
Approved Signatory

Disclaimer: NAD = No asbestos detected. Results relate only to samples provided by client. This report shall not be reproduced, except in full, without written approval by Sienna. Samples analyzed as NAD or Trace (<1%) cannot be guaranteed. Quantitative transmission electron microscopy is currently the only reliable method that can be used to determine if this material can be considered or treated as non-asbestos containing. Analysis performed by Sienna Environmental Technologies, NY ELAP #11727.

SIENNA ENVIRONMENTAL TECHNOLOGIES, LLC

429 Franklin Street, Suite 102
Buffalo, NY 14202

Phone 716-332-3134
Fax 716-332-3136

Chain of Custody Document

Fax Report to: _____

Client/Contact: <u>C/S Engineers</u> <u>Jeffrey Robbins</u>		Turn around (circle) RUSH 48 Hour 24 Hour 72 Hour
Building/Location: <u>RAYMOND HALL</u>		
Job #: <u>SET954</u>	Total # Samples: <u>15</u>	

☒ PLM ☐ TEM ☐ AAS ☐ OTHER _____

Sample #	Description of Sample	Location of Sample	Notes P145
1209-RAY-100A-1	Dry wall	8th floor	1
1209-RAY-100A-2	Dry wall	7th floor	2
1209-RAY-100B-1	Joint compound	8th floor	3
1209-RAY-100B-2	Joint compound	7th floor	4
1209-RAY-100B-3	Joint compound	5th floor	5
1209-RAY-100B-4	Joint compound	4th floor	6
1209-RAY-100B-5	Joint compound	2nd floor	7
1209-RAY-101-1	Cinder block mortar	6th floor	8
1209-RAY-101-2	Cinder block mortar	5th floor	9
1209-RAY-200B-1	ceiling joint comp.	8th floor kitchen	10
1209-RAY-200B-2	ceiling joint comp.	1st floor	11
1209-RAY-201-1	1'x1' spline dot & fissure	6th floor	12
1209-RAY-201-2	1'x1' spline dot & fissure	6th floor	13
1209-RAY-202-1	2'x2' dot & Texture CT	6th floor	14
1209-RAY-202-2	2'x2' dot & Texture CT	6th floor	15

Notes:	Sienna Environmental Technologies ☒ Accept ☐ Reject
--------	---

Sampled By: Paul J. Main Date: 12/9/08
 Relinquished By: Paul J. Main Date: 12/10/08
 Received By: [Signature] Date: 12/12/08

P145



SIENNA ENVIRONMENTAL TECHNOLOGIES, LLC

429 Franklin St. • Suite 102 • Buffalo, NY 14202 • Ph: 716-332-3134 • Fax: 716-332-3136

LABORATORY REPORT

Attn: Jeffrey Robbins
C & S Engineers
499 Col. Eileen Collins Blvd
Syracuse, NY 13212
Phone: 315-455-2000 Fax: 315-455-9667
Project: SET954 SUNY Potsdam Morey Hall

Date Received: 12/12/2008
Date Analyzed: 12/18/2008
Sienna ID: P144

Polarized Light Microscopy (PLM) by NY State ELAP Method 198.1

Sample	Description	Location	% Fibrous	% Non-Fibrous	% Asbestos Type
1210-MOR-100A-1 P144-1	Tan, Non-Fibrous, Homogenous	Sand Finish Plaster Skim Coat - 2nd Floor Hall	0%	100%	NAD
1210-MOR-100A-2 P144-2	Tan, Non-Fibrous, Homogenous	Sand Finish Plaster Skim Coat - 2nd Floor Hall	0%	100%	NAD
1210-MOR-100A-3 P144-3	Tan, Non-Fibrous, Homogenous	Sand Finish Plaster Skim Coat - 1st Floor Hall	0%	100%	NAD
1210-MOR-200A-1 P144-4	Tan, Non-Fibrous, Homogenous	Sand Finish Plaster Skim Coat - Room 202	5%	95%	NAD
1210-MOR-200A-2 P144-5	Tan, Non-Fibrous, Homogenous	Sand Finish Plaster Skim Coat - Room 224	0%	100%	NAD
1210-MOR-100B-1 P144-6	Gray, Non-Fibrous, Homogenous	Sand Finish Plaster Base Coat - 2nd Floor Hall	0%	100%	NAD
1210-MOR-100B-2 P144-7	Gray, Non-Fibrous, Homogenous	Sand Finish Plaster Base Coat - 2nd Floor Hall	0%	100%	NAD
1210-MOR-100B-3 P144-8	Gray, Non-Fibrous, Homogenous	Sand Finish Plaster Base Coat - 1st Floor Hall	0%	100%	NAD
1210-MOR-200B-1 P144-9	Gray, Non-Fibrous, Homogenous	Sand Finish Plaster Base Coat - Room 202	0%	100%	NAD

Julia McKenzie, Tracy Skalski
Analyst(s)


Approved Signatory

Disclaimers: NAD = No asbestos detected. Results relate only to samples provided by client. This report shall not be reproduced, except in full, without written approval by Sienna. Samples analyzed as NAD or Trace (<1%) cannot be guaranteed. Quantitative transmission electron microscopy is currently the only reliable method that can be used to determine if this material can be considered or treated as non-asbestos containing. Analysis performed by Sienna Environmental Technologies, NY ELAP #11727.



SIENNA ENVIRONMENTAL TECHNOLOGIES, LLC

429 Franklin St. · Suite 102 · Buffalo, NY 14202 · Ph: 716-332-3134 · Fax: 716-332-3136

LABORATORY REPORT

Attn: Jeffrey Robbins
C & S Engineers
499 Col. Elleen Collins Blvd
Syracuse, NY 13212
Phone: 315-455-2000 Fax: 315-455-9667
Project: SET954 SUNY Potsdam Morey Hall

Date Received: 12/12/2008
Date Analyzed: 12/18/2008
Sienna ID: P144

Polarized Light Microscopy (PLM) by NY State ELAP Method 198.1

Sample	Description	Location	% Fibrous	% Non-Fibrous	% Asbestos Type
1210-MOR-200B-2 P144-10	Gray, Non-Fibrous, Homogenous	Sand Finish Plaster Base Coat - Room 224	0%	100%	NAD
1210-MOR-101A-1 P144-11	White, Non-Fibrous, Homogenous	Smooth Plaster Skim Coat - Room 202	0%	100%	NAD
1210-MOR-101A-2 P144-12	White, Non-Fibrous, Homogenous	Smooth Plaster Skim Coat - 1st Floor Mens Room	0%	100%	NAD
1210-MOR-202A-1 P144-13	White, Non-Fibrous, Homogenous	Smooth Plaster Skim Coat - 1st Floor Ladies Room	0%	100%	NAD
1210-MOR-101B-1 P144-14	Gray, Non-Fibrous, Homogenous	Smooth Plaster Base Coat - Room 202	5%	95%	NAD
1210-MOR-101B-2 P144-15	Gray, Non-Fibrous, Homogenous	Smooth Plaster Base Coat - 1st Floor Mens Room	0%	100%	NAD
1210-MOR-202B-1 P144-16	Gray, Non-Fibrous, Homogenous	Smooth Plaster Base Coat - 1st Floor Ladies Room	0%	100%	NAD
1210-MOR-102A-1 P144-17	White, Fibrous, Non-Homogenous	Drywall - Room 253	5%	95%	NAD
1210-MOR-201A-1 P144-18	Gray, Fibrous, Non-Homogenous	Drywall - Room 253	10%	90%	NAD

Julia McKenzie, Tracy Skalski
Analyst(s)

Approved Signatory

Disclaimers: NAD = No asbestos detected. Results relate only to samples provided by client. This report shall not be reproduced, except in full, without written approval by Sienna. Samples analyzed as NAD or Trace (<1%) cannot be guaranteed. Quantitative transmission electron microscopy is currently the only reliable method that can be used to determine if this material can be considered or treated as non-asbestos containing. Analysis performed by Sienna Environmental Technologies, NY ELAP #11727.



SIENNA ENVIRONMENTAL TECHNOLOGIES, LLC

429 Franklin St. • Suite 102 • Buffalo, NY 14202 • Ph: 716-332-3134 • Fax: 716-332-3136

LABORATORY REPORT

Attn: Jeffrey Robbins
C & S Engineers
499 Col. Eileen Collins Blvd
Syracuse, NY 13212
Phone: 315-455-2000 Fax: 315-455-9667
Project: SET954 SUNY Potsdam **Morey Hall**

Date Received: 12/12/2008
Date Analyzed: 12/18/2008
Sienna ID: P144

Polarized Light Microscopy (PLM) by NY State ELAP Method 198.1

Sample	Description	Location	% Fibrous	% Non-Fibrous	% Asbestos Type
1210-MOR-102B-1 P144-19	Tan, Non-Fibrous, Homogenous	Joint Compound - Room 253	0%	100%	NAD
1210-MOR-102B-2 P144-20	Tan, Non-Fibrous, Homogenous	Joint Compound - 1st Floor Hall	5%	95%	NAD
1210-MOR-201B-1 P144-21	Tan, Non-Fibrous, Homogenous	Joint Compound - Room 253	5%	95%	NAD
1210-MOR-201B-2 P144-22	Tan, Non-Fibrous, Homogenous	Joint Compound - Room 253	5%	95%	Trace Chrysotile

Julia McKenzie, Tracy Skalski
Analyst(s)


Approved Signatory

Disclaimers: NAD = No asbestos detected. Results relate only to samples provided by client. This report shall not be reproduced, except in full, without written approval by Sienna. Samples analyzed as NAD or Trace (<1%) cannot be guaranteed. Quantitative transmission electron microscopy is currently the only reliable method that can be used to determine if this material can be considered or treated as non-asbestos containing. Analysis performed by Sienna Environmental Technologies, NY ELAP #11727.

SIENNA ENVIRONMENTAL TECHNOLOGIES, LLC

429 Franklin Street, Suite 102
Buffalo, NY 14202

Phone 716-332-3134
Fax 716-332-3136

Chain of Custody Document

Fax Report to: _____

Client/Contact: <u>C&S Engineers / Jeffrey Robbins</u>	Turn around (circle) RUSH 48 Hour 24 Hour 72 Hour
Building/Location: <u>Morey Hall, SUNY Potsdam</u>	
Job #: <u>SET954</u> Total # Samples: <u>22</u>	

X PLM _____ TEM _____ AAS _____ OTHER _____

Sample #	Description of Sample	Location of Sample	Notes
1210-MOR-100A-1	Sand finish plaster skim coat	2nd floor hall	P144-1
1210-MOR-100A-2	Sand finish plaster skim coat	2nd floor hall	-2
1210-MOR-100A-3	Sand finish plaster skim coat	1st floor hall	-3
1210-MOR-200A-1	Sand finish plaster skim coat	Room 202	-4
1210-MOR-200A-2	Sand finish plaster skim coat	Room 224	-5
1210-MOR-100B-1	Sand finish plaster base coat	2nd floor hall	-6
1210-MOR-100B-2	Sand finish plaster base coat	2nd floor hall	-7
1210-MOR-100B-3	Sand finish plaster base coat	1st floor hall	-8
1210-MOR-200B-1	Sand finish plaster base coat	Room 202	-9
1210-MOR-200B-2	Sand finish plaster base coat	Room 224	-10
1210-MOR-101A-1	Smooth plaster skim coat	Room 202	-11
1210-MOR-101A-2	Smooth plaster skim coat	1st floor men's room	-12
1210-MOR-202A-1	Smooth plaster skim coat	1st floor ladie's room	-13
1210-MOR-101B-1	Smooth plaster base coat	Room 202	-14
1210-MOR-101B-2	Smooth plaster base coat	1st floor men's room	-15
1210-MOR-202B-1	Smooth plaster base coat	1st floor ladie's room	-16

Notes: Page 1 of 2

☒ Accept
☐ Reject

Sampled By: Paul J. May Date: 12/10/08
Relinquished By: Paul J. May Date: 12/10/08
Received By: Charles Stasi 1445 P144 Date: 12/12/08

429 Franklin Street, Suite 102
Buffalo, NY 14202

Phone 716-332-3134
Fax 716-332-3136

Fax Report to: _____

Client/Contact: <u>C & S Engineers / Jeffrey Robbins</u>	Turn around (circle)
Building/Location: <u>Morey Hall, SUNY Potsdam</u>	
Job #: <u>SET 954</u> Total # Samples: <u>28</u>	RUSH 48 Hour
	24 Hour 72 Hour

X	PLM	TEM	AAS	OTHER
--------------	-----	-----	-----	-------

[illegible]

Notes: Page 2 of 2

☒ Accept
☐ Reject

Sampled By: Paul Mauer Date: 12/10/08
Relinquished By: Paul Mauer Date: 12/10/08
Received By: Harry Stalder 1445 P44 Date: 12/12/08



SIENNA ENVIRONMENTAL TECHNOLOGIES, LLC

429 Franklin St. • Suite 102 • Buffalo, NY 14202 • Ph: 716-332-3134 • Fax: 716-332-3136

LABORATORY REPORT

Attn: Jeffrey Robbins
C & S Engineers
499 Col. Eileen Collins Blvd
Syracuse, NY 13212
Phone: 315-455-2000 Fax: 315-455-9667
Project: SET954 SUNY Potsdam Mac Vicar Hall

Date Received: 12/12/2008
Date Analyzed: 12/17/2008
Sienna ID: P143

Polarized Light Microscopy (PLM) by NY State ELAP Method 198.1

Sample	Description	Location	% Fibrous	% Non-Fibrous	% Asbestos Type
1210-MCV-100A-1 P143-1	Tan, Non-Fibrous, Homogenous	Sand Finish Plaster Skim Coat - 1st Floor Hall	0%	100%	NAD
1210-MCV-100A-2 P143-2	Tan, Non-Fibrous, Homogenous	Sand Finish Plaster Skim Coat - Room 120	0%	100%	NAD
1210-MCV-100A-3 P143-3	Tan, Non-Fibrous, Homogenous	Sand Finish Plaster Skim Coat - Room 203	0%	100%	NAD
1210-MCV-200A-1 P143-4	Tan, Non-Fibrous, Homogenous	Sand Finish Plaster Skim Coat - Room 121	5%	95%	NAD
1210-MCV-200A-2 P143-5	Tan, Non-Fibrous, Homogenous	Sand Finish Plaster Skim Coat - Room 226	5%	95%	NAD
1210-MCV-100B-1 P143-6	Gray, Non-Fibrous, Homogenous	Sand Finish Plaster Base Coat - 1st Floor Hall	0%	100%	NAD
1210-MCV-100B-2 P143-7	Gray, Non-Fibrous, Homogenous	Sand Finish Plaster Base Coat - Room 120	5%	95%	NAD
1210-MCV-100B-3 P143-8	Gray, Non-Fibrous, Homogenous	Sand Finish Plaster Base Coat - Room 203	0%	100%	NAD
1210-MCV-200B-1 P143-9	Gray, Non-Fibrous, Homogenous	Sand Finish Plaster Base Coat - Room 121	0%	100%	NAD
1210-MCV-200B-2 P143-10	Gray, Non-Fibrous, Homogenous	Sand Finish Plaster Base Coat - Room 226	0%	100%	NAD
1210-MCV-201A-1 P143-11	White, Non-Fibrous, Homogenous	Smooth Plaster Skim Coat - 2nd Floor Mens Room	0%	100%	NAD
1210-MCV-201A-2 P143-12	White, Non-Fibrous, Homogenous	Smooth Plaster Skim Coat - 2nd Floor Mens Room	0%	100%	NAD
1210-MCV-201A-3 P143-13	White, Non-Fibrous, Homogenous	Smooth Plaster Skim Coat - 1st Floor Mens Room	0%	100%	NAD

Tracy Skalski
Analyst(s)

Approved Signatory

Disclaimers: NAD = No asbestos detected. Results relate only to samples provided by client. This report shall not be reproduced, except in full, without written approval by Sienna. Samples analyzed as NAD or Trace (<1%) cannot be guaranteed. Quantitative transmission electron microscopy is currently the only reliable method that can be used to determine if this material can be considered or treated as non-asbestos containing. Analysis performed by Sienna Environmental Technologies, NY ELAP #11727.



SIENNA ENVIRONMENTAL TECHNOLOGIES, LLC

429 Franklin St. • Suite 102 • Buffalo, NY 14202 • Ph: 716-332-3134 • Fax: 716-332-3136

LABORATORY REPORT

Attn: Jeffrey Robbins
C & S Engineers
499 Col. Eileen Collins Blvd
Syracuse, NY 13212
Phone: 315-455-2000 Fax: 315-455-9667
Project: SET954 SUNY Potsdam Mac Vicar Hall

Date Received: 12/12/2008
Date Analyzed: 12/17/2008
Sienna ID: P143

Polarized Light Microscopy (PLM) by NY State ELAP Method 198.1

Sample	Description	Location	% Fibrous	% Non-Fibrous	% Asbestos Type
1210-MCV-201B-1 P143-14	Gray, Non-Fibrous, Homogenous	Smooth Plaster Base Coat - 2nd Floor Mens Room	0%	100%	NAD
1210-MCV-201B-2 P143-15	Gray, Non-Fibrous, Homogenous	Smooth Plaster Base Coat - 2nd Floor Mens Room	0%	100%	NAD
1210-MCV-201B-3 P143-16	Gray, Non-Fibrous, Homogenous	Smooth Plaster Base Coat - 1st Floor Mens Room	0%	100%	NAD

Tracy Skalski
Analyst(s)

Approved Signatory

Disclaimers: NAD = No asbestos detected. Results relate only to samples provided by client. This report shall not be reproduced, except in full, without written approval by Sienna. Samples analyzed as NAD or Trace (<1%) cannot be guaranteed. Quantitative transmission electron microscopy is currently the only reliable method that can be used to determine if this material can be considered or treated as non-asbestos containing. Analysis performed by Sienna Environmental Technologies, NY ELAP #11727.

SIENNA ENVIRONMENTAL TECHNOLOGIES, LLC

429 Franklin Street, Suite 102
Buffalo, NY 14202

Phone 716-332-3134
Fax 716-332-3136

Chain of Custody Document

Fax Report to: _____

Client/Contact: <u>C & S Engineers / Jeffrey Robbins</u>		Turn around (circle) RUSH 48 Hour 24 Hour 72 Hour
Building/Location: <u>Mac Vicar Hall, SUNY Potsdam</u>		
Job #: <u>SET954</u>	Total # Samples: <u>16</u>	

☒ PLM ☐ TEM ☐ AAS ☐ OTHER _____

Sample #	Description of Sample	Location of Sample	Notes
1210-MCV-100A-1	Sand finish plaster skim coat	1st floor hall	P143-1
1210-MCV-100A-2	Sand finish plaster skim coat	Room 120	-2
1210-MCV-100A-3	Sand finish plaster skim coat	Room 203	-3
1210-MCV-200A-1	Sand finish plaster skim coat	Room 121	-4
1210-MCV-200A-2	Sand finish plaster skim coat	Room 226	-5
1210-MCV-100B-1	Sand finish plaster base coat	1st floor hall	-6
1210-MCV-100B-2	Sand finish plaster base coat	Room 120	-7
1210-MCV-100B-3	Sand finish plaster base coat	Room 203	-8
1210-MCV-200B-1	Sand finish plaster base coat	Room 121	-9
1210-MCV-200B-2	Sand finish plaster base coat	Room 226	-10
1210-MCV-201A-1	Smooth plaster skim coat	2nd floor men's room	-11
1210-MCV-201A-2	Smooth plaster skim coat	2nd floor men's room	-12
1210-MCV-201A-3	Smooth plaster skim coat	1st floor men's room	-13
1210-MCV-201B-1	Smooth plaster base coat	2nd floor men's room	-14
1210-MCV-201B-2	Smooth plaster base coat	2nd floor men's room	-15
1210-MCV-201B-3	Smooth plaster base coat	1st floor men's room	P143-16

Notes: <u>Page 1 of 1</u>	Sienna Environmental Technologies ☒ Accept ☐ Reject
---------------------------	---

Sampled By: Paul J. Mair Date: 12/10/08
 Relinquished By: Paul J. Mair Date: 12/10/08
 Received By: Angela Storti 1445 P143 Date: 12/12/08



SIENNA ENVIRONMENTAL TECHNOLOGIES, LLC

429 Franklin St. · Suite 102 · Buffalo, NY 14202 · Ph: 716-332-3134 · Fax: 716-332-3136

LABORATORY REPORT

Attn: Jeffrey Robbins
C & S Engineers
499 Col. Eileen Collins Blvd
Syracuse, NY 13212

Phone: 315-455-2000

Fax: 315-455-9667

Project: SET954 Stillman Hall

Date Received: 12/12/2008


Date Analyzed: 12/22/2008

Sienna ID: P146

Polarized Light Microscopy (PLM) by NY State ELAP Method 198.1

Sample	Description	Location	% Fibrous	% Non-Fibrous	% Asbestos Type
1210-STL-100A-1 P146-1	Gray, Fibrous, Non-Homogenous	Drywall - Room 105	30%	70%	NAD
1210-STL-200A-1 P146-2	Gray, Fibrous, Non-Homogenous	Drywall - 1st Floor Hall	0%	100%	NAD
1210-STL-100B-1 P146-3	Tan, Fibrous, Homogenous	Joint Compound - Room 105	0%	100%	NAD
1210-STL-100B-2 P146-4	Tan, Non-Fibrous, Homogenous	Joint Compound - 1st Floor Hall	0%	100%	NAD
1210-STL-100B-3 P146-5	Tan, Non-Fibrous, Homogenous	Joint Compound - 2nd Floor Hall	0%	100%	NAD
1210-STL-200B-1 P146-6	Tan, Fibrous, Homogenous	Joint Compound - 1st Floor Hall	0%	100%	NAD
1210-STL-200B-2 P146-7	Tan, Fibrous, Homogenous	Joint Compound - 2nd Floor Hall	0%	100%	NAD
1210-STL-201-1 P146-8	Gray, Fibrous, Homogenous	2x2 Dot and Large Fissure Ceiling Tile - Room 105	70%	30%	NAD
1210-STL-201-2 P146-9	Gray, Fibrous, Homogenous	2x2 Dot and Large Fissure Ceiling Tile - Room 105	60%	40%	NAD

Tracy Skalski
Analyst(s)

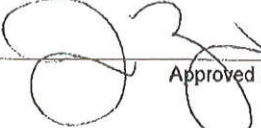
Approved Signatory

Disclaimers: NAD = No asbestos detected. Results relate only to samples provided by client. This report shall not be reproduced, except in full, without written approval by Sienna. Samples analyzed as NAD or Trace (<1%) cannot be guaranteed. Quantitative transmission electron microscopy is currently the only reliable method that can be used to determine if this material can be considered or treated as non-asbestos containing. Analysis performed by Sienna Environmental Technologies, NY ELAP #11727.

SIENNA ENVIRONMENTAL TECHNOLOGIES, LLC

429 Franklin Street, Suite 102
Buffalo, NY 14202

Phone 716-332-3134
Fax 716-332-3136

Chain of Custody Document

Fax Report to: _____

Client/Contact: <u>C & S Engineers, Jeffrey Robbins</u>		Turn around (circle) RUSH 48 Hour 24 Hour 72 Hour
Building/Location: <u>Stillman Hall, SUNY Potsdam</u>		
Job #: <u>SET954</u>	Total # Samples: <u>9</u>	

☒ PLM ☐ TEM ☐ AAS ☐ OTHER _____

Sample #	Description of Sample	Location of Sample	Notes P146
1210-STL-100A-1	Drywall	Room 105	1
1210-STL-200A-1	Drywall	1st floor hall	2
1210-STL-100B-1	Joint compound	Room 105	3
1210-STL-100B-2	Joint compound	1st floor hall	4
1210-STL-100B-3	Joint compound	2nd floor hall	5
1210-STL-200B-1	Joint compound	1st floor hall	6
1210-STL-200B-2	Joint compound	2nd floor hall	7
1210-STL-201-1	2x2 Dot and large fissure CT	Room 105	8
1210-STL-201-2	2x2 Dot and large fissure CT	Room 105	9

Sienna Environmental
Technologies

Notes: 1 of 1

☒ Accept
☐ Reject

Sampled By: Paul J. Maurer Date: 12/10/08
Relinquished By: Paul J. Maurer Date: 12/10/08
Received By: C. J. [Signature] Date: 12/12/08 P146



SIENNA ENVIRONMENTAL TECHNOLOGIES, LLC

429 Franklin St. • Suite 102 • Buffalo, NY 14202 • Ph: 716-332-3134 • Fax: 716-332-3136

LABORATORY REPORT

Attn: Jeffrey Robbins
C & S Engineers
499 Col. Eileen Collins Blvd
Syracuse, NY 13212

Date Received: 12/12/2008

Date Analyzed: 12/16/2008

Sienna ID: P141

Phone: 315-455-2000

Fax: 315-455-9667

Project: SET954 Flagg Hall

Polarized Light Microscopy (PLM) by NY State ELAP Method 198.1

Sample	Description	Location	% Fibrous	% Non-Fibrous	% Asbestos Type
1210-FLG-100-1 P141-1	Gray, Non-Fibrous, Homogenous	Cinder Block Mortar - Basement Hall	0%	100%	NAD
1210-FLG-100-2 P141-2	Gray, Non-Fibrous, Homogenous	Cinder Block Mortar - Basement Hall	0%	100%	NAD
1210-FLG-101A-1 P141-3	Gray, Non-Fibrous, Homogenous	Skim Coat Plaster - 1st Floor Hall	0%	100%	NAD
1210-FLG-101A-2 P141-4	Gray, Non-Fibrous, Homogenous	Skim Coat Plaster - Room 114	0%	100%	NAD
1210-FLG-101A-3 P141-5	Gray, Non-Fibrous, Homogenous	Skim Coat Plaster - Room 206	5%	95%	NAD
1210-FLG-101B-1 P141-6	Gray, Non-Fibrous, Homogenous	Base Coat Plaster - Room 114	0%	100%	NAD
1210-FLG-101B-2 P141-7	Gray, Non-Fibrous, Homogenous	Base Coat Plaster - 1st Floor Hall	0%	100%	NAD
1210-FLG-101B-3 P141-8	Gray, Non-Fibrous, Homogenous	Base Coat Plaster - Room 206A	0%	100%	NAD
1210-FLG-102A-1 P141-9	Gray, Non-Fibrous, Homogenous	Drywall - 1st Floor Hall	0%	100%	NAD
1210-FLG-102A-2 P141-10	Gray, Fibrous, Non- Homogenous	Drywall - 1st Floor Hall	10%	90%	NAD
1210-FLG-102B-1 P141-11	White, Non-Fibrous, Homogenous	Joint Compound - 1st Floor Hall	0%	100%	NAD
1210-FLG-102B-2 P141-12	White, Non-Fibrous, Homogenous	Joint Compound - 1st Floor Hall	0%	100%	NAD
1210-FLG-102B-3 P141-13	White, Non-Fibrous, Homogenous	Joint Compound - 1st Floor Hall	0%	100%	NAD

Julia McKenzie, Tracy Skalski
Analyst(s)

Approved Signatory

Disclaimers: NAD = No asbestos detected. Results relate only to samples provided by client. This report shall not be reproduced, except in full, without written approval by Sienna. Samples analyzed as NAD or Trace (<1%) cannot be guaranteed. Quantitative transmission electron microscopy is currently the only reliable method that can be used to determine if this material can be considered or treated as non-asbestos containing. Analysis performed by Sienna Environmental Technologies, NY ELAP #11727.



SIENNA ENVIRONMENTAL TECHNOLOGIES, LLC

429 Franklin St. • Suite 102 • Buffalo, NY 14202 • Ph: 716-332-3134 • Fax: 716-332-3136

LABORATORY REPORT

Attn: Jeffrey Robbins
C & S Engineers
499 Col. Eileen Collins Blvd
Syracuse, NY 13212

Date Received: 12/12/2008

Date Analyzed: 12/16/2008

Sienna ID: P141

Phone: 315-455-2000

Fax: 315-455-9667

Project: SET954 Flagg Hall

Polarized Light Microscopy (PLM) by NY State ELAP Method 198.1

Sample	Description	Location	% Fibrous	% Non-Fibrous	% Asbestos Type
1210-FLG-200-1 P141-14	Gray, Fibrous, Homogenous	2'x2' Dot and Texture Ceiling Tile - Room 164	30%	70%	NAD
1210-FLG-200-2 P141-15	Gray, Fibrous, Homogenous	2'x2' Dot and Texture Ceiling Tile - Room 164	40%	60%	NAD
1210-FLG-201A-1 P141-16	White, Non-Fibrous, Homogenous	Plaster Skim Coat - Room 114	5%	95%	NAD
1210-FLG-201A-2 P141-17	White, Non-Fibrous, Homogenous	Plaster Skim Coat - 2nd Floor Men's Room	0%	100%	NAD
1210-FLG-201B-1 P141-18	Gray, Non-Fibrous, Homogenous	Plaster Base Coat - Room 114	0%	100%	NAD
1210-FLG-201B-2 P141-19	Gray, Non-Fibrous, Homogenous	Plaster Base Coat - 2nd Floor Men's Room	0%	100%	NAD
1210-FLG-202-1 P141-20	White, Non-Fibrous, Homogenous	Textured Popcorn Ceiling - 1st Floor Entryway	0%	100%	NAD
1210-FLG-202-2 P141-21	Gray, Non-Fibrous, Homogenous	Popcorn Ceiling - 1st Floor Entryway	0%	100%	NAD
1210-FLG-202-3 P141-22	Gray, Non-Fibrous, Homogenous	Popcorn Ceiling - 1st Floor Entryway	10%	90%	NAD
1210-FLG-300-1 P141-23	Brown, Non-Fibrous, Homogenous	Brick Floor Mortar - 1st Floor Entryway	0%	100%	NAD
1210-FLG-300-2 P141-24	Brown, Non-Fibrous, Homogenous	Brick Floor Mortar - 1st Floor Entryway	0%	100%	NAD
1210-FLG-400A-1 P141-25	Yellow, Fibrous, Homogenous	Cloth on Mud Fitting - Basement	10%	90%	NAD
1210-FLG-400A-2 P141-26	Tan, Fibrous, Homogenous	Cloth on Mud Fitting - Basement	70%	30%	NAD

Julia McKenzie, Tracy Skalski
Analyst(s)

Approved Signatory

Disclaimers: NAD = No asbestos detected. Results relate only to samples provided by client. This report shall not be reproduced, except in full, without written approval by Sienna. Samples analyzed as NAD or Trace (<1%) cannot be guaranteed. Quantitative transmission electron microscopy is currently the only reliable method that can be used to determine if this material can be considered or treated as non-asbestos containing. Analysis performed by Sienna Environmental Technologies, NY ELAP #11727.



SIENNA ENVIRONMENTAL TECHNOLOGIES, LLC

429 Franklin St. · Suite 102 · Buffalo, NY 14202 · Ph: 716-332-3134 · Fax: 716-332-3136

LABORATORY REPORT

Attn: Jeffrey Robbins
C & S Engineers
499 Col. Eileen Collins Blvd
Syracuse, NY 13212

Date Received: 12/12/2008

Date Analyzed: 12/16/2008

Sienna ID: P141

Phone: 315-455-2000

Fax: 315-455-9667

Project: SET954 Flagg Hall

Polarized Light Microscopy (PLM) by NY State ELAP Method 198.1

Sample	Description	Location	% Fibrous	% Non-Fibrous	% Asbestos Type
1210-FLG-400A-3 P141-27	Yellow, Fibrous, Homogenous	Cloth on Mud Filting - Basement *Insufficient Sample Size*	10%	90%	NAD
1210-FLG-400B-1 P141-28	Gray, Fibrous, Homogenous	Mud Filting - Basement	10%	90%	NAD
1210-FLG-400B-2 P141-29	Gray, Fibrous, Homogenous	Mud Filting - Basement	15%	85%	NAD
1210-FLG-400B-3 P141-30	Gray, Fibrous, Homogenous	Mud Filting - Basement	20%	80%	NAD
1210-FLG-600-1 P141-31	Black, Fibrous, Homogenous	Vibration Dampener - Basement	30%	70%	NAD
1210-FLG-600-2 P141-32	Black, Fibrous, Homogenous	Vibration Dampener - Basement	15%	85%	NAD

Julia McKenzie, Tracy Skalski
Analyst(s)

Approved Signatory

Disclaimers: NAD = No asbestos detected. Results relate only to samples provided by client. This report shall not be reproduced, except in full, without written approval by Sienna. Samples analyzed as NAD or Trace (<1%) cannot be guaranteed. Quantitative transmission electron microscopy is currently the only reliable method that can be used to determine if this material can be considered or treated as non-asbestos containing. Analysis performed by Sienna Environmental Technologies, NY ELAP #11727.

SIENNA ENVIRONMENTAL TECHNOLOGIES, LLC

429 Franklin Street, Suite 102
Buffalo, NY 14202

Phone 716-332-3134
Fax 716-332-3136

Chain of Custody Document

Fax Report to: _____

Client/Contact: <u>CSS Engineers</u> <u>Jeffrey Robbins</u>		Turn around (circle) RUSH 48 Hour 24 Hour 72 Hour
Building/Location: <u>FLAGG HALL</u>		
Job #: <u>SET954</u>	Total # Samples: <u>32</u>	

☒ PLM ☐ TEM ☐ AAS ☐ OTHER _____

Sample #	Description of Sample	Location of Sample	Notes
1210-FLG-100-1	Cinder block mortar	Basement Hall	P141-1
1210-FLG-100-2	Cinder block mortar	Basement Hall	1-2
1210-FLG-101A-1	Skim coat plaster	1st Floor Hall	-3
1210-FLG-101A-2	Skim coat plaster	Rm 114	-4
1210-FLG-101A-3	Skim coat plaster	Rm 206	-5
1210-FLG-101B-1	Base coat plaster	Rm 114	-6
1210-FLG-101B-2	Base coat plaster	1st Floor Hall	-7
1210-FLG-101B-3	Base coat plaster	Rm 206 A	-8
1210-FLG-102A-1	Dry wall	1st Floor Hall	-9
1210-FLG-102A-2	Dry wall	1st Floor Hall	-10
1210-FLG-102B-1	Joint compound	1st Floor Hall	-11
1210-FLG-102B-2	Joint compound	1st Floor Hall	-12
1210-FLG-102B-3	Joint compound	1st Floor Hall	-13
1210-FLG-200-1	2'x2' Dot & Texture CT	Rm 1164	-14
1210-FLG-200-2	2'x2' Dot & Texture CT	Rm 1164	-15
1210-FLG-201A-1	Plaster skim coat	Rm 114	P141-16

Sienna Environmental
Technologies
☒ Accept
☐ Reject

Notes: PS 1 of 2

Sampled By: Paul J. Manig Date: 12/10/08
Relinquished By: Paul J. Manig Date: 12/10/08
Received By: Paul J. Manig Date: 12/12/08
P141
1445

SIENNA ENVIRONMENTAL TECHNOLOGIES, LLC

429 Franklin Street, Suite 102
Buffalo, NY 14202

Phone 716-332-3134
Fax 716-332-3136

Chain of Custody Document

Fax Report to: _____

Client/Contact: <u>C & S Engineers</u> <u>Jeffrey Robbins</u>	Turn around (circle) RUSH 48 Hour 24 Hour 72 Hour
Building/Location: <u>FLAGG HALL</u>	
Job #: <u>SET954</u> Total # Samples: <u>32</u>	

☒ PLM ☐ TEM ☐ AAS ☐ OTHER _____

Sample #	Description of Sample	Location of Sample	Notes
1210-FLG-201A-2	Plaster skim coat	2nd fl. men's Room	P141-17
1210-FLG-201B-1	Plaster base coat	Rm 114	-18
1210-FLG-201B-2	plaster base coat	2nd fl. men's room	-19
1210-FLG-202-1	Textured popcorn c/g	1st floor entryway	-20
1210-FLG-202-2	popcorn ceiling	1st floor entryway	-21
1210-FLG-202-3	popcorn ceiling	1st floor entryway	-22
1210-FLG-300-1	Brick floor mortar	1st floor entryway	-23
1210-FLG-300-2	Brick floor mortar	1st floor entryway	-24
1210-FLG-400A-1	cloth on mud fitting	Basement	-25
1210-FLG-400A-2	cloth on mud fitting	Basement	-26
1210-FLG-400A-3	cloth on mud fitting	Basement	-27
1210-FLG-400B-1	mud fitting	Basement	-28
1210-FLG-400B-2	mud fitting	Basement	-29
1210-FLG-400B-3	mud fitting	Basement	-30
1210-FLG-600-1	vibration dampener	Basement	-31
1210-FLG-600-2	vibration dampener	Basement	P141-32

Notes:

PS 2 of 2

Sienna Environmental Technologies

☒ Accept

☐ Reject

Sampled By: Paul J. Main Date: 12/10/08
Relinquished By: Paul J. Main Date: 12/10/08
Received By: James J. Steel Date: 12/12/08
P141
1445



SIENNA ENVIRONMENTAL TECHNOLOGIES, LLC

429 Franklin St. • Suite 102 • Buffalo, NY 14202 • Ph: 716-332-3134 • Fax: 716-332-3136

LABORATORY REPORT

Attn: Jeffrey Robbins
C & S Engineers
499 Col. Eileen Collins Blvd
Syracuse, NY 13212
Phone: 315-455-2000 Fax: 315-455-9867
Project: SET954 **Carson Hall**

Date Received: 12/12/2008
Date Analyzed: 12/14/2008
Sienna ID: P140

Polarized Light Microscopy (PLM) by NY State ELAP Method 198.1

Sample	Description	Location	% Fibrous	% Non-Fibrous	% Asbestos Type
1210-CAR-100A-1 P140-1	Gray, Fibrous, Non-Homogenous	Drywall - Rm 106	10%	90%	NAD
1210-CAR-100B-1 P140-2	White, Non-Fibrous, Homogenous	Joint Compound - Rm 106	0%	100%	NAD
1210-CAR-100B-2 P140-3	Tan, Non-Fibrous, Homogenous	Joint Compound - 2nd Floor Hall	0%	100%	NAD
1210-CAR-101-1 P140-4	Gray, Non-Fibrous, Homogenous	Cinder Block Mortar - Basement	0%	100%	NAD
1210-CAR-101-2 P140-5	Gray, Non-Fibrous, Homogenous	Cinder Block Mortar - Basement	0%	100%	NAD
1210-CAR-102A-1 P140-6	Tan, Non-Fibrous, Homogenous	Plaster Skim Coat - 3rd Floor	0%	100%	NAD
1210-CAR-102A-2 P140-7	Tan, Non-Fibrous, Homogenous	Plaster Skim Coat - 3rd Floor	0%	100%	NAD
1210-CAR-102A-3 P140-8	Tan, Non-Fibrous, Homogenous	Plaster Skim Coat - 3rd Floor	0%	100%	NAD
1210-CAR-102B-1 P140-9	Gray, Non-Fibrous, Homogenous	Plaster Base Coat - 3rd Floor	0%	100%	NAD
1210-CAR-102B-2 P140-10	Gray, Non-Fibrous, Homogenous	Plaster Base Coat - 3rd Floor	0%	100%	NAD
1210-CAR-102B-3 P140-11	Gray, Non-Fibrous, Homogenous	Plaster Base Coat - 3rd Floor	0%	100%	NAD
1210-CAR-200A-1 P140-12	Gray, Fibrous, Non-Homogenous	Ceiling Drywall - 1st Floor Hall	10%	90%	NAD
1210-CAR-200B-1 P140-13	White, Non-Fibrous, Homogenous	Ceiling Joint Compound - 1st Floor Hall	5%	95%	0.26% Chrysotile

Julia McKenzie
Analyst(s)


Approved Signatory

Disclaimers: NAD = No asbestos detected. Results relate only to samples provided by client. This report shall not be reproduced, except in full, without written approval by Sienna. Samples analyzed as NAD or Trace (<1%) cannot be guaranteed. Quantitative transmission electron microscopy is currently the only reliable method that can be used to determine if this material can be considered or treated as non-asbestos containing. Analysis performed by Sienna Environmental Technologies, NY ELAP #11727.



SIENNA ENVIRONMENTAL TECHNOLOGIES, LLC

429 Franklin St. • Suite 102 • Buffalo, NY 14202 • Ph: 716-332-3134 • Fax: 716-332-3136

LABORATORY REPORT

Attn: Jeffrey Robbins
C & S Engineers
499 Col. Elleen Collins Blvd
Syracuse, NY 13212
Phone: 315-455-2000 Fax: 315-455-9667
Project: SET954 Carson Hall

Date Received: 12/12/2008
Date Analyzed: 12/14/2008
Sienna ID: P140

Polarized Light Microscopy (PLM) by NY State ELAP Method 198.1

Sample	Description	Location	% Fibrous	% Non-Fibrous	% Asbestos Type
1210-CAR-201-1 P140-14	Gray, Fibrous, Homogenous	2x2 Large Fissure CT - Rm 106	70%	30%	NAD
1210-CAR-201-2 P140-15	Gray, Fibrous, Homogenous	2x2 Large Fissure CT - Rm 106	70%	30%	NAD
1210-CAR-202A-1 P140-16	Tan, Non-Fibrous, Homogenous	Text. Plaster Skim - Rm 106	5%	95%	2.8% Chrysotile
1210-CAR-202A-2 P140-17	Tan, Non-Fibrous, Homogenous	Text. Plaster Skim - 1st Floor Hall	5%	95%	3.1% Chrysotile
1210-CAR-202A-3 P140-18	Tan, Fibrous, Homogenous	Text. Plaster Skim - Rm 204	5%	95%	3.9% Chrysotile
1210-CAR-202B-1 P140-19	Tan, Non-Fibrous, Homogenous	Text. Plaster Base - Rm 106	0%	100%	NAD
1210-CAR-202B-2 P140-20	Tan, Non-Fibrous, Homogenous	Text. Plaster Base - 1st Fl Hall	0%	100%	NAD
1210-CAR-202B-3 P140-21	Tan, Non-Fibrous, Homogenous	Text. Plaster Base - Rm 204	0%	100%	NAD

Julia McKenzie
Analyst(s)

Approved Signatory

Disclaimers: NAD = No asbestos detected. Results relate only to samples provided by client. This report shall not be reproduced, except in full, without written approval by Sienna. Samples analyzed as NAD or Trace (<1%) cannot be guaranteed. Quantitative transmission electron microscopy is currently the only reliable method that can be used to determine if this material can be considered or treated as non-asbestos containing. Analysis performed by Sienna Environmental Technologies, NY ELAP #11727.

SIENNA ENVIRONMENTAL TECHNOLOGIES, LLC

429 Franklin Street, Suite 102
Buffalo, NY 14202

Phone 716-332-3134
Fax 716-332-3136

Chain of Custody Document

Fax Report to: _____

Client/Contact: <u>C/S Engineers</u> <u>Jeffrey Robbins</u>		Turn around (circle) RUSH 48 Hour 24 Hour 72 Hour
Building/Location: <u>CARSON HALL</u>		
Job #: <u>SET954</u>	Total # Samples: <u>21</u>	

☒ PLM ☐ TEM ☐ AAS ☐ OTHER _____

Sample #	Description of Sample	Location of Sample	Notes
1210-CAR-100A-1	Dry wall	Rm 106	P140-1
1210-CAR-100B-1	Joint compound	Rm 106	P140-2
1210-CAR-100B-2	Joint compound	2nd floor Hall	P140-3
1210-CAR-101-1	Cinder block mortar	Basement	P140-4
1210-CAR-101-2	Cinder block mortar	Basement	P140-5
1210-CAR-102A-1	Plaster skim coat	3rd floor	P140-6
1210-CAR-102A-2	Plaster skim coat	3rd floor	P140-7
1210-CAR-102A-3	Plaster skim coat	3rd floor	P140-8
1210-CAR-102B-1	Plaster base coat	3rd floor	P140-9
1210-CAR-102B-2	Plaster base coat	3rd floor	P140-10
1210-CAR-102B-3	Plaster base coat	3rd floor	P140-11
1210-CAR-200A-1	Ceiling Dry wall	1st floor Hall	P140-12
1210-CAR-200B-1	Ceiling joint comp.	1st floor Hall	P140-13
1210-CAR-201-1	2'x2' large fissure CT	Rm 106	P140-14
1210-CAR-201-2	2'x2' large fissure CT	Rm 106	P140-15
1210-CAR-202A-1	Text. plaster skim	Rm 106	P140-16

Sienna Environmental
Technologies

☒ Accept

☐ Reject

Notes:

Sampled By: Paul J. May

Date: 12/10/08

Relinquished By: Paul J. May

Date: 12/10/08

Received By: [Signature]

Date: 12/12/08 1415

P140

SIENNA ENVIRONMENTAL TECHNOLOGIES, LLC

429 Franklin Street, Suite 102
Buffalo, NY 14202

Phone 716-332-3134
Fax 716-332-3136

Chain of Custody Document

x Report to: _____

Client/Contact: <u>C/S Engineers</u> <u>Jeffrey Robbins</u>	Turn around (circle) RUSH 48 Hour 24 Hour 72 Hour
Building/Location: <u>CARSON HALL</u>	
Job #: <u>SET954</u> Total # Samples: <u>21</u>	

X PLM _____ TEM _____ AAS _____ OTHER _____

Sample #	Description of Sample	Location of Sample	Notes
1210-CAR-202A-2	Text. plaster skim	1st Floor Hall	P140-17
1210-CAR-202A-3	Text. plaster skim	Rm 204	P140-18
1210-CAR-202B-1	Text. plaster base	Rm 106	P140-19
1210-CAR-202B-2	Text. plaster base	Rm 106 1st fl. Hall	P140-20
1210-CAR-202B-3	Text. plaster base	Rm 204	P140-21
Sienna Environmental Technologies			
☒ Accept			
☐ Reject			

Notes:

PG 2 of 2

Sampled By: Paul J. Maritz Date: 12/10/08
 Relinquished By: Paul J. Maritz Date: 12/10/08
 Received By: [Signature] Date: 12/12/08

P140

1445



SIENNA ENVIRONMENTAL TECHNOLOGIES, LLC

429 Franklin St. • Suite 102 • Buffalo, NY 14202 • Ph: 716-332-3134 • Fax: 716-332-3136

LABORATORY REPORT

Attn: Jeffrey Robbins
C & S Engineers
499 Col. Eileen Collins Blvd
Syracuse, NY 13212

Phone: 315-455-2000

Fax: 315-455-9667

Project: SET954 Kellas Hall

Date Received: 12/12/2008

Date Analyzed: 12/17/2008

Sienna ID: P142

Polarized Light Microscopy (PLM) by NY State ELAP Method 198.1

Sample	Description	Location	% Fibrous	% Non-Fibrous	% Asbestos Type
1211-KEL-100-1 P142-1	Gray, Non-Fibrous, Homogenous	Cinder Block Mortar - Basement	0%	100%	NAD
1211-KEL-100-2 P142-2	Gray, Non-Fibrous, Homogenous	Cinder Block Mortar - Mezzanine	0%	100%	NAD
1211-KEL-101-1 P142-3	Brown, Non-Fibrous, Homogenous	Brick Mortar - Restroom Lower Level	0%	100%	NAD
1211-KEL-101-2 P142-4	Brown, Non-Fibrous, Homogenous	Brick Mortar - Restroom Lower Level	0%	100%	NAD
1211-KEL-102A-1 P142-5	White, Non-Fibrous, Homogenous	Plaster Skim Coat - 1st Floor Hall	0%	100%	NAD
1211-KEL-102A-2 P142-6	White, Non-Fibrous, Homogenous	Plaster Skim Coat - 1st Floor Hall	0%	100%	NAD
1211-KEL-102B-1 P142-7	Gray, Non-Fibrous, Homogenous	Plaster Base Coat - 1st Floor Hall	0%	100%	NAD
1211-KEL-102B-2 P142-8	Gray, Non-Fibrous, Homogenous	Plaster Base Coat - 1st Floor Hall	0%	100%	NAD
1211-KEL-103A-1 P142-9	Gray, Fibrous, Homogenous	Drywall - 1st Floor Foyer	5%	95%	NAD
1211-KEL-103A-2 P142-10	Gray, Non-Fibrous, Homogenous	Drywall - 1st Floor Foyer	10%	90%	NAD
1211-KEL-103B-1 P142-11	White, Non-Fibrous, Homogenous	Joint Compound - 1st Floor Foyer	0%	100%	NAD
1211-KEL-103B-2 P142-12	White, Non-Fibrous, Homogenous	Joint Compound - 1st Floor Foyer	0%	100%	NAD
1211-KEL-103B-3 P142-13	White, Non-Fibrous, Homogenous	Joint Compound - 1st Floor Foyer	0%	100%	NAD

Julia McKenzie, Tracy Skalski

Analyst(s)

Approved Signatory

Disclaimers: NAD = No asbestos detected. Results relate only to samples provided by client. This report shall not be reproduced, except in full, without written approval by Sienna. Samples analyzed as NAD or Trace (<1%) cannot be guaranteed. Quantitative transmission electron microscopy is currently the only reliable method that can be used to determine if this material can be considered or treated as non-asbestos containing. Analysis performed by Sienna Environmental Technologies, NY ELAP #11727.



SIENNA ENVIRONMENTAL TECHNOLOGIES, LLC

429 Franklin St. • Suite 102 • Buffalo, NY 14202 • Ph: 716-332-3134 • Fax: 716-332-3136

LABORATORY REPORT

Attn: Jeffrey Robbins
C & S Engineers
499 Col. Eileen Collins Blvd
Syracuse, NY 13212

Date Received: 12/12/2008

Date Analyzed: 12/17/2008

Sienna ID: P142

Phone: 315-455-2000

Fax: 315-455-9667

Project: SET954 **Kellas Hall**

Polarized Light Microscopy (PLM) by NY State ELAP Method 198.1

Sample	Description	Location	% Fibrous	% Non-Fibrous	% Asbestos Type
1211-KEL-200A-1 P142-14	Gray, Non-Fibrous, Homogenous	Plaster Skim Coat - Lower Level Ladies Room	0%	100%	NAD
1211-KEL-200B-1 P142-15	White, Non-Fibrous, Homogenous	Plaster Base Coat - Lower Level Ladies Room	0%	100%	NAD
1211-KEL-201-1 P142-16	Gray, Fibrous, Homogenous	Ceiling Tile 2'x4' - Archaeology Lab	30%	70%	NAD
1211-KEL-201-2 P142-17	Gray, Fibrous, Homogenous	Ceiling Tile 2'x4' - Archaeology Lab	30%	70%	NAD
1211-KEL-500-1 P142-18	Gray, Fibrous, Homogenous	Spray-On Insulation - 2nd Floor Near Stairs	70%	30%	NAD
1211-KEL-500-2 P142-19	Gray, Fibrous, Homogenous	Spray-On Insulation - 2nd Floor Near Stairs	65%	35%	NAD
1211-KEL-500-3 P142-20	Gray, Fibrous, Homogenous	Spray-On Insulation - 1st Floor Rear Corridor	60%	40%	NAD

Julia McKenzie, Tracy Skalski
Analyst(s)

Approved Signatory

Disclaimers: NAD = No asbestos detected. Results relate only to samples provided by client. This report shall not be reproduced, except in full, without written approval by Sienna. Samples analyzed as NAD or Trace (<1%) cannot be guaranteed. Quantitative transmission electron microscopy is currently the only reliable method that can be used to determine if this material can be considered or treated as non-asbestos containing. Analysis performed by Sienna Environmental Technologies, NY ELAP #11727.

SIENNA ENVIRONMENTAL TECHNOLOGIES, LLC

429 Franklin Street, Suite 102
Buffalo, NY 14202

Phone 716-332-3134
Fax 716-332-3136

Chain of Custody Document

ix Report to: _____

Client/Contact: <u>C's Engineers</u> <u>Jeffrey Robbins</u>	Turn around (circle) RUSH 48 Hour 24 Hour 72 Hour
Building/Location: <u>Kellas Hall</u>	
Job #: <u>SET954</u> Total # Samples: <u>20</u>	

X PLM _____ TEM _____ AAS _____ OTHER _____

Sample #	Description of Sample	Location of Sample	Notes <u>P142</u>
1216-KEL-100-1	Cinder Block Mortar	Basement	1
1216-KEL-100-2	Cinder block mortar	Mezzanine	2
1216-KEL-101-1	Brick Mortar	Restroom lower level	3
1216-KEL-101-2	Brick Mortar	Restroom lower level	4
1216-KEL-102A-1	Plaster skim coat	1st-floor hall	5
1211-KEL-102A-2	Plaster skim coat	1st-floor hall	6
1211-KEL-102B-1	Plaster base coat	1st-floor hall	7
1211-KEL-102B-2	Plaster base coat	1st-floor hall	8
1211-KEL-103A-1	Drywall	1st-floor foyer	9
1211-KEL-103A-2	Drywall	1st-floor foyer	10
1211-KEL-103B-1	Joint compound	1st-floor foyer	11
1211-KEL-103B-2	Joint compound	1st-floor foyer	12
1211-KEL-103B-3	Joint compound	1st-floor foyer	13
1211-KEL-200A-1	Plaster skim coat	lower level ladies Rm.	14
1211-KEL-200B-1	Plaster Base coat	lower level ladies Rm.	15
1211-KEL-201-1	Ceiling tile 2'x4'	Archaeology lab	16

Notes: Page 1 of 2

Sienna Environmental
Technologies

☒ Accept

☐ Reject

Sampled By: Paul J. Mawzy

Date: 12/11/08

Relinquished By: Paul J. Mawzy

Date: 12/11/08

Received By: [Signature]

Date: 12/12/08 P145

P142

SIENNA ENVIRONMENTAL TECHNOLOGIES, LLC

429 Franklin Street, Suite 102
Buffalo, NY 14202

Phone 716-332-3134
Fax 716-332-3136

Chain of Custody Document

x Report to: _____

Client/Contact: <u>C/S Engineers</u> <u>Jeffrey Robbins</u>	Turn around (circle) RUSH 48 Hour 24 Hour 72 Hour
Building/Location: <u>Kellash Hall</u>	
Job #: <u>SET954</u> Total # Samples: <u>20</u>	

☒ PLM ☐ TEM ☐ AAS OTHER _____

Sample #	Description of Sample	Location of Sample	Notes
1211-KEL-201-2	2'x4' ceiling tile	Archaeology lab	17
211-KEL-500-1	Spray-on insulation	2nd fl- near stairs	18
211-KEL-500-2	Spray-on insulation	2nd fl- near stairs	19
1211-KEL-500-3	Spray-on insulation	1st fl- rear corridor	20

Notes: <u>PS 2 of 2</u>	Sienna Environmental Technologies ☒ Accept ☐ Reject
-------------------------	--

Sampled By: Paul J. Maury Date: 12/11/08
 Relinquished By: Paul J. Maury Date: 12/11/08
 Received By: [Signature] Date: 12/12/08 PH2



SIENNA ENVIRONMENTAL TECHNOLOGIES, LLC

429 Franklin St. • Suite 102 • Buffalo, NY 14202 • Ph: 716-332-3134 • Fax: 716-332-3136

LABORATORY REPORT

Attn: Jeffrey Robbins
C & S Engineers
499 Col. Eileen Collins Blvd
Syracuse, NY 13212
Phone: 315-455-2000 Fax: 315-455-9667
Project: SET954 SUNY Potsdam Timmerman Hall

Date Received: 12/12/2008
Date Analyzed: 12/23/2008
Sienna ID: P147

Polarized Light Microscopy (PLM) by NY State ELAP Method 198.1

Sample	Description	Location	% Fibrous	% Non-Fibrous	% Asbestos Type
1211-TIM-100A-1 P147-1	Gray, Non-Fibrous, Homogenous	Plaster Skim Coat - 1st Floor Hall	0%	100%	NAD
1211-TIM-100A-2 P147-2	White, Non-Fibrous, Homogenous	Plaster Skim Coat - 2nd Floor Hall	0%	100%	NAD
1211-TIM-100A-3 P147-3	Tan, Non-Fibrous, Homogenous	Plaster Skim Coat - 2nd Floor Hall	0%	100%	NAD
1211-TIM-200A-1 P147-4	White, Non-Fibrous, Homogenous	Plaster Skim Coat - 1st Floor Hall	0%	100%	NAD
1211-TIM-200A-2 P147-5	White, Non-Fibrous, Homogenous	Plaster Skim Coat - 1st Floor Ladies Room	0%	100%	NAD
1211-TIM-100B-1 P147-6	White, Non-Fibrous, Homogenous	Plaster Base Coat - 1st Floor Hall	0%	100%	NAD
1211-TIM-100B-2 P147-7	Gray, Non-Fibrous, Homogenous	Plaster Base Coat - 2nd Floor Hall	0%	100%	NAD
1211-TIM-100B-3 P147-8	Gray, Non-Fibrous, Homogenous	Plaster Base Coat - 2nd Floor Hall	0%	100%	NAD
1211-TIM-200B-1 P147-9	Gray, Non-Fibrous, Homogenous	Plaster Base Coat - 1st Floor Hall	0%	100%	NAD
1211-TIM-200B-2 P147-10	Gray, Non-Fibrous, Homogenous	Plaster Base Coat - 1st Floor Ladies Room	0%	100%	NAD
1211-TIM-101-1 P147-11	Gray, Non-Fibrous, Homogenous	Cinder Block Mortar - 1st Floor Hall	0%	100%	NAD
1211-TIM-101-2 P147-12	Gray, Non-Fibrous, Homogenous	Cinder Block Mortar - 1st Floor Hall	0%	100%	NAD
1211-TIM-102A-1 P147-13	White, Non-Fibrous, Homogenous	Grout of 2x2 Ceramic Tile - 1st Floor Ladies Room	0%	100%	NAD

Julia McKenzie, Tracy Skalski
Analyst(s)

Approved Signatory

Disclaimers: NAD = No asbestos detected. Results relate only to samples provided by client. This report shall not be reproduced, except in full, without written approval by Sienna. Samples analyzed as NAD or Trace (<1%) cannot be guaranteed. Quantitative transmission electron microscopy is currently the only reliable method that can be used to determine if this material can be considered or treated as non-asbestos containing. Analysis performed by Sienna Environmental Technologies, NY ELAP #11727.



SIENNA ENVIRONMENTAL TECHNOLOGIES, LLC

429 Franklin St. • Suite 102 • Buffalo, NY 14202 • Ph: 716-332-3134 • Fax: 716-332-3136

LABORATORY REPORT


Attn: Jeffrey Robbins
C & S Engineers
499 Col. Eileen Collins Blvd
Syracuse, NY 13212
Phone: 315-455-2000 Fax: 315-455-9667
Project: SET954 SUNY Potsdam Timmerman Hall

Date Received: 12/12/2008
Date Analyzed: 12/23/2008
Sienna ID: P147

Polarized Light Microscopy (PLM) by NY State ELAP Method 198.1

Sample	Description	Location	% Fibrous	% Non-Fibrous	% Asbestos Type
1211-TIM-102A-2 P147-14	White, Non-Fibrous, Homogenous	Grout of 2x2 Ceramic Tile - 1st Floor Ladies Room	0%	100%	NAD
1211-TIM-102B-1 P147-15	Gray, Non-Fibrous, Homogenous	Mortar of 2x2 Ceramic Tile - 1st Floor Ladies Room	0%	100%	NAD
1211-TIM-102B-2 P147-16	Gray, Non-Fibrous, Homogenous	Mortar of 2x2 Ceramic Tile - 1st Floor Ladies Room	0%	100%	NAD

Julia McKenzie, Tracy Skalski
Analyst(s)

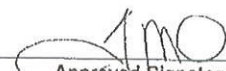
Approved Signatory

Disclaimer: NAD = No asbestos detected. Results relate only to samples provided by client. This report shall not be reproduced, except in full, without written approval by Sienna. Samples analyzed as NAD or Trace (<1%) cannot be guaranteed. Quantitative transmission electron microscopy is currently the only reliable method that can be used to determine if this material can be considered or treated as non-asbestos containing. Analysis performed by Sienna Environmental Technologies, NY ELAP #11727.

SIENNA ENVIRONMENTAL TECHNOLOGIES, LLC429 Franklin Street, Suite 102
Buffalo, NY 14202Phone 716-332-3134
Fax 716-332-3136**Chain of Custody
Document**

1x Report to: _____

Client/Contact: <u>C&S Engineers / Jeffrey Robbins</u>		Turn around (circle) RUSH 48 Hour 24 Hour 72 Hour
Building/Location: <u>Timmerman Hall, SUNY Potsdam</u>		
Job #: <u>SET954</u> Total # Samples: <u>16</u>		

☒ PLM ☐ TEM ☐ AAS ☐ OTHER _____

Sample #	Description of Sample	Location of Sample	Notes
1211-TIM-100A-1	Plaster skim coat	1st floor hall	P147-1
1211-TIM-100A-2	Plaster skim coat	2nd floor hall	-2
1211-TIM-100A-3	Plaster skim coat	2nd floor hall	-3
1211-TIM-200A-1	Plaster skim coat	1st floor hall	-4
1211-TIM-200A-2	Plaster skim coat	1st floor ladies room	-5
1211-TIM-100B-1	Plaster base coat	1st floor hall	-6
1211-TIM-100B-2	Plaster base coat	2nd floor hall	-7
1211-TIM-100B-3	Plaster base coat	2nd floor hall	-8
1211-TIM-200B-1	Plaster base coat	1st floor hall	-9
1211-TIM-200B-2	Plaster base coat	1st floor ladies room	-10
1211-TIM-101-1	Cinder block mortar	1st floor hall	-11
1211-TIM-101-2	Cinder block mortar	1st floor hall	-12
1211-TIM-102A-1	Grout of 2x2 ceramic tile	1st floor ladies room	-13
1211-TIM-102A-2	Grout of 2x2 ceramic tile	1st floor ladies room	-14
1211-TIM-102B-1	Mortar of 2x2 ceramic tile	1st floor ladies room	-15
1211-TIM-102B-2	Mortar of 2x2 ceramic tile	1st floor ladies room	P147-16

Notes: Page 1 of 1

Sampled By: Paul J. Maier Date: 12/11/08
 Relinquished By: Paul J. Maier Date: 12/11/08
 Received By: Frank Stalski 1445 P147 Date: 12/12/08

**AmeriSci New York**117 EAST 30TH ST.
NEW YORK, NY 10016

TEL: (212) 679-8600 • FAX: (212) 679-3114

PLM Bulk Asbestos ReportSienna Environmental Technologies, LL
Attn: Suzanne Kelley
429 Franklin Street Suite 102

Buffalo, NY 14202Date Received 12/30/08 AmeriSci Job # 208123750
Date Examined 12/30/08 P.O. #
ELAP # 11480 Page 1 of 5
RE: SET 954; C&S Engineer, SUNY Potsdam; Stowell Hall, SUNY
Potsdam

Client No. / HGA	Lab No.	Asbestos Present	Total % Asbestos
1211-STO-100-1 Location: Cinder Block Mortar / Equipment Room Analyst Description: Grey, Homogeneous, Non-Fibrous, Cementitious, Bulk Material Asbestos Types: Other Material: Non-fibrous 100 %	208123750-01	No	NAD (by NYS ELAP 198.1) by Albert Grohmann on 12/30/08
1211-STO-100-2 Location: Cinder Block Mortar / Room 117 Analyst Description: Grey, Homogeneous, Non-Fibrous, Cementitious, Bulk Material Asbestos Types: Other Material: Non-fibrous 100 %	208123750-02	No	NAD (by NYS ELAP 198.1) by Albert Grohmann on 12/30/08
1211-STO-101-1 Location: Glazed Block Mortar / Room 123A Analyst Description: Grey, Homogeneous, Non-Fibrous, Cementitious, Bulk Material Asbestos Types: Other Material: Non-fibrous 100 %	208123750-03	No	NAD (by NYS ELAP 198.1) by Albert Grohmann on 12/30/08
1211-STO-101-2 Location: Glazed Block Mortar / 2nd Floor Hall Analyst Description: Grey, Homogeneous, Non-Fibrous, Cementitious, Bulk Material Asbestos Types: Other Material: Non-fibrous 100 %	208123750-04	No	NAD (by NYS ELAP 198.1) by Albert Grohmann on 12/30/08
1211-STO-102-1 Location: Cementitious Panel / Room 118 Analyst Description: Grey, Homogeneous, Non-Fibrous, Cementitious, Bulk Material Asbestos Types: Chrysotile 16.7 % Other Material: Non-fibrous 83.3 %	208123750-05	Yes	16.7 % (by NYS ELAP 198.1) by Albert Grohmann on 12/30/08

See Reporting notes on last page

Received Time Dec. 30. 2008 3:36PM No. 2632

PLM Bulk Asbestos ReportSET 954; C&S Engineer, SUNY Potsdam; Stowell Hall, SUNY
Potsdam

Client No. / HGA	Lab No.	Asbestos Present	Total % Asbestos
1211-STO-102-2 Location: Cementitious Panel / Room 116 Analyst Description: Grey, Homogeneous, Non-Fibrous, Cementitious, Bulk Material Asbestos Types: Chrysotile 17.4 % Other Material: Non-fibrous 82.6 %	208123750-06	Yes	17.4 % (by NYS ELAP 198.1) by Albert Grohmann on 12/30/08
1211-STO-103A-1 Location: Plaster Skim Coat / Room 132 Analyst Description: White, Homogeneous, Non-Fibrous, Bulk Material Asbestos Types: Other Material: Non-fibrous 100 %	208123750-07	No	NAD (by NYS ELAP 198.1) by Albert Grohmann on 12/30/08
1211-STO-103A-2 Location: Plaster Skim Coat / Room 222 Analyst Description: White, Homogeneous, Non-Fibrous, Bulk Material Asbestos Types: Other Material: Non-fibrous 100 %	208123750-08	No	NAD (by NYS ELAP 198.1) by Albert Grohmann on 12/30/08
1211-STO-103A-3 Location: Plaster Skim Coat / Room 312A Analyst Description: White, Homogeneous, Non-Fibrous, Bulk Material Asbestos Types: Other Material: Non-fibrous 100 %	208123750-09	No	NAD (by NYS ELAP 198.1) by Albert Grohmann on 12/30/08
1211-STO-202A-1 Location: Plaster Skim Coat / 1st Floor Mens Room Analyst Description: White, Homogeneous, Non-Fibrous, Bulk Material Asbestos Types: Other Material: Non-fibrous 100 %	208123750-10	No	NAD (by NYS ELAP 198.1) by Albert Grohmann on 12/30/08
1211-STO-202A-2 Location: Plaster Skim Coat / 2nd Floor Ladies Room Analyst Description: White, Homogeneous, Non-Fibrous, Bulk Material Asbestos Types: Other Material: Non-fibrous 100 %	208123750-11	No	NAD (by NYS ELAP 198.1) by Albert Grohmann on 12/30/08

See Reporting notes on last page

Received Time Dec. 30. 2008 3:36PM No. 2632

PLM Bulk Asbestos ReportSET 954; C&S Engineer, SUNY Potsdam; **Stowell Hall**, SUNY
Potsdam

Client No. / HGA	Lab No.	Asbestos Present	Total % Asbestos
1211-STO-103B-1 Location: Plaster Base Coat / Room 132	208123750-12	No	NAD (by NYS ELAP 198.1) by Albert Grohmann on 12/30/08
Analyst Description: Grey, Homogeneous, Non-Fibrous, Cementitious, Bulk Material Asbestos Types: Other Material: Cellulose Trace, Non-fibrous 100 %			
1211-STO-103B-2 Location: Plaster Base Coat / Room 222	208123750-13	No	NAD (by NYS ELAP 198.1) by Albert Grohmann on 12/30/08
Analyst Description: Grey, Homogeneous, Non-Fibrous, Cementitious, Bulk Material Asbestos Types: Other Material: Cellulose Trace, Non-fibrous 100 %			
1211-STO-103B-3 Location: Plaster Base Coat / Room 312A	208123750-14	No	NAD (by NYS ELAP 198.1) by Albert Grohmann on 12/30/08
Analyst Description: Grey, Homogeneous, Non-Fibrous, Cementitious, Bulk Material Asbestos Types: Other Material: Cellulose Trace, Non-fibrous 100 %			
1211-STO-202B-1 Location: Plaster Base Coat / 1st Floor Men's Room	208123750-15	No	NAD (by NYS ELAP 198.1) by Albert Grohmann on 12/30/08
Analyst Description: Grey, Homogeneous, Non-Fibrous, Cementitious, Bulk Material Asbestos Types: Other Material: Cellulose Trace, Non-fibrous 100 %			
1211-STO-202B-2 Location: Plaster Base Coat / 2nd Floor Ladies Room	208123750-16	No	NAD (by NYS ELAP 198.1) by Albert Grohmann on 12/30/08
Analyst Description: Grey, Homogeneous, Non-Fibrous, Cementitious, Bulk Material Asbestos Types: Other Material: Cellulose Trace, Non-fibrous 100 %			
1211-STO-104-1 Location: Mortar Of White Brick / 1st Floor Hall	208123750-17	No	NAD (by NYS ELAP 198.1) by Albert Grohmann on 12/30/08
Analyst Description: Grey, Homogeneous, Non-Fibrous, Cementitious, Bulk Material Asbestos Types: Other Material: Non-fibrous 100 %			

See Reporting notes on last page

Received Time Dec. 30, 2008 3:36PM No. 2632

PLM Bulk Asbestos ReportSET 954; C&S Engineer, SUNY Potsdam; Stowell Hall, SUNY
Potsdam

Client No. / HGA	Lab No.	Asbestos Present	Total % Asbestos
1211-STO-104-2	208123750-18	No	NAD
Location: Mortar Of White Brick / 1st Floor Hall			(by NYS ELAP 198.1) by Albert Grohmann on 12/30/08
Analyst Description: Grey, Homogeneous, Non-Fibrous, Cementitious, Bulk Material			
Asbestos Types:			
Other Material: Non-fibrous 100 %			
1211-STO-200-1	208123750-19	No	NAD
Location: 2x4 Dot + Fissure Ceiling Tile / Basement Hall			(by NYS ELAP 198.1) by Albert Grohmann on 12/30/08
Analyst Description: White/Grey, Homogeneous, Fibrous, Bulk Material			
Asbestos Types:			
Other Material: Cellulose 45 %, Fibrous glass 40 %, Non-fibrous 15 %			
1211-STO-200-2	208123750-20	No	NAD
Location: 2x4 Dot + Fissure Ceiling Tile / Basement Hall			(by NYS ELAP 198.1) by Albert Grohmann on 12/30/08
Analyst Description: White/Grey, Homogeneous, Fibrous, Bulk Material			
Asbestos Types:			
Other Material: Cellulose 45 %, Fibrous glass 40 %, Non-fibrous 15 %			
1211-STO-201-1	208123750-21	No	NAD
Location: 2x4 Dot Ceiling Tile / 1st Floor Hall			(by NYS ELAP 198.1) by Albert Grohmann on 12/30/08
Analyst Description: OffWhite, Homogeneous, Fibrous, Bulk Material			
Asbestos Types:			
Other Material: Cellulose 50 %, Fibrous glass 35 %, Non-fibrous 15 %			
1211-STO-201-2	208123750-22	No	NAD
Location: 2x4 Dot Ceiling Tile / 1st Floor Hall			(by NYS ELAP 198.1) by Albert Grohmann on 12/30/08
Analyst Description: OffWhite, Homogeneous, Fibrous, Bulk Material			
Asbestos Types:			
Other Material: Cellulose 50 %, Fibrous glass 35 %, Non-fibrous 15 %			


See Reporting notes on last page

Received Time Dec. 30, 2008 3:36PM No. 2632

PLM Bulk Asbestos Report

SET 954; C&S Engineer, SUNY Potsdam; Stowell Hall, SUNY
Potsdam

Reporting Notes:

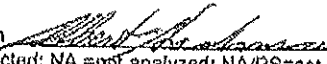Analyzed by: Albert Grohmann 

*NAD/NSD = no asbestos detected; NA = not analyzed; NA/PS = not analyzed/positive stop; PLM Bulk Asbestos Analysis by EPA 600/M4-82-020 per 40 CFR 763 (NVLAP Lab Code 200648-0), ELAP PLM Method 198.1 for NY friable samples or 198.6 for NOB samples (NY ELAP Lab ID 11480); Note: PLM is not consistently reliable in detecting asbestos in floor coverings and similar non-friable organically bound materials. NAD or Trace results by PLM are inconclusive. TEM is currently the only method that can be used to determine if this material can be considered or treated as non asbestos-containing in NY State (also see EPA Advisory for floor tile, FR 59, 146, 38970, 8/1/94), National Institute of Standards and Technology Accreditation requirements mandate that this report must not be reproduced except in full without the approval of the lab. This PLM report relates ONLY to the items tested. AIHA Lab # 102843.

Reviewed By: _____

_____ END OF REPORT _____

Received Time Dec. 30. 2008 3:36PM No. 2632

SIENNA ENVIRONMENTAL TECHNOLOGIES, LLC

429 Franklin Street, Suite 102
Buffalo, NY 14202

Phone 716-332-3134
Fax 716-332-3136

Chain of Custody Document

x Report to: _____

Client/Contact: <u>C & S Engineer, SUNY Potsdam</u> <u>Jeffrey Robbins</u>		Turn around (circle) RUSH 48 Hour <u>24 Hour</u> 72 Hour
Building/Location: <u>Stowell Hall, SUNY Potsdam</u>		
Job #: <u>SET954</u>	Total # Samples: <u>22</u>	<u>208128750</u>

X PLM _____ TEM _____ AAS _____ OTHER _____

Sample #	Description of Sample	Location of Sample	Notes
1211-STO-100-1	Cinder block mortar	Equipment Room	-1
1211-STO-100-2	Cinder block mortar	Room 117	-2
1211-STO-101-1	Glazed block mortar	Room 123A	-3
1211-STO-101-2	Glazed block mortar	2nd floor hall	-4
1211-STO-102-1	Cementitious panel	Room 116	-5
1211-STO-102-2	Cementitious panel	Room 116	-6
1211-STO-103A-1	Plaster skim coat	Room 132	-7
1211-STO-103A-2	Plaster skim coat	Room 222	-8
1211-STO-103A-3	Plaster skim coat	Room 312A	-9
1211-STO-202A-1	Plaster skim coat	1st floor men's room	-10
1211-STO-202A-2	Plaster skim coat	2nd floor ladies room	-11
1211-STO-103B-1	Plaster base coat	Room 132	-12
1211-STO-103B-2	Plaster base coat	Room 222	-13
1211-STO-103B-3	Plaster base coat	Room 312A	-14
1211-STO-202B-1	Plaster base coat	1st floor men's room	-15
1211-STO-202B-2	Plaster base coat	2nd floor ladies room	-16

Notes:

Page 1 of 2

Sienna Environmental
Technologies

☒ Accept

☐ Reject

sampled By: [Signature]

Date: 12/11/08

Relinquished By: [Signature]

Date: _____

Received By: Rose Rodriguez

Date: 12/30/08

Received Time Dec. 30, 2008 3:36PM No. 2632

429 Franklin Street, Suite 102
Buffalo, NY 14202

Fax 716-332-3136

Chain of Custody Document

x Report to:

X PLM TEM AAS OTHER

Sample #	Description of Sample	Location of Sample	Notes
1211-STO-104-1	Mortar of white brick	1st floor hall	-17
1211-STO-104-2	Mortar of white brick	1st floor hall	-18
1211-STO-200-1	2x4 dot + fissure ceiling tile	Basement hall	-19
1211-STO-200-2	2x4 dot + fissure ceiling tile	Basement hall	-20
1211-STO-201-1	2x4 dot ceiling tile	1st floor hall	-21
1211-STO-201-2	2x4 dot ceiling tile	1st floor hall	-22

Slenna Environmental
Technologies
☒ Accept
☐ Reject

Notes: Page 2 of 2

sampled By:

Date: 12/11/08

Relinquished By:

Date:

Received P

Date:

Received Time: Dec. 30, 2008 3:36PM No. 2632



SIENNA ENVIRONMENTAL TECHNOLOGIES, LLC

429 Franklin St. • Suite 102 • Buffalo, NY 14202 • Ph: 716-332-3134 • Fax: 716-332-3136

LABORATORY REPORT

Attn: Jeffrey Robbins
C & S Engineers
499 Col. Eileen Collins Blvd
Syracuse, NY 13212
Phone: 315-455-2000 Fax: 315-455-9667
Project: SET954 Crumb Library

Date Received: 12/16/2008
Date Analyzed: 12/28/2008
Sienna ID: P152

Polarized Light Microscopy (PLM) by NY State ELAP Method 198.1

Sample	Description	Location	% Fibrous	% Non-Fibrous	% Asbestos Type
1211-CRU-100A-1 P152-1	White, Non-Fibrous, Homogenous	Skim Coat Plaster - 2nd Floor Library	0%	100%	NAD
1211-CRU-100A-2 P152-2	White, Non-Fibrous, Non-Homogenous	Skim Coat Plaster - 2nd Floor Library	0%	100%	NAD
1211-CRU-100A-3 P152-3	White, Non-Fibrous, Homogenous	Skim Coat Plaster - 2nd Floor Library	0%	100%	NAD
1211-CRU-100B-1 P152-4	Gray, Non-Fibrous, Homogenous	Base Coat Plaster - 2nd Floor Library	5%	95%	NAD
1211-CRU-100B-2 P152-5	Gray, Non-Fibrous, Homogenous	Base Coat Plaster - 2nd Floor Library	0%	100%	NAD
1211-CRU-100B-3 P152-6	Gray, Non-Fibrous, Homogenous	Base Coat Plaster - 2nd Floor Library	0%	100%	NAD
1211-CRU-101-1 P152-7	Gray, Non-Fibrous, Homogenous	Cinder Block Mortar - Basement	0%	100%	NAD
1211-CRU-101-2 P152-8	Gray, Non-Fibrous, Homogenous	Cinder Block Mortar - Basement	0%	100%	NAD
1211-CRU-102-1 P152-9	Gray, Non-Fibrous, Homogenous	Brick Mortar - 1st Floor	5%	95%	NAD
1211-CRU-102-2 P152-10	Gray, Non-Fibrous, Homogenous	Brick Mortar - 1st Floor	0%	100%	NAD
1211-CRU-200-1 P152-11	Gray, Fibrous, Homogenous	1'x1' Dot and Fissure Ceiling Tile - 2nd Floor Library	20%	80%	NAD
1211-CRU-200-2 P152-12	Gray, Fibrous, Homogenous	1'x1' Dot and Fissure Ceiling Tile - 2nd Floor Library	20%	80%	NAD
1211-CRU-201-1 P152-13	Gray, Fibrous, Homogenous	2'x2' Dot and Texture Ceiling Tile - 1st Floor	30%	70%	NAD

Tracy Skalski
Analyst(s)

Approved Signatory

Disclaimers: NAD = No asbestos detected. Results relate only to samples provided by client. This report shall not be reproduced, except in full, without written approval by Sienna. Samples analyzed as NAD or Trace (<1%) cannot be guaranteed. Quantitative transmission electron microscopy is currently the only reliable method that can be used to determine if this material can be considered or treated as non-asbestos containing. Analysis performed by Sienna Environmental Technologies, NY ELAP #11727.

SIENNA ENVIRONMENTAL TECHNOLOGIES, LLC

429 Franklin Street, Suite 102
Buffalo, NY 14202

Phone 716-332-3134
Fax 716-332-3136

Chain of Custody Document

Test Report to: _____

Client/Contact: <u>C/S Engineers - Jeffrey Robbins</u>	Turn around (circle) RUSH 48 Hour 24 Hour 72 Hour
Building/Location: <u>CRUMB LIBRARY</u>	
Job #: <u>SET 954</u> Total # Samples: <u>14</u>	

☒ PLM ☐ TEM ☐ AAS OTHER _____

Sample #	Description of Sample	Location of Sample	Notes
121-CRU-100A-1	Skim coat plaster	2nd fl. library	P152-1
121-CRU-100A-2	Skim coat plaster	2nd fl. library	-2
121-CRU-100A-3	Skim coat plaster	2nd fl. library	-3
121-CRU-100B-1	Base coat plaster	2nd fl. library	-4
121-CRU-100B-2	Base coat plaster	2nd fl. library	-5
121-CRU-100B-3	Base coat plaster	2nd fl. library	-6
121-CRU-101-1	Cinder block mortar	Basement	-7
121-CRU-101-2	Cinder block mortar	Basement	-8
121-CRU-102-1	Brick mortar	1st floor	-9
121-CRU-102-2	Brick mortar	1st floor	-10
121-CRU-200-1	1x1 dot & fissure CT	2nd floor library	-11
121-CRU-200-2	1x1 dot & fissure CT	2nd floor library	-12
121-CRU-201-1	2x2 dot & texture CT	1st floor	-13
121-CRU-201-2	2x2 dot & texture CT	1st floor	P152-14
Sienna Environmental Technologies			

Notes:

☒ Accept
☐ Reject

Sampled By: Paul J. Main Date: 12/11/08
Relinquished By: Paul J. Main Date: _____
Received By: G. Stalsci 1500 P152 Date: 12/18/08



SIENNA ENVIRONMENTAL TECHNOLOGIES, LLC

429 Franklin St. • Suite 102 • Buffalo, NY 14202 • Ph: 716-332-3134 • Fax: 716-332-3136

LABORATORY REPORT

Attn: Jeffrey Robbins
C & S Engineers
499 Col. Elleen Collins Blvd
Syracuse, NY 13212

Date Received: 12/18/2008

Date Analyzed: 12/31/2008

Sienna ID: P159

Phone: 315-455-2000

Fax: 315-455-9667

Project: SET954 Satterlee Hall

Polarized Light Microscopy (PLM) by NY State ELAP Method 198.1

Sample	Description	Location	% Fibrous	% Non-Fibrous	% Asbestos Type
1212-SAT-100A-1 P159-1	White, Non-Fibrous, Homogenous	Skim Coat Plaster - Auditorium	0%	100%	NAD
1212-SAT-100A-2 P159-2	White, Non-Fibrous, Homogenous	Skim Coat Plaster - 1st Floor Mens Room	0%	100%	NAD
1212-SAT-100A-3 P159-3	White, Non-Fibrous, Homogenous	Skim Coat Plaster - 2nd Floor Ladies Room	0%	100%	NAD
1212-SAT-100A-4 P159-4	White, Non-Fibrous, Homogenous	Skim Coat Plaster - Room 223	0%	100%	NAD
1212-SAT-100A-5 P159-5	White, Non-Fibrous, Homogenous	Skim Coat Plaster - 3rd Floor Mens Room	0%	100%	NAD
1212-SAT-100B-1 P159-6	Gray, Non-Fibrous, Homogenous	Base Coat Plaster - Auditorium	0%	100%	NAD
1212-SAT-100B-2 P159-7	Gray, Non-Fibrous, Homogenous	Base Coat Plaster - 1st Floor Mens Room	0%	100%	NAD
1212-SAT-100B-3 P159-8	Gray, Non-Fibrous, Homogenous	Base Coat Plaster - 2nd Floor Ladies Room	0%	100%	NAD
1212-SAT-100B-4 P159-9	Gray, Non-Fibrous, Homogenous	Base Coat Plaster - Room 223	0%	100%	NAD
1212-SAT-100B-5 P159-10	Gray, Non-Fibrous, Homogenous	Base Coat Plaster - 3rd Floor Mens Room	0%	100%	NAD
1212-SAT-101A-1 P159-11	Gray, Non-Fibrous, Homogenous	Skim Coat Sand Plaster - 1st Floor Hall	0%	100%	NAD
1212-SAT-101A-2 P159-12	Gray, Non-Fibrous, Homogenous	Skim Coat Sand Plaster - Room 113	0%	100%	NAD
1212-SAT-101A-3 P159-13	Gray, Non-Fibrous, Homogenous	Skim Coat Sand Plaster - 2nd Floor Hall	0%	100%	NAD

Julia McKenzie, Tracy Skalski
Analyst(s)

Approved Signatory

Disclaimer: NAD = No asbestos detected. Results relate only to samples provided by client. This report shall not be reproduced, except in full, without written approval by Sienna. Samples analyzed as NAD or Trace (<1%) cannot be guaranteed. Quantitative transmission electron microscopy is currently the only reliable method that can be used to determine if this material can be considered or treated as non-asbestos containing. Analysis performed by Sienna Environmental Technologies, NY ELAP #11727.



SIENNA ENVIRONMENTAL TECHNOLOGIES, LLC

429 Franklin St. • Suite 102 • Buffalo, NY 14202 • Ph: 716-332-3134 • Fax: 716-332-3136

LABORATORY REPORT

Attn: Jeffrey Robbins
C & S Engineers
499 Col. Eileen Collins Blvd
Syracuse, NY 13212

Phone: 315-455-2000

Fax: 315-455-9667

Project: SET954 Satterlee Hall

Date Received: 12/18/2008


Date Analyzed: 12/31/2008

Sienna ID: P159

Polarized Light Microscopy (PLM) by NY State ELAP Method 198.1

Sample	Description	Location	% Fibrous	% Non-Fibrous	% Asbestos Type
1212-SAT-101A-4 P159-14	Gray, Non-Fibrous, Homogenous	Skim Coat Sand Plaster - 2nd Floor Hall	0%	100%	NAD
1212-SAT-101A-5 P159-15	Gray, Non-Fibrous, Homogenous	Skim Coat Sand Plaster - 3rd Floor Hall	0%	100%	NAD
1212-SAT-101B-1 P159-16	Gray, Non-Fibrous, Homogenous	Base Coat Sand Plaster - 1st Floor Hall	0%	100%	NAD
1212-SAT-101B-2 P159-17	Gray, Non-Fibrous, Homogenous	Base Coat Sand Plaster - Room 113	0%	100%	NAD
1212-SAT-101B-3 P159-18	Gray, Non-Fibrous, Homogenous	Base Coat Sand Plaster - 2nd Floor Hall	0%	100%	NAD
1212-SAT-101B-4 P159-19	Gray, Non-Fibrous, Homogenous	Base Coat Sand Plaster - 2nd Floor Hall	0%	100%	NAD
1212-SAT-101B-5 P159-20	Gray, Non-Fibrous, Homogenous	Base Coat Sand Plaster - 3rd Floor Hall	0%	100%	NAD
1212-SAT-102-1 P159-21	Gray, Non-Fibrous, Homogenous	Glazed Block Mortar - 1st Floor Hall	0%	100%	NAD
1212-SAT-102-2 P159-22	Gray, Non-Fibrous, Homogenous	Glazed Block Mortar - 2nd Floor Hall	0%	100%	NAD
1212-SAT-103-1 P159-23	Gray, Non-Fibrous, Homogenous	Cinder Block Mortar - Basement	0%	100%	NAD
1212-SAT-103-2 P159-24	Gray, Non-Fibrous, Homogenous	Cinder Block Mortar - Basement	0%	100%	NAD
1212-SAT-104A-1 P159-25	White, Fibrous, Non- Homogenous	Drywall - 1st Floor Hall	0%	100%	NAD
1212-SAT-104A-2 P159-26	White, Fibrous, Homogenous	Drywall - 1st Floor Hall	0%	100%	NAD

Julia McKenzie, Tracy Skalski
Analyst(s)

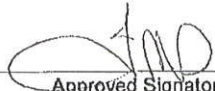
Approved Signatory

Disclaimers: NAD = No asbestos detected. Results relate only to samples provided by client. This report shall not be reproduced, except in full, without written approval by Sienna. Samples analyzed as NAD or Trace (<1%) cannot be guaranteed. Quantitative transmission electron microscopy is currently the only reliable method that can be used to determine if this material can be considered or treated as non-asbestos containing. Analysis performed by Sienna Environmental Technologies, NY ELAP #11727.



SIENNA ENVIRONMENTAL TECHNOLOGIES, LLC

429 Franklin St. · Suite 102 · Buffalo, NY 14202 · Ph: 716-332-3134 · Fax: 716-332-3136

LABORATORY REPORT

Attn: Jeffrey Robbins
C & S Engineers
499 Col. Eileen Collins Blvd
Syracuse, NY 13212

Date Received: 12/18/2008

Date Analyzed: 12/31/2008

Sienna ID: P159

Phone: 315-455-2000

Fax: 315-455-9667

Project: SET954 Satterlee Hall

Polarized Light Microscopy (PLM) by NY State ELAP Method 198.1

Sample	Description	Location	% Fibrous	% Non-Fibrous	% Asbestos Type
1212-SAT-104B-1 P159-27	White, Non-Fibrous, Homogenous	Joint Compound - 1st Floor Hall	0%	100%	NAD
1212-SAT-104B-2 P159-28	White, Non-Fibrous, Homogenous	Joint Compound - 1st Floor Hall	0%	100%	NAD
1212-SAT-200-1 P159-29	Gray, Non-Fibrous, Homogenous	1x1 Splined Ceiling Tile - 1st Floor Hall	15%	85%	NAD
1212-SAT-200-2 P159-30	Gray, Non-Fibrous, Homogenous	1x1 Splined Ceiling Tile - 1st Floor Hall	10%	90%	NAD
1212-SAT-201A-1 P159-31	White, Non-Fibrous, Homogenous	Plaster Skim Coat - 1st Floor Hall	0%	100%	NAD
1212-SAT-201B-1 P159-32	Gray, Non-Fibrous, Homogenous	Plaster Base Coat - 1st Floor Hall	0%	100%	NAD
1212-SAT-202-1 P159-33	Brown, Fibrous, Non- Homogenous	1x1 Textured Ceiling Tile - Room 104	40%	60%	NAD
1212-SAT-202-2 P159-34	Brown, Fibrous, Non- Homogenous	1x1 Textured Ceiling Tile - Room 104	30%	70%	NAD
1212-SAT-203-1 P159-35	Gray, Fibrous, Non- Homogenous	2x2 Dot & Texture Ceiling Tile - 1st Floor Hall	20%	80%	NAD
1212-SAT-203-2 P159-36	Gray, Fibrous, Non- Homogenous	2x2 Dot & Texture Ceiling Tile - 1st Floor Hall	40%	60%	NAD
1212-SAT-204-1 P159-37	Brown, Fibrous, Non- Homogenous	2x2 Dot Ceiling Tile - Room 200	20%	80%	NAD
1212-SAT-204-2 P159-38	Brown, Fibrous, Non- Homogenous	2x2 Dot Ceiling Tile - Room 200	15%	85%	NAD

Julia McKenzie, Tracy Skalski
Analyst(s)

Approved Signatory

Disclaimers: NAD = No asbestos detected. Results relate only to samples provided by client. This report shall not be reproduced, except in full, without written approval by Sienna. Samples analyzed as NAD or Trace (<1%) cannot be guaranteed. Quantitative transmission electron microscopy is currently the only reliable method that can be used to determine if this material can be considered or treated as non-asbestos containing. Analysis performed by Sienna Environmental Technologies, NY ELAP #11727.

SIENNA ENVIRONMENTAL TECHNOLOGIES, LLC

429 Franklin Street, Suite 102
Buffalo, NY 14202

Phone 716-332-3134
Fax 716-332-3136

Chain of Custody Document

x Report to: _____

Client/Contact: <u>C/S Engineers Jeffrey Robbins</u>	Turn around (circle) RUSH 48 Hour 24 Hour 72 Hour
Building/Location: <u>SATTERLEE HALL</u>	
Job #: <u>SET954</u> Total # Samples: <u>38</u>	

X PLM TEM AAS OTHER _____

Sample #	Description of Sample	Location of Sample	Notes
1212-SAT-100A-1	Skim coat plaster	Auditorium	P159-1
1212-SAT-100A-2	Skim coat plaster	1st fl. mens room	-2
1212-SAT-100A-3	Skim coat plaster	2nd fl. ladies rm.	-3
1212-SAT-100A-4	Skim coat plaster	Rm 223	-4
1212-SAT-100A-5	Skim coat plaster	3rd fl. men's room	-5
1212-SAT-100B-1	Base coat plaster	Auditorium	-6
1212-SAT-100B-2	Base coat plaster	1st fl. mens room	-7
1212-SAT-100B-3	Base coat plaster	2nd fl. ladies room.	-8
1212-SAT-100B-4	Base coat plaster	Rm. 223	-9
1212-SAT-100B-5	Base coat plaster	3rd fl. mens room.	-10
1212-SAT-101A-1	Skim coat sand plaster	1st fl. hall	-11
1212-SAT-101A-2	Skim coat sand plaster	Rm 113	-12
1212-SAT-101A-3	Skim coat sand plaster	2nd fl. hall	-13
1212-SAT-101A-4	Skim coat sand plaster	2nd fl. hall	-14
1212-SAT-101A-5	Skim coat sand plaster	3rd fl. hall	-15
1212-SAT-101B-1	base coat sand plaster	1st fl. hall	P159-16

Notes:

Pg 1 of 3

Sienna Environmental
Technologies

☒ Accept
☐ Reject

Sampled By: Paul J. Maury

Date: 12/12/08

Relinquished By:

Date:

Received By:

J. Stasi 1500

P159

Date: 12/18/08

SIENNA ENVIRONMENTAL TECHNOLOGIES, LLC

429 Franklin Street, Suite 102
Buffalo, NY 14202

Phone 716-332-3134
Fax 716-332-3136

Chain of Custody Document

x Report to: _____

Client/Contact: <u>C i S Engineers- Jeffrey Robbins</u>	Turn around (circle) RUSH 48 Hour 24 Hour 72 Hour
Building/Location: <u>SATTERLEE HALL</u>	
Job #: <u>SET954</u> Total # Samples: <u>38</u>	

X PLM _____ TEM _____ AAS _____ OTHER _____

Sample #	Description of Sample	Location of Sample	Notes
1212-SAT-101B-2	Base coat sand plaster	Rm 113	PS9-17
1212-SAT-101B-3	Base coat sand plaster	2nd fl. hall	-18
1212-SAT-101B-4	Base coat sand plaster	2nd fl. hall	-19
1212-SAT-101B-5	Base coat sand plaster	3rd fl. hall	-20
1212-SAT-102-1	Glazed brick mortar	1st fl. hall	-21
1212-SAT-102-2	Glazed brick mortar	2nd fl. hall	-22
1212-SAT-103-1	Cinder block mortar	Basement	-23
1212-SAT-103-2	Cinder block mortar	Basement	-24
1212-SAT-104A-1	Drywall	1st fl. hall	-25
1212-SAT-104A-2	Drywall	1st fl. hall	-26
1212-SAT-104B-1	Joint Compound	1st fl. hall	-27
1212-SAT-104B-2	Joint Compound	1st fl. hall	-28
1212-SAT-200-1	1x1 splined CT	1st fl. hall	-29
1212-SAT-200-2	1x1 splined CT	1st fl. hall	-30
1212-SAT-201A-1	Plaster ^{SKIM} base coat	1st fl. hall	-31
1212-SAT-201B-1	Plaster base coat	1st fl. hall	PS9-32

Notes:

PS 2 of 3

Sienna Environmental
Technologies

☒ Accept

☐ Reject

Sampled By:

Paul J. Mair

Relinquished By:

Paul J. Mair

Received By:

Stacy 1500

Date: 12/12/08

Date: 12/12/08

Date: 12/18/08

429 Franklin Street, Suite 102
Buffalo, NY 14202

Phone 716-332-3134
Fax 716-332-3136

Report to: _____

X PLM TEM AAS OTHER

Notes:

ps 3 of 3

Sampled By: Paul J. Maier Date: 12/12/08
Relinquished By: Paul J. Maier Date: _____
Received By: J. Stead 1560 P159 Date: 12/18/08

**AmeriSci New York**

117 EAST 30TH ST.
NEW YORK, NY 10016
TEL: (212) 679-8600 • FAX: (212) 679-3114

PLM Bulk Asbestos Report

Sienna Environmental Technologies, LL
Attn: Suzanne Kelley
429 Franklin Street Suite 102
Buffalo, NY 14202

Date Received 12/30/08
Date Examined 12/30/08
ELAP # 11480
RE: SET 954; C&S Engineers; Thatcher Hall, SUNY Potsdam

AmeriSci Job # 208123751
P.O. #
Page 1 of 4

Client No. / HGA	Lab No.	Asbestos Present	Total % Asbestos
1216-THA-100-1 Location: Cinder Block Mortar / 1st Floor Mechanical Analyst Description: Grey, Homogeneous, Non-Fibrous, Cementitious, Bulk Material Asbestos Types: Other Material: Non-fibrous 100 %	208123751-01	No	NAD (by NYS ELAP 198.1) by Karol H. Lu on 12/30/08
1216-THA-100-2 Location: Cinder Block Mortar / 1st Floor Mechanical Analyst Description: Grey, Homogeneous, Non-Fibrous, Cementitious, Bulk Material Asbestos Types: Other Material: Non-fibrous 100 %	208123751-02	No	NAD (by NYS ELAP 198.1) by Karol H. Lu on 12/30/08
1216-THA-101A-1 Location: Grout Of Ceramic Tile / Kitchen Analyst Description: White, Homogeneous, Non-Fibrous, Bulk Material Asbestos Types: Other Material: Non-fibrous 100 %	208123751-03	No	NAD (by NYS ELAP 198.1) by Karol H. Lu on 12/30/08
1216-THA-101A-2 Location: Grout Of Ceramic Tile / Kitchen Analyst Description: White, Homogeneous, Non-Fibrous, Bulk Material Asbestos Types: Other Material: Non-fibrous 100 %	208123751-04	No	NAD (by NYS ELAP 198.1) by Karol H. Lu on 12/30/08
1216-THA-101B-1 Location: Thinset Of Ceramic Tile / Kitchen Analyst Description: Grey, Homogeneous, Non-Fibrous, Cementitious, Bulk Material Asbestos Types: Other Material: Non-fibrous 100 %	208123751-05	No	NAD (by NYS ELAP 198.1) by Karol H. Lu on 12/30/08

See Reporting notes on last page

Received Time Dec. 30, 2008 2:02PM No. 2621

Client Name: Sienna Environmental Technologies, LLC

PLM Bulk Asbestos Report

SET 954; C&S Engineers; Thatcher Hall, SUNY Potsdam

Client No. / HGA	Lab No.	Asbestos Present	Total % Asbestos
1216-THA-101B-2 Location: Thinset Of Ceramic Tile / Kitchen Analyst Description: Grey, Homogeneous, Non-Fibrous, Cementitious, Bulk Material Asbestos Types: Other Material: Non-fibrous 100 %	208123751-06	No	NAD (by NYS ELAP 198.1) by Karol H. Lu on 12/30/08
1216-THA-102A-1 Location: Plaster Skim Coat / 2nd Floor Dining Room Analyst Description: White, Homogeneous, Non-Fibrous, Bulk Material Asbestos Types: Other Material: Non-fibrous 100 %	208123751-07	No	NAD (by NYS ELAP 198.1) by Karol H. Lu on 12/30/08
1216-THA-102A-2 Location: Plaster Skim Coat / 2nd Floor Dining Room Analyst Description: White, Homogeneous, Non-Fibrous, Bulk Material Asbestos Types: Other Material: Non-fibrous 100 %	208123751-08	No	NAD (by NYS ELAP 198.1) by Karol H. Lu on 12/30/08
1216-THA-102A-3 Location: Plaster Skim Coat / 2nd Floor Dining Room Analyst Description: White, Homogeneous, Non-Fibrous, Bulk Material Asbestos Types: Other Material: Non-fibrous 100 %	208123751-09	No	NAD (by NYS ELAP 198.1) by Karol H. Lu on 12/30/08
1216-THA-102B-1 Location: Plaster Base Coat / 2nd Floor Dining Room Analyst Description: Grey, Homogeneous, Non-Fibrous, Cementitious, Bulk Material Asbestos Types: Other Material: Non-fibrous 100 %	208123751-10	No	NAD (by NYS ELAP 198.1) by Karol H. Lu on 12/30/08
1216-THA-102B-2 Location: Plaster Base Coat / 2nd Floor Dining Room Analyst Description: Grey, Homogeneous, Non-Fibrous, Cementitious, Bulk Material Asbestos Types: Other Material: Non-fibrous 100 %	208123751-11	No	NAD (by NYS ELAP 198.1) by Karol H. Lu on 12/30/08

See Reporting notes on last page

Received Time Dec. 30. 2008 2:02PM No. 2621

Client Name: Sienna Environmental Technologies, LLC

PLM Bulk Asbestos Report

SET 954; C&S Engineers; Thatcher Hall, SUNY Potsdam

Client No. / HGA	Lab No.	Asbestos Present	Total % Asbestos
1216-THA-102B-3	208123751-12	No	NAD
Location: Plaster Base Coat / 2nd Floor Dining Room			(by NYS ELAP 198.1) by Karol H. Lu on 12/30/08
Analyst Description: Grey, Homogeneous, Non-Fibrous, Cementitious, Bulk Material			
Asbestos Types:			
Other Material: Non-fibrous 100 %			
1216-THA-200-1	208123751-13	No	NAD
Location: 1x1 Fissure Ceiling Tile / Dining Room			(by NYS ELAP 198.1) by Karol H. Lu on 12/30/08
Analyst Description: Grey, Homogeneous, Fibrous, Bulk Material			
Asbestos Types:			
Other Material: Cellulose 20 %, Fibrous glass 50 %, Non-fibrous 30 %			
1216-THA-200-2	208123751-14	No	NAD
Location: 1x1 Fissure Ceiling Tile / Dining Room			(by NYS ELAP 198.1) by Karol H. Lu on 12/30/08
Analyst Description: Beige, Homogeneous, Fibrous, Bulk Material			
Asbestos Types:			
Other Material: Cellulose 20 %, Fibrous glass 50 %, Non-fibrous 30 %			
1216-THA-201-1	208123751-15	No	NAD
Location: 2x2 Gypsum Ceiling Tile / Kitchen			(by NYS ELAP 198.1) by Karol H. Lu on 12/30/08
Analyst Description: White, Homogeneous, Fibrous, Bulk Material			
Asbestos Types:			
Other Material: Cellulose 10 %, Fibrous glass Trace, Non-fibrous 90 %			
1216-THA-201-2	208123751-16	No	NAD
Location: 2x2 Gypsum Ceiling Tile / Kitchen			(by NYS ELAP 198.1) by Karol H. Lu on 12/30/08
Analyst Description: White, Homogeneous, Fibrous, Bulk Material			
Asbestos Types:			
Other Material: Cellulose 10 %, Fibrous glass Trace, Non-fibrous 90 %			


See Reporting notes on last page

Received Time Dec. 30, 2008 2:02PM No. 2621

PLM Bulk Asbestos Report

SET 954; C&S Engineers; Thatcher Hall, SUNY Potsdam

Reporting Notes:

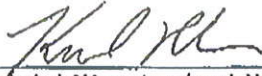Analyzed by: Karol H. Lu 

*NAD/NSD = no asbestos detected; NA = not analyzed; NA/PS = not analyzed/positive stop; PLM Bulk Asbestos Analysis by EPA 600/M4-82-020 per 40 CFR 763 (NVLAP Lab Code 200546-0), ELAP PLM Method 198.1 for NY friable samples or 198.6 for NOB samples (NY ELAP Lab ID11480);

Note: PLM is not consistently reliable in detecting asbestos in floor coverings and similar non-friable organically bound materials. NAD or Trace results by PLM are inconclusive, TEM is currently the only method that can be used to determine if this material can be considered or treated as non asbestos-containing in NY State (also see EPA Advisory for floor tile, FR 59, 146, 36970, 8/1/94). National Institute of Standards and Technology Accreditation requirements mandate that this report must not be reproduced except in full without the approval of the lab. This PLM report relates ONLY to the items tested. AIHA Lab # 102843.

Reviewed By: _____

END OF REPORT _____

SIENNA ENVIRONMENTAL TECHNOLOGIES, LLC

429 Franklin Street, Suite 102
Buffalo, NY 14202

Phone 716-332-3134
Fax 716-332-3136

Chain of Custody Document

ix Report to: _____

Client/Contact: <u>C & S Engineers, Jeffrey Robbins</u>		Turn around (circle) RUSH 48 Hour <u>24 Hour</u> 72 Hour
Building/Location: <u>Thatcher Hall, SUNY Potsdam</u>		
Job #: <u>SET954</u>	Total # Samples: <u>16</u>	<u>208128751</u>

X PLM TEM AAS OTHER

Sample #	Description of Sample	Location of Sample	Notes
1216-THA-100-1	Cinder block mortar	1st floor mechanical	-1
1216-THA-100-2	Cinder block mortar	1st floor mechanical	-2
1216-THA-101A-1	Grout of ceramic tile	Kitchen	-3
1216-THA-101A-2	Grout of ceramic tile	Kitchen	-4
1216-THA-101B-1	Thinset of ceramic tile	Kitchen	-5
1216-THA-101B-2	Thinset of ceramic tile	Kitchen	-6
1216-THA-102A-1	Plaster stem coat	2nd floor dining room	-7
1216-THA-102A-2	Plaster stem coat	2nd floor dining room	-8
1216-THA-102A-3	Plaster stem coat	2nd floor dining room	-9
1216-THA-102B-1	Plaster base coat	2nd floor dining room	-10
1216-THA-102B-2	Plaster base coat	2nd floor dining room	-11
1216-THA-102B-3	Plaster base coat	2nd floor dining room	-12
1216-THA-200-1	1x1 fissure ceiling tile	Dining room	-13
1216-THA-200-2	1x1 fissure ceiling tile	Dining room	-14
1216-THA-201-1	2x2 Gypsum ceiling tile	Kitchen	-15
1216-THA-201-2	2x2 Gypsum ceiling tile	Kitchen	-16

Notes:

Page 1 of 1

Sienna Environmental
Technologies
☒ Accept
☐ Reject

Sampled By: Paul J. Manning

Date: 12/16/08

Relinquished By: Paul J. Manning

Date: _____

Received By: Paul J. Manning
Received Time: Dec. 30, 2008 2:02PM No. 2621

0940

Date: 12/30/08



SIENNA ENVIRONMENTAL TECHNOLOGIES, LLC

429 Franklin St. · Suite 102 · Buffalo, NY 14202 · Ph: 716-332-3134 · Fax: 716-332-3136

LABORATORY REPORT

Attn: Jeffrey Robbins
C & S Engineers
499 Col. Eileen Collins Blvd
Syracuse, NY 13212

Date Received: 12/18/2008

Date Analyzed: 12/29/2008

Sienna ID: P153

Phone: 315-455-2000

Fax: 315-455-9667

Project: SET954 Dunn Hall

Polarized Light Microscopy (PLM) by NY State ELAP Method 198.1

Sample	Description	Location	% Fibrous	% Non-Fibrous	% Asbestos Type
1216-DUN-100A-1 P153-1	Gray, Fibrous, Non-Homogenous	Drywall - 1st Floor Hall	0%	100%	NAD
1216-DUN-100A-2 P153-2	Gray, Fibrous, Non-Homogenous	Drywall - Room 110	0%	100%	NAD
1216-DUN-100B-1 P153-3	Gray, Non-Fibrous, Homogenous	Joint Compound - 1st Floor Hall	0%	100%	NAD
1216-DUN-100B-2 P153-4	Gray, Non-Fibrous, Homogenous	Joint Compound - Room 110	0%	100%	NAD
1216-DUN-101-1 P153-5	Gray, Non-Fibrous, Homogenous	Glazed Block Mortar - 1st Floor Hall	0%	100%	NAD
1216-DUN-101-2 P153-6	Gray, Non-Fibrous, Homogenous	Glazed Block Mortar - 1st Floor Hall	0%	100%	NAD
1216-DUN-200-1 P153-7	Gray, Fibrous, Homogenous	2'x2' Dot Ceiling Tile - Room 101C	70%	30%	NAD
1216-DUN-200-2 P153-8	White, Fibrous, Homogenous	2'x2' Dot Ceiling Tile - Room 101C	60%	40%	NAD
1216-DUN-201A-1 P153-9	Yellow, Fibrous, Non-Homogenous	1'x1' Dot Ceiling Tile - 1st Floor Hall	25%	75%	NAD
1216-DUN-201A-2 P153-10	Yellow, Fibrous, Non-Homogenous	1'x1' Dot Ceiling Tile - 1st Floor Hall	25%	75%	NAD
1216-DUN-202-1 P153-13	Brown, Fibrous, Non-Homogenous	2'x2' Large Dot Ceiling Tile - 1st Floor Dance Studio	20%	80%	NAD
1216-DUN-202-2 P153-14	Brown, Fibrous, Non-Homogenous	2'x2' Large Dot Ceiling Tile - 1st Floor Dance Studio	10%	90%	NAD
1216-DUN-203A-1 P153-15	White, Non-Fibrous, Homogenous	Plaster Skim Coat - 1st Floor Dance Studio	0%	100%	NAD

Tracy Skalski
Analyst(s)

Approved Signatory

Disclaimers: NAD = No asbestos detected. Results relate only to samples provided by client. This report shall not be reproduced, except in full, without written approval by Sienna. Samples analyzed as NAD or Trace (<1%) cannot be guaranteed. Quantitative transmission electron microscopy is currently the only reliable method that can be used to determine if this material can be considered or treated as non-asbestos containing. Analysis performed by Sienna Environmental Technologies, NY ELAP #11727.



SIENNA ENVIRONMENTAL TECHNOLOGIES, LLC

429 Franklin St. · Suite 102 · Buffalo, NY 14202 · Ph: 716-332-3134 · Fax: 716-332-3136

LABORATORY REPORT


Attn: Jeffrey Robbins
C & S Engineers
499 Col. Eileen Collins Blvd
Syracuse, NY 13212
Phone: 315-455-2000 Fax: 315-455-9667
Project: SET954 Dunn Hall

Date Received: 12/18/2008
Date Analyzed: 12/29/2008
Sienna ID: P153

Polarized Light Microscopy (PLM) by NY State ELAP Method 198.1

Sample	Description	Location	% Fibrous	% Non-Fibrous	% Asbestos Type
1216-DUN-203A-2 P153-16	White, Non-Fibrous, Homogenous	Plaster Skim Coat - Room 110	0%	100%	NAD
1216-DUN-203A-3 P153-17	White, Non-Fibrous, Homogenous	Plaster Skim Coat - 3rd Floor Custodial Room	0%	100%	NAD
1216-DUN-203B-1 P153-18	Gray, Non-Fibrous, Homogenous	Plaster Base Coat - 1st Floor Dance Studio	0%	100%	NAD
1216-DUN-203B-2 P153-19	Gray, Non-Fibrous, Homogenous	Plaster Base Coat - Room 110	0%	100%	NAD
1216-DUN-203B-3 P153-20	Gray, Non-Fibrous, Homogenous	Plaster Base Coat - 3rd Floor Custodial Room	0%	100%	NAD
1216-DUN-204-1 P153-21	White, Non-Fibrous, Homogenous	Textured Finish - Room 329	0%	100%	NAD
1216-DUN-204-2 P153-22	White, Non-Fibrous, Homogenous	Textured Finish - Room 329	0%	100%	NAD
1216-DUN-203-3 P153-23	White, Non-Fibrous, Homogenous	Textured Finish - Room 329	0%	100%	NAD
1216-DUN-300-1 P153-24	Gray, Non-Fibrous, Homogenous	Terrazzo - 1st Floor Stairwell	0%	100%	NAD
1216-DUN-300-2 P153-25	Gray, Non-Fibrous, Homogenous	Terrazzo - 1st Floor Stairwell	0%	100%	NAD

Tracy Skalski
Analyst(s)

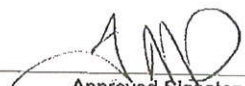
Approved Signatory

Disclaimers: NAD = No asbestos detected. Results relate only to samples provided by client. This report shall not be reproduced, except in full, without written approval by Sienna. Samples analyzed as NAD or Trace (<1%) cannot be guaranteed. Quantitative transmission electron microscopy is currently the only reliable method that can be used to determine if this material can be considered or treated as non-asbestos containing. Analysis performed by Sienna Environmental Technologies, NY ELAP #11727.



SIENNA ENVIRONMENTAL TECHNOLOGIES, LLC

429 Franklin St. • Suite 102 • Buffalo, NY 14202 • Ph: 716-332-3134 • Fax: 716-332-3136

LABORATORY REPORT

Attn: Jeffrey Robbins
C & S Engineers
499 Col. Eileen Collins Blvd
Syracuse, NY 13212
Phone: 315-455-2000 Fax: 315-455-9667
Project: SET954 Dunn Hall

Date Received: 12/18/2008
Date Analyzed: 12/29/2008
Sienna ID: P153

Polarized Light Microscopy (PLM) of Non-Friable, Organically Bound Materials by NY State ELAP Method 198.6

Sample	Description	Location	% Fibrous	% Non-Fibrous	% Asbestos Type
1216-DUN-201B-1 P153-11	Brown, Non-Fibrous, Homogenous	Glue of 1'x1' Dot Ceiling Tile - 1st Floor Hall	5%	95%	Inconclusive: No Asbestos Detected
1216-DUN-201B-2 P153-12	Brown, Non-Fibrous, Homogenous	Glue of 1'x1' Dot Ceiling Tile - 1st Floor Hall	5%	95%	Inconclusive: No Asbestos Detected

Tracy Skalski
Analyst(s)


Approved Signatory

Disclaimer: Polarized Light Microscopy is not consistently reliable in detecting asbestos in floor coverings and similar non-friable, organically-bound materials. Quantitative transmission electron microscopy is currently the only method that can be used to determine if this material can be considered or treated as non-asbestos containing. Results relate only to samples provided by client. This report shall not be reproduced, except in full, without written approval by Sienna. Analysis performed by Sienna Environmental Technologies, NY ELAP #11727.

Table 1

Summary of Bulk Asbestos Analysis Results by NYS ELAP 198.4 NOB Method

SET 954; C&S Engineers; Dunn Hall SUNY Potsdam

AmeriSci Sample #	Client Sample#	HG Area	Sample Weight (gram)	Float Sensitive Organic %	Acid Soluble Inorganic %	Insoluble Non-Asbestos Inorganic %	** Asbestos % by TEM
01	1216-DUN-201B-1		0.237	47.3	8.9	43.9	NAD
Location:	Glue Dob Of 201A / 1st Floor Hall						
02	1216-DUN-201B-2		0.226	48.7	9.3	42.0	NAD
Location:	Glue Dob Of 201A / 1st Floor Hall						

Analyzed by: Madeli E. Collins; Date Analyzed 12/30/2008

**Quantitative Analysis (Semi/Full): Bulk Asbestos Analysis - PLM by EPA 600/M4-82-020 per 40 CFR or ELAP 198.1 for New York friable samples or ELAP 198.6 for New York NOB samples; TEM (Semi/Full) by EPA 600/R-93/116 (not covered by NVLAP Bulk accreditation); or ELAP 198.4 for New York samples; NAD = no asbestos detected during a qualitative analysis; NA = not analyzed; Trace = <1%; Quantification for beginning weights of <0.1 grams should be considered as qualitative only; Qualitative Analysis: Asbestos analysis results of "Present" or "NVA = No Visible Asbestos" represents results for Qualitative PLM or TEM Analysis only (no accreditation coverage available from any regulatory agency for qualitative analyses); AIHA Lab # 102843, NVLAP Lab Code 200543-0, NYSDOH ELAP LAB ID 11480.

Warning Note: PLM limitation, only TEM will resolve fibers <0.25 micrometers in diameter. TEM bulk analysis is representative of the fine grained matrix material and may not be representative of non-uniformly dispersed debris for which PLM evaluation is recommended (i.e. soils and other heterogeneous materials).

Reviewed By: _____

SIENNA ENVIRONMENTAL TECHNOLOGIES, LLC

429 Franklin Street, Suite 102
Buffalo, NY 14202

Phone 716-332-3134
Fax 716-332-3136

Chain of Custody Document

Report to: _____

Client/Contact: <u>C & S Engineers, Jeffrey Robbins</u>	Turn around (circle) RUSH 48 Hour 24 Hour 72 Hour
Building/Location: <u>Dunn Hall, SUNY Potsdam</u>	
Job #: <u>SET954</u> Total # Samples: <u>25</u>	

☒ PLM ☒ TEM ☐ AAS ☐ OTHER _____

Sample #	Description of Sample	Location of Sample	Notes
1216-DUN-100A-1	Drywall	1st floor hall	P153-1
1216-DUN-100A-2	Drywall	Room 110	-2
1216-DUN-100B-1	Joint compound	1st floor hall	-3
1216-DUN-100B-2	Joint compound	Room 110	-4
1216-DUN-101-1	Glazed block mortar	1st floor hall	-5
1216-DUN-101-2	Glazed block mortar	1st floor hall	-6
1216-DUN-200-1	2x2 dot ceiling tile	Room 101C	-7
1216-DUN-200-2	2x2 dot ceiling tile	Room 101C	-8
1216-DUN-201A-1	1x1 dot ceiling tile	1st floor hall	-9
1216-DUN-201A-2	1x1 dot ceiling tile	1st floor hall	-10
1216-DUN-201B-1	Glue dob of 201A	1st floor hall	-11
1216-DUN-201B-2	Glue dob of 201A	1st floor hall	-12
1216-DUN-202-1	2x2 large dot ceiling tile	1st floor dance studio	-13
1216-DUN-202-2	2x2 large dot ceiling tile	1st floor dance studio	-14
1216-DUN-203A-1	Plaster skim coat	1st floor dance studio	-15
1216-DUN-203A-2	Plaster skim coat	Room 110	P153-16

Notes:

Page 1 of 2

Sienna Environmental
Technologies

☒ Accept

☐ Reject

Neg. NUBs by PLM
to TEM

Sampled By:

Paul J. Mair

Date:

12/16/08

Relinquished By:

Paul J. Mair

Date:

Received By:

Paul J. Mair

P153

Date:

12/18/08

429 Franklin Street, Suite 102
Buffalo, NY 14202

Phone 716-332-3134
Fax 716-332-3136

Chain of Custody Document

ix Report to:

Client/Contact: <u>C & S Engineers, Jeffrey Robbins</u>	Turn around (circle)
Building/Location: <u>Dunn Hall, SUNY Potsdam</u>	
Job #: <u>SET954</u> Total # Samples: <u>25</u>	☒ RUSH 48 Hour ☐ 24 Hour 72 Hour

✓ PLM ✓ TEM _____ AAS OTHER _____

[illegible]

Notes:

Page 2 of 2

* Neg. NUBs by PLM
to TEM

Sampled By:

Paul J. Hickey

Date: 12/16/08

Relinquished By:

Paul J. Mawry

Date: _____

Received By:

Y: Stalki 1500 A53

Date: 12/18/02

PLM Bulk Asbestos Report

Sienna Environmental Technologies, LL
Attn: Suzanne Kelley
429 Franklin Street Suite 102
Buffalo, NY 14202

Date Received 12/30/08 AmeriSci Job # 208123749
Date Examined 12/30/08 P.O. #
ELAP # 11480 Page 1 of 4
RE: SET 964; C&S Engineers; **Sissin Hall** (Report Amended
12/30/2008)

Client No. / HGA	Lab No.	Asbestos Present	Total % Asbestos
1216-SIS-100A-1 Location: Plaster Skim Coat / Basement	208123749-01	No	NAD (by NYS ELAP 198.1) by Albert Grohmann on 12/30/08
Analyst Description: OffWhite, Homogeneous, Non-Fibrous, Cementitious, Bulk Material Asbestos Types: Other Material: Cellulose Trace, Non-fibrous 100 %			
1216-SIS-100A-2 Location: Plaster Skim Coat / Rm 343	208123749-02	No	NAD (by NYS ELAP 198.1) by Albert Grohmann on 12/30/08
Analyst Description: White, Homogeneous, Non-Fibrous, Bulk Material Asbestos Types: Other Material: Cellulose Trace, Non-fibrous 100 %			
1216-SIS-100A-3 Location: Plaster Skim Coat / 2nd Fl Stairwell	208123749-03	No	NAD (by NYS ELAP 198.1) by Albert Grohmann on 12/30/08
Analyst Description: White, Homogeneous, Non-Fibrous, Bulk Material Asbestos Types: Other Material: Cellulose Trace, Non-fibrous 100 %			
1216-SIS-100B-1 Location: Plaster Base Coat / Basement	208123749-04	No	NAD (by NYS ELAP 198.1) by Albert Grohmann on 12/30/08
Analyst Description: Grey, Homogeneous, Non-Fibrous, Cementitious, Bulk Material Asbestos Types: Other Material: Cellulose Trace, Non-fibrous 100 %			
1216-SIS-100B-2 Location: Plaster Base Coat / Rm 343	208123749-05	No	NAD (by NYS ELAP 198.1) by Albert Grohmann on 12/30/08
Analyst Description: Grey, Homogeneous, Non-Fibrous, Cementitious, Bulk Material Asbestos Types: Other Material: Cellulose Trace, Non-fibrous 100 %			

See Reporting notes on last page

Received Time Dec. 30. 2008 2:44PM No. 2629

PLM Bulk Asbestos ReportSET 954; C&S Engineers; Sissin Hall (Report Amended
12/30/2008)

Client No. / HGA	Lab No.	Asbestos Present	Total % Asbestos
1216-SIS-100B-3 Location: Plaster Base Coat / 2nd Fl, Stairwell Analyst Description: Grey, Homogeneous, Non-Fibrous, Cementitious, Bulk Material Asbestos Types: Other Material: Cellulose Trace, Non-fibrous 100 %	208123749-06	No	NAD (by NYS ELAP 198.1) by Albert Grohmann on 12/30/08
1216-SIS-101-1 Location: Lightweight Concrete / 3rd Fl Hall Analyst Description: Grey, Homogeneous, Non-Fibrous, Cementitious, Bulk Material Asbestos Types: Other Material: Cellulose Trace, Non-fibrous 100 %	208123749-07	No	NAD (by NYS ELAP 198.1) by Albert Grohmann on 12/30/08
1216-SIS-101-2 Location: Lightweight Concrete / 2nd Fl Hall Analyst Description: Grey, Homogeneous, Non-Fibrous, Bulk Material Asbestos Types: Other Material: Cellulose Trace, Non-fibrous 100 %	208123749-08	No	NAD (by NYS ELAP 198.1) by Albert Grohmann on 12/30/08
1216-SIS-200-1 Location: Insulation Material / Basement Analyst Description: OffWhite, Homogeneous, Non-Fibrous, Cementitious, Bulk Material Asbestos Types: Chrysotile <1 % pc Other Material: Cellulose Trace, Fibrous glass Trace, Non-fibrous 100 %	208123749-09	Yes	Trace (<1 %) (by NYS ELAP 198.1) by Albert Grohmann on 12/30/08
1216-SIS-200-2 Location: Insulation Material / Basement Analyst Description: OffWhite, Homogeneous, Non-Fibrous, Cementitious, Bulk Material Asbestos Types: Chrysotile <1 % pc Other Material: Cellulose Trace, Fibrous glass Trace, Non-fibrous 100 %	208123749-10L1	Yes	Trace (<1 %) (by NYS ELAP 198.1) by Albert Grohmann on 12/30/08
1216-SIS-200-2 Location: Insulation Material / Basement - Mastic material Analyst Description: Black, Homogeneous, Non-Fibrous, Bulk Material Asbestos Types: Other Material: Cellulose Trace, Fibrous glass Trace, Non-fibrous 100 %	208123749-10L2	No	NAD (by NYS ELAP 198.1) by Albert Grohmann on 12/30/08

See Reporting notes on last page

Received Time Dec. 30, 2008 2:44PM No. 2629

PLM Bulk Asbestos ReportSET 954; C&S Engineers; **Sissin Hall** (Report Amended
12/30/2008)

Client No. / HGA	Lab No.	Asbestos Present	Total % Asbestos
1216-SIS-200-3 Location: Insulation Material / Basement Analyst Description: OffWhite, Homogeneous, Non-Fibrous, Cementitious, Bulk Material Asbestos Types: Chrysotile <1 % pc Other Material: Cellulose Trace, Fibrous glass Trace, Non-fibrous 100 %	208123749-11L1	Yes	Trace (<1 %) (by NYS ELAP 198.1) by Albert Grohmann on 12/30/08
1216-SIS-200-3 Location: Insulation Material / Basement - Mastlo material Analyst Description: Black, Homogeneous, Non-Fibrous, Bulk Material Asbestos Types: Other Material: Cellulose Trace, Fibrous glass Trace, Non-fibrous 100 %	208123749-11L2	No	NAD (by NYS ELAP 198.1) by Albert Grohmann on 12/30/08
1216-SIS-201A-1 Location: 1x1 Texture CT / 3rd Fl Hall Analyst Description: OffWhite, Homogeneous, Fibrous, Bulk Material Asbestos Types: Chrysotile <1 % pc Other Material: Cellulose Trace, Fibrous glass 85 %, Non-fibrous 15 %	208123749-12	Yes	Trace (<1 %) (by NYS ELAP 198.1) by Albert Grohmann on 12/30/08
1216-SIS-201A-2 Location: 1x1 Texture CT / 2nd Fl Hall Analyst Description: Grey, Homogeneous, Fibrous, Bulk Material Asbestos Types: Chrysotile <1 % pc Other Material: Cellulose Trace, Fibrous glass 85 %, Non-fibrous 15 %	208123749-13	Yes	Trace (<1 %) (by NYS ELAP 198.1) by Albert Grohmann on 12/30/08
1216-SIS-202-1 Location: 2x2 DOT CT / Rm 142 Analyst Description: White/Grey, Homogeneous, Fibrous, Bulk Material Asbestos Types: Other Material: Cellulose 45 %, Fibrous glass 40 %, Non-fibrous 15 %	208123749-14	No	NAD (by NYS ELAP 198.1) by Albert Grohmann on 12/30/08
1216-SIS-202-2 Location: 2x2 Dot CT / Rm 142 Analyst Description: White/Grey, Homogeneous, Fibrous, Bulk Material Asbestos Types: Other Material: Cellulose 45 %, Fibrous glass 40 %, Non-fibrous 15 %	208123749-15	No	NAD (by NYS ELAP 198.1) by Albert Grohmann on 12/30/08

See Reporting notes on last page

Received Time Dec. 30, 2008 2:44PM No. 2629

PLM Bulk Asbestos ReportSET 964; C&S Engineers; Sissin Hall (Report Amended
12/30/2008)

Client No. / HGA	Lab No.	Asbestos Present	Total % Asbestos
1216-SIS-203-1 Location: Textured Ceiling / Rm 5125 Analyst Description: White, Homogeneous, Non-Fibrous, Bulk Material Asbestos Types: Other Material: Non-fibrous 100 %	208123749-16	No	NAD (by NYS ELAP 198.1) by Albert Grohmann on 12/30/08
1216-SIS-203-2 Location: Textured Ceiling / Rm 5125 Analyst Description: White, Homogeneous, Non-Fibrous, Bulk Material Asbestos Types: Other Material: Non-fibrous 100 %	208123749-17	No	NAD (by NYS ELAP 198.1) by Albert Grohmann on 12/30/08
1216-SIS-203-3 Location: Textured Ceiling / Rm 5125 Analyst Description: White, Homogeneous, Non-Fibrous, Bulk Material Asbestos Types: Other Material: Non-fibrous 100 %	208123749-18	No	NAD (by NYS ELAP 198.1) by Albert Grohmann on 12/30/08

Reporting Notes:

Analyzed by: Albert Grohmann

*NAD/NSD = no asbestos detected; NA = not analyzed; NA/PS = not analyzed/positive stop; PLM Bulk Asbestos Analysis by EPA 600/M4-82-020 per 40 CFR 763 (NVLAP Lab Code 200546-0), ELAP PLM Method 198.1 for NY friable samples or 198.6 for NOR samples (NY ELAP Lab ID11480);

Note: PLM is not consistently reliable in detecting asbestos in floor coverings and similar non-friable organically bound materials. NAD or Trace results by PLM are inconclusive. TEM is currently the only method that can be used to determine if this material can be considered or treated as non asbestos-containing in NY State (also see EPA Advisory for floor tile, FR 59, 146,38970,8/1/94). National Institute of Standards and Technology Accreditation requirements mandate that this report must not be reproduced except in full without the approval of the lab. This PLM report relates ONLY to the items tested. AIHA Lab # 102843.

Reviewed By: _____

END OF REPORT _____

Received Time Dec. 30, 2008 2:44PM No. 2629



SIENNA ENVIRONMENTAL TECHNOLOGIES, LLC

429 Franklin St. • Suite 102 • Buffalo, NY 14202 • Ph: 716-332-3134 • Fax: 716-332-3136

LABORATORY REPORT

Attn: Jeffrey Robbins
C & S Engineers
499 Col. Eileen Collins Blvd
Syracuse, NY 13212
Phone: 315-455-2000 Fax: 315-455-9667
Project: SET954 **Slisson Hall**

Date Received: 12/30/2008
Date Analyzed: 12/31/2008
Sienna ID: P160

Polarized Light Microscopy (PLM) by NY State ELAP Method 198.1

Sample	Description	Location	% Fibrous	% Non-Fibrous	% Asbestos Type
1216-SIS-102-1 P160-9	White, Fibrous, Homogenous	Wallpaper - 3rd Floor Hall	5%	95%	NAD
1216-SIS-102-2 P160-10	White, Fibrous, Homogenous	Wallpaper - 2nd Floor Hall	5%	95%	NAD

Tracy Skalski
Analyst(s)


Approved Signatory

Disclaimers: NAD = No asbestos detected. Results relate only to samples provided by client. This report shall not be reproduced, except in full, without written approval by Sienna. Samples analyzed as NAD or Trace (<1%) cannot be guaranteed. Quantitative transmission electron microscopy is currently the only reliable method that can be used to determine if this material can be considered or treated as non-asbestos containing. Analysis performed by Sienna Environmental Technologies, NY ELAP #11727.



SIENNA ENVIRONMENTAL TECHNOLOGIES, LLC

429 Franklin St. · Suite 102 · Buffalo, NY 14202 · Ph: 716-332-3134 · Fax: 716-332-3136

LABORATORY REPORT

Attn: Jeffrey Robbins
C & S Engineers
499 Col. Eileen Collins Blvd
Syracuse, NY 13212
Phone: 315-455-2000 Fax: 315-455-9667
Project: SET954 **Slisson Hall**

Date Received: 12/30/2008
Date Analyzed: 12/31/2008
Sienna ID: P160

Polarized Light Microscopy (PLM) of Non-Friable, Organically Bound Materials by NY State ELAP Method 198.6

Sample	Description	Location	% Fibrous	% Non-Fibrous	% Asbestos Type
1216-SIS-201B-1 P160-16	Brown, Non-Fibrous, Homogenous	Glue Daubs of 201A - 2nd Floor Hall	0%	100%	Inconclusive: No Asbestos Detected
1216-SIS-201B-2 P160-17	Brown, Non-Fibrous, Homogenous	Glue Daubs of 201A - 2nd Floor Hall	0%	100%	Inconclusive: No Asbestos Detected

Tracy Skalski
Analyst(s)


Approved Signatory

Disclaimers: Polarized Light Microscopy is not consistently reliable in detecting asbestos in floor coverings and similar non-friable, organically-bound materials. Quantitative transmission electron microscopy is currently the only method that can be used to determine if this material can be considered or treated as non-asbestos containing. Results relate only to samples provided by client. This report shall not be reproduced, except in full, without written approval by Sienna. Analysis performed by Sienna Environmental Technologies, NY ELAP #11727.

Table I

Summary of Bulk Asbestos Analysis Results by NYS ELAP 198.4 NOB Method
SET 954; C&S Engineers; Sisson Hall

AmenSci Sample #	Client Sample#	HG Area	Sample Weight (gram)	Heat Sensitive Organic %	Acid Soluble Inorganic %	Insoluble Non-Asbestos Inorganic %	** Asbestos % by TEM
01	1216-SIS-201B-1		0.318	53.5	11.3	35.2	NAD
Location:	Glue Dabs Of 201A / 2nd Fl Hall						
02	1216-SIS-201B-2		0.256	52.3	16.4	31.3	NAD
Location:	Glue Dabs Of 201A / 2nd Fl Hall						

Analyzed by: Madell E. Collins; Data Analyzed 12/30/2008

**Quantitative Analysis (Semi/Full): Bulk Asbestos Analysis - PLM by EPA 600/4-92-020 per 40 CFR or ELAP 198.1 for New York triable samples or ELAP 198.6 for New York NOB samples; TEM (Semi/Full) by EPA 600/R-93/116 (not covered by NYLAP Bulk accreditation); or ELAP 198.4 for New York samples; NAD = no asbestos detected during a quantitative analysis; NA = not analyzed; Trace = <1%; Quantitation for beginning weights of <0.1 grams should be considered as qualitative only; Qualitative Analysis: Asbestos analysis results of "Present" or "NVA = No Visible Asbestos" represents results for Qualitative PLM or TEM Analysis only (no accreditation coverage available from any regulatory agency for qualitative analyses); AHA Lab # 102843, NYLAP Lab Code 200546-0, NYSDOH ELAP LAB ID 11480.

Warning Note: PLM limitation, only TEM will resolve fibers <0.25 micrometers in diameter. TEM bulk analysis is representative of the fine grained matrix material and may not be representative of non-uniformly dispersed debris for which PLM evaluation is recommended (i.e. soils and other heterogeneous materials).

Reviewed By: _____

SIENNA ENVIRONMENTAL TECHNOLOGIES, LLC

429 Franklin Street, Suite 102
Buffalo, NY 14202

Phone 716-332-3134
Fax 716-332-3136

Chain of Custody Document

Report to: _____

Client/Contact: <u>C.T.S Engineers - Jeffrey Robbins</u>		Turn around (circle)
Building/Location: <u>SISSON HALL</u>		
Job #: <u>SET954</u> Total # Samples: <u>22</u>		RUSH 48 Hour ☒ 24 Hour ☐ 72 Hour

☒ PLM ☐ TEM ☐ AAS ☐ OTHER _____

Sample #	Description of Sample	Location of Sample	Notes
1216-SIS-100A-1	Plaster skim coat	Basement	-1
1216-SIS-100A-2	Plaster skim coat	Rm 343	-2
1216-SIS-100A-3	Plaster skim coat	2nd fl. stairwell	-3
1216-SIS-100B-1	Plaster base coat	Basement	-4
1216-SIS-100B-2	Plaster base coat	Rm 343	-5
1216-SIS-100B-3	Plaster base coat	2nd fl. stairwell	-6
1216-SIS-101-1	lightweight concrete	3rd fl. hall	-7
1216-SIS-101-2	lightweight concrete	2nd fl. hall	-8
1216-SIS-102-1	wallpaper	3rd fl. hall	-9
1216-SIS-102-2	wallpaper	2nd fl. hall	-10
1216-SIS-200-1	Insulation material	Basement	-11
1216-SIS-200-2	Insulation material	Basement	-12
1216-SIS-200-3	Insulation material	Basement	-13
1216-SIS-201A-1	1x1 texture CT	3rd fl. hall	-14
1216-SIS-201A-2	1x1 texture CT	2nd fl. hall	-15
1216-SIS-201B-1	Glue daubs of 201A	2nd fl. hall	-16

Notes:

PS: 1 of 2

Sienna Environmental
Technologies
☒ Accept
☐ Reject

Sampled By: Paul J. Moring Date: 12/16/08
 Relinquished By: Paul J. Moring Date: _____
 Received By: Paul J. Moring Date: 12/30/08
 Received Time: Dec. 30, 2008 2:44PM No. 26295

SIENNA ENVIRONMENTAL TECHNOLOGIES, LLC

429 Franklin Street, Suite 102
Buffalo, NY 14202

Phone 716-332-3134
Fax 716-332-3136

Chain of Custody Document

x Report to: _____

Client/Contact: <u>C/S Engineers - Jeffrey Robbins</u>		Turn around (circle) RUSH 48 Hour 24 Hour 72 Hour
Building/Location: <u>SISSON HALL</u> <u>208123749</u>		
Job #: <u>SET954</u>	Total # Samples: <u>22</u>	

☒ PLM ☐ TEM ☐ AAS ☐ OTHER _____

Sample #	Description of Sample	Location of Sample	Notes
12110-SIS-201B-2	Glue daubs of 201A	2nd fl. hall	-17
12110-SIS-202-1	2x2 dot CT	Rm 142	-18
12110-SIS-202-2	2x2 dot CT	Rm 142	-19
12110-SIS-203-1	Textured ceiling	Rm S125	-20
12110-SIS-203-2	Textured ceiling	Rm S125	-21
12110-SIS-203-3	Textured ceiling	Rm S125	-22

Sienna Environmental
Technologies
☒ Accept
☐ Reject

Notes:

PS 2 of 2

Sampled By: Paul J. Mauer Date: 12/16/08
Relinquished By: Paul J. Mauer Date: _____
Received By: Paul J. Mauer Date: 12/30/08
Received Time: Dec. 30, 2008 2:44PM No. 26294



SIENNA ENVIRONMENTAL TECHNOLOGIES, LLC

429 Franklin St. · Suite 102 · Buffalo, NY 14202 · Ph: 716-332-3134 · Fax: 716-332-3136

LABORATORY REPORT

Attn: Jeffrey Robbins
C & S Engineers
499 Col. Eileen Collins Blvd
Syracuse, NY 13212
Phone: 315-455-2000 Fax: 315-455-9667
Project: SET954 SUNY Potsdam Brainerd Hall

Date Received: 12/18/2008
Date Analyzed: 12/26/2008
Sienna ID: P150

Polarized Light Microscopy (PLM) by NY State ELAP Method 198.1

Sample	Description	Location	% Fibrous	% Non-Fibrous	% Asbestos Type
1216-BRA-100A-1 P150-1	White, Non-Fibrous, Homogenous	Plaster Skim Coat - 2nd Floor Hall	0%	100%	NAD
1216-BRA-100A-2 P150-2	White, Non-Fibrous, Homogenous	Plaster Skim Coat - 2nd Floor Hall	0%	100%	NAD
1216-BRA-100A-3 P150-3	White, Non-Fibrous, Homogenous	Plaster Skim Coat - 1st Floor Hall	0%	100%	NAD
1216-BRA-202A-1 P150-4	White, Non-Fibrous, Homogenous	Plaster Skim Coat - 2nd Floor Hall	0%	100%	NAD
1216-BRA-202A-2 P150-5	White, Non-Fibrous, Homogenous	Plaster Skim Coat - 1st Floor Hall	0%	100%	NAD
1216-BRA-100B-1 P150-6	Gray, Non-Fibrous, Homogenous	Plaster Base Coat - 2nd Floor Hall	0%	100%	NAD
1216-BRA-100B-2 P150-7	Gray, Non-Fibrous, Homogenous	Plaster Base Coat - 2nd Floor Hall	0%	100%	NAD
1216-BRA-100B-3 P150-8	Gray, Non-Fibrous, Homogenous	Plaster Base Coat - 1st Floor Hall	0%	100%	NAD
1216-BRA-202B-1 P150-9	Gray, Non-Fibrous, Homogenous	Plaster Base Coat - 2nd Floor Hall	0%	100%	NAD
1216-BRA-202B-2 P150-10	Gray, Non-Fibrous, Homogenous	Plaster Base Coat - 1st Floor Hall	0%	100%	NAD
1216-BRA-101-1 P150-11	Gray, Non-Fibrous, Homogenous	Cinder Block Mortar - 1st Floor Hall	0%	100%	NAD
1216-BRA-101-2 P150-12	Gray, Non-Fibrous, Homogenous	Cinder Block Mortar - 1st Floor Electrical Room	5%	95%	NAD
1216-BRA-200-1 P150-13	Brown, Fibrous, Homogenous	2'x4' Dot Ceiling Tile - 2nd Floor Hall	40%	60%	NAD

Tracy Skalski
Analyst(s)

Approved Signatory

Disclaimers: NAD = No asbestos detected. Results relate only to samples provided by client. This report shall not be reproduced, except in full, without written approval by Sienna. Samples analyzed as NAD or Trace (<1%) cannot be guaranteed. Quantitative transmission electron microscopy is currently the only reliable method that can be used to determine if this material can be considered or treated as non-asbestos containing. Analysis performed by Sienna Environmental Technologies, NY ELAP #11727.



SIENNA ENVIRONMENTAL TECHNOLOGIES, LLC

429 Franklin St. · Suite 102 · Buffalo, NY 14202 · Ph: 716-332-3134 · Fax: 716-332-3136

LABORATORY REPORT

Attn: Jeffrey Robbins
C & S Engineers
499 Col. Eileen Collins Blvd
Syracuse, NY 13212

Date Received: 12/18/2008

Date Analyzed: 12/26/2008

Sienna ID: P150

Phone: 315-455-2000

Fax: 315-455-9667

Project: SET954 SUNY Potsdam Brainerd Hall

Polarized Light Microscopy (PLM) by NY State ELAP Method 198.1

Sample	Description	Location	% Fibrous	% Non-Fibrous	% Asbestos Type
1216-BRA-200-2 P150-14	Brown, Fibrous, Homogenous	2'x4' Dot Ceiling Tile - 2nd Floor Hall	30%	70%	NAD
1216-BRA-201-1 P150-15	White, Fibrous, Homogenous	Popcorn Ceiling Finish - 2nd Floor Art Room	80%	20%	NAD
1216-BRA-201-2 P150-16	White, Fibrous, Homogenous	Popcorn Ceiling Finish - 2nd Floor Art Room	70%	30%	NAD
1216-BRA-201-3 P150-17	White, Fibrous, Homogenous	Popcorn Ceiling Finish - 2nd Floor Art Room	90%	10%	NAD
1216-BRA-203A-1 P150-18	Gray, Non-Fibrous, Homogenous	Drywall - Room 125	5%	95%	NAD
1216-BRA-203A-2 P150-19	Gray, Non-Fibrous, Homogenous	Drywall - Room 125	5%	95%	NAD
1216-BRA-203B-1 P150-20	White, Non-Fibrous, Homogenous	Joint Compound - Room 125	5%	95%	NAD
1216-BRA-203B-2 P150-21	White, Non-Fibrous, Homogenous	Joint Compound - Room 125	5%	95%	NAD
1216-BRA-203B-3 P150-22	White, Non-Fibrous, Homogenous	Joint Compound - Room 125	0%	100%	NAD
1216-BRA-300-1 P150-23	Gray, Non-Fibrous, Homogenous	Brick Mortar - 2nd Floor Hall	0%	100%	NAD
1216-BRA-300-2 P150-24	Gray, Non-Fibrous, Homogenous	Brick Mortar - 2nd Floor Hall	0%	100%	NAD

Tracy Skalski
Analyst(s)


Approved Signatory

Disclaimers: NAD = No asbestos detected. Results relate only to samples provided by client. This report shall not be reproduced, except in full, without written approval by Sienna. Samples analyzed as NAD or Trace (<1%) cannot be guaranteed. Quantitative transmission electron microscopy is currently the only reliable method that can be used to determine if this material can be considered or treated as non-asbestos containing. Analysis performed by Sienna Environmental Technologies, NY ELAP #11727.

SIENNA ENVIRONMENTAL TECHNOLOGIES, LLC

429 Franklin Street, Suite 102
Buffalo, NY 14202

Phone 716-332-3134
Fax 716-332-3136

Chain of Custody Document

Test Report to: _____

Client/Contact: <u>C & S Engineers, Jeffrey Robbins</u>	Turn around (circle) RUSH 48 Hour 24 Hour 72 Hour
Building/Location: <u>Brainerd Hall SUNY Potsdam</u>	
Job #: <u>SET954</u> Total # Samples: <u>24</u>	

☒ PLM ☐ TEM ☐ AAS ☐ OTHER _____

2150

Sample #	Description of Sample	Location of Sample	Notes
1 1216-BRA-100A-1	Plaster skim coat	2nd floor hall	
2 1216-BRA-100A-2	Plaster skim coat	2nd floor hall	
3 1216-BRA-100A-3	Plaster skim coat	1st floor hall	
4 1216-BRA-202A-1	Plaster skim coat	2nd floor hall	
5 1216-BRA-202A-2	Plaster skim coat	1st floor hall	
6 1216-BRA-100B-1	Plaster base coat	2nd floor hall	
7 1216-BRA-100B-2	Plaster base coat	2nd floor hall	
8 1216-BRA-100B-3	Plaster base coat	1st floor hall	
9 1216-BRA-202B-1	Plaster base coat	2nd floor hall	
10 1216-BRA-202B-2	Plaster base coat	1st floor hall	
11 1216-BRA-101-1	Cinder block mortar	1st floor hall	
12 1216-BRA-101-2	Cinder block mortar	1st floor electrical room	
13 1216-BRA-200-1	2x4 dot ceiling tile	2nd floor hall	
14 1216-BRA-200-2	2x4 dot ceiling tile	2nd floor hall	
15 1216-BRA-201-1	Popcorn ceiling finish	2nd floor art room	
16 1216-BRA-201-2	Popcorn ceiling finish	2nd floor art room	

Notes:

Page 1 of 2

Sienna Environmental
Technologies

☒ Accept

☐ Reject

Sampled By:

Paul J. Moring

Date: 12/16/08

Relinquished By:

Paul J. Moring

Date:

Received By:

Date: 12/18/08 1500

DEA

SIENNA ENVIRONMENTAL TECHNOLOGIES, LLC

429 Franklin Street, Suite 102
Buffalo, NY 14202

Phone 716-332-3134
Fax 716-332-3136

Chain of Custody Document

Lab Report to: _____

Client/Contact: <u>C&S Engineers, Jeffrey Robbins</u>	Turn around (circle) RUSH 48 Hour 24 Hour 72 Hour
Building/Location: <u>Brainerd Hall, SUNY Potsdam</u>	
Job #: <u>SET 954</u> Total # Samples: <u>24</u>	

_____ PLM _____ TEM _____ AAS OTHER _____

Sample #	Description of Sample	Location of Sample	Notes
17 1216-BRA-201-3	Popcorn ceiling finish	2nd floor art room	
18 1216-BRA-203A-1	Drywall	Room 125	
19 1216-BRA-203A-2	Drywall	Room 125	
20 1216-BRA-203B-1	Joint compound	Room 125	
21 1216-BRA-203B-2	Joint compound	Room 125	
12 1216-BRA-203B-3	Joint compound	Room 125	
13 1216-BRA-300-1	Brick mortar	2nd floor hall	
14 1216-BRA-300-2	Brick mortar	2nd floor hall	

Sienna Environmental
Technologies

Notes: Page 2 of 2

Accept
Report

Sampled By: Paul J. Mair Date: 12/16/08
Relinquished By: Paul J. Mair Date: _____
Received By: [Signature] Date: 12/18/08 1500
D1510



SIENNA ENVIRONMENTAL TECHNOLOGIES, LLC

429 Franklin St. · Suite 102 · Buffalo, NY 14202 · Ph: 716-332-3134 · Fax: 716-332-3136

LABORATORY REPORT

Attn: Jeffrey Robbins
C & S Engineers
499 Col. Eileen Collins Blvd
Syracuse, NY 13212

Date Received: 12/18/2008

Date Analyzed: 12/26/2008

Sienna ID: P149

Phone: 315-455-2000

Fax: 315-455-9667

Project: SET954 Barrington Student Union

Polarized Light Microscopy (PLM) by NY State ELAP Method 198.1

Sample	Description	Location	% Fibrous	% Non-Fibrous	% Asbestos Type
1216-BAR-100A-1 P149-1	White, Non-Fibrous, Homogenous	Skim Coat Plaster - Mallroom Hall	0%	100%	NAD
1216-BAR-100A-2 P149-2	White, Non-Fibrous, Homogenous	Skim Coat Plaster - Dining Court	0%	100%	NAD
1216-BAR-100A-3 P149-3	White, Non-Fibrous, Homogenous	Skim Coat Plaster - 2nd Fl Corridor	0%	100%	NAD
1216-BAR-100A-4 P149-4	White, Non-Fibrous, Homogenous	Skim Coat Plaster - 2nd Fl Corridor	0%	100%	NAD
1216-BAR-100A-5 P149-5	White, Non-Fibrous, Homogenous	Skim Coat Plaster - Fireside Lounge	0%	100%	NAD
1216-BAR-100B-1 P149-6	Gray, Non-Fibrous, Homogenous	Base Coat Plaster - Mallroom Hall	0%	100%	NAD
1216-BAR-100B-2 P149-7	Gray, Non-Fibrous, Homogenous	Base Coat Plaster - Dining Court	0%	100%	NAD
1216-BAR-100B-3 P149-8	Gray, Non-Fibrous, Homogenous	Base Coat Plaster - 2nd Fl Corridor	0%	100%	NAD
1216-BAR-100B-4 P149-9	Gray, Non-Fibrous, Homogenous	Base Coat Plaster - 2nd Fl Corridor	0%	100%	NAD
1216-BAR-100B-5 P149-10	Gray, Non-Fibrous, Homogenous	Base Coat Plaster - Fireside Lounge	0%	100%	NAD
1216-BAR-101A-1 P149-11	Gray, Fibrous, Non- Homogenous	Drywall - Convenience Store	20%	80%	NAD
1216-BAR-101A-2 P149-12	Gray, Fibrous, Homogenous	Drywall - Convenience Store	5%	95%	NAD
1216-BAR-101B-1 P149-13	White, Non-Fibrous, Homogenous	Joint Compound - Convenience Store	0%	100%	NAD

Tracy Skalski
Analyst(s)

Approved Signatory

Disclaimers: NAD = No asbestos detected. Results relate only to samples provided by client. This report shall not be reproduced, except in full, without written approval by Sienna. Samples analyzed as NAD or Trace (<1%) cannot be guaranteed. Quantitative transmission electron microscopy is currently the only reliable method that can be used to determine if this material can be considered or treated as non-asbestos containing. Analysis performed by Sienna Environmental Technologies, NY ELAP #11727.



SIENNA ENVIRONMENTAL TECHNOLOGIES, LLC

429 Franklin St. · Suite 102 · Buffalo, NY 14202 · Ph: 716-332-3134 · Fax: 716-332-3136

LABORATORY REPORT

Attn: Jeffrey Robbins
C & S Engineers
499 Col. Eileen Collins Blvd
Syracuse, NY 13212
Phone: 315-455-2000 Fax: 315-455-9687
Project: SET954 Barrington Student Union

Date Received: 12/18/2008
Date Analyzed: 12/26/2008
Sienna ID: P149

Polarized Light Microscopy (PLM) by NY State ELAP Method 198.1

Sample	Description	Location	% Fibrous	% Non-Fibrous	% Asbestos Type
1216-BAR-101B-2 P149-14	White, Non-Fibrous, Homogenous	Joint Compound - Convenience Store	0%	100%	NAD
1216-BAR-102-1 P149-15	White, Fibrous, Homogenous	Wallpaper - 2nd Fl Rm B	0%	100%	NAD
1216-BAR-102-2 P149-16	White, Fibrous, Homogenous	Wallpaper - 2nd Fl Rm B	0%	100%	NAD
1216-BAR-103-1 P149-17	Gray, Non-Fibrous, Homogenous	Cinder Block Mortar - Attic	5%	95%	NAD
1216-BAR-103-2 P149-18	Gray, Non-Fibrous, Homogenous	Cinder Block Mortar - Attic	0%	100%	NAD
1216-BAR-200-1 P149-19	Gray, Fibrous, Homogenous	2x4 Dot & Fissure CT - Mailroom Corridor	70%	30%	NAD
1216-BAR-200-2 P149-20	Gray, Fibrous, Homogenous	2x4 Dot & Fissure CT - Mailroom Corridor	70%	30%	NAD
1216-BAR-201-1 P149-21	Tan, Fibrous, Homogenous	2x2 Dot & Fissure CT - Bookstore	80%	20%	NAD
1216-BAR-201-2 P149-22	Tan, Fibrous, Homogenous	2x2 Dot & Fissure CT - Bookstore	75%	25%	NAD
1216-BAR-202-1 P149-23	Brown, Fibrous, Non- Homogenous	2x2 Smooth CT - Dining Rm	40%	60%	NAD
1216-BAR-202-2 P149-24	Brown, Fibrous, Homogenous	2x2 Smooth CT - Dining Rm	20%	80%	NAD
1216-BAR-203-1 P149-25	Gray, Fibrous, Homogenous	1x1 Ceiling Tile - Dining Rm	30%	70%	NAD
1216-BAR-203-2 P149-26	Gray, Fibrous, Homogenous	1x1 Ceiling Tile - Dining Rm	70%	30%	NAD

Tracy Skalski
Analyst(s)

Approved Signatory

Disclaimers: NAD = No asbestos detected. Results relate only to samples provided by client. This report shall not be reproduced, except in full, without written approval by Sienna. Samples analyzed as NAD or Trace (<1%) cannot be guaranteed. Quantitative transmission electron microscopy is currently the only reliable method that can be used to determine if this material can be considered or treated as non-asbestos containing. Analysis performed by Sienna Environmental Technologies, NY ELAP #11727.



SIENNA ENVIRONMENTAL TECHNOLOGIES, LLC

429 Franklin St. · Suite 102 · Buffalo, NY 14202 · Ph: 716-332-3134 · Fax: 716-332-3136

LABORATORY REPORT

Attn: Jeffrey Robbins
C & S Engineers
499 Col. Eileen Collins Blvd
Syracuse, NY 13212
Phone: 315-455-2000 Fax: 315-455-9667
Project: SET954 Barrington Student Union

Date Received: 12/18/2008
Date Analyzed: 12/26/2008
Sienna ID: P149

Polarized Light Microscopy (PLM) by NY State ELAP Method 198.1

Sample	Description	Location	% Fibrous	% Non-Fibrous	% Asbestos Type
1216-BAR-204-1 P149-27	Tan, Fibrous, Homogenous	Popcorn Ceiling - Fireside Lounge	5%	95%	NAD
1216-BAR-204-2 P149-28	Tan, Fibrous, Homogenous	Popcorn Ceiling - Fireside Lounge	0%	100%	NAD
1216-BAR-204-3 P149-29	Tan, Fibrous, Homogenous	Popcorn Ceiling - Fireside Lounge	0%	100%	NAD

Tracy Skalski
Analyst(s)

Approved Signatory

Disclaimers: NAD = No asbestos detected. Results relate only to samples provided by client. This report shall not be reproduced, except in full, without written approval by Sienna. Samples analyzed as NAD or Trace (<1%) cannot be guaranteed. Quantitative transmission electron microscopy is currently the only reliable method that can be used to determine if this material can be considered or treated as non-asbestos containing. Analysis performed by Sienna Environmental Technologies, NY ELAP #11727.

SIENNA ENVIRONMENTAL TECHNOLOGIES, LLC

429 Franklin Street, Suite 102
Buffalo, NY 14202

Phone 716-332-3134
Fax 716-332-3136

Chain of Custody Document

x Report to: _____

Client/Contact: <u>C/S Engineers - Jeffrey Robbins</u>		Turn around (circle) RUSH 48 Hour 24 Hour 72 Hour
Building/Location: <u>BARRINGTON STUDENT UNION</u>		
Job #: <u>SET954</u>	Total # Samples: <u>29</u>	

☒ PLM ☐ TEM ☐ AAS ☐ OTHER _____

0149

Sample #	Description of Sample	Location of Sample	Notes
1 1216-BAR-100A-1	Skim coat plaster	Mailroom Hall	
2 1216-BAR-100A-2	Skim coat plaster	Dining Court	
3 1216-BAR-100A-3	Skim coat plaster	2nd fl. Corridor	
4 1216-BAR-100A-4	Skim coat plaster	2nd fl. Corridor	
5 1216-BAR-100A-5	Skim coat plaster	Fire side Lounge	
6 1216-BAR-100B-1	Base coat plaster	Mailroom Hall	
7 1216-BAR-100B-2	Base coat plaster	Dining Court	
8 1216-BAR-100B-3	Base coat plaster	2nd fl. Corridor	
9 1216-BAR-100B-4	Base coat plaster	2nd fl. Corridor	
10 1216-BAR-100B-5	Base coat plaster	Fire side lounge	
11 1216-BAR-101A-1	Dry wall	Convenience Store	
12 1216-BAR-101A-2	Dry wall	Convenience Store	
13 1216-BAR-101B-1	Joint Compound	Convenience Store	
14 1216-BAR-101B-2	Joint Compound	Convenience Store	
15 1216-BAR-102-1	Wallpaper	2nd fl. Rm B	
16 1216-BAR-102-2	Wallpaper	2nd fl. Rm. B	

Notes:

PS 1 of 2
Environmental Technologies
☒ Accept
☐ Reject

Sampled By: Paul J. Manning Date: 12/16/08
Relinquished By: Paul J. Manning Date: _____
Received By: [Signature] Date: 12/18/08 8500
P149

SIENNA ENVIRONMENTAL TECHNOLOGIES, LLC

429 Franklin Street, Suite 102
Buffalo, NY 14202

Phone 716-332-3134
Fax 716-332-3136

Chain of Custody Document

x Report to: _____

Client/Contact: <u>C/S Engineers - Jeffrey Robbins</u>		Turn around (circle) RUSH 48 Hour 24 Hour 72 Hour
Building/Location: <u>BARRINGTON STUDENT UNION</u>		
Job #: <u>SET 954</u>	Total # Samples: <u>29</u>	

X PLM _____ TEM _____ AAS _____ OTHER _____

2149

Sample #	Description of Sample	Location of Sample	Notes
17 1216-BAR-103-1	Cinder Block mortar	Attic	
18 1216-BAR-103-2	Cinder block mortar	Attic	
19 1216-BAR-200-1	2x4 dot & fissure CT	Mailroom corridor	
20 1216-BAR-200-2	2x4 dot & fissure CT	Mailroom corridor	
21 1216-BAR-201-1	2x2 dot & fissure CT	Bookstore	
22 1216-BAR-201-2	2x2 dot & fissure CT	Bookstore	
23 1216-BAR-202-1	2x2 smooth CT	Dining Rm.	
24 1216-BAR-202-2	2x2 smooth CT	Dining Rm.	
25 1216-BAR-203-1	1x1 ceiling tile	Dining Rm.	
26 1216-BAR-203-2	1x1 ceiling tile	Dining Rm.	
27 1216-BAR-204-1	Popcorn Ceiling	Fire side lounge	
28 1216-BAR-204-2	Popcorn Ceiling	Fire side lounge	
29 1216-BAR-204-3	Popcorn Ceiling	Fire side lounge	

Notes:

PS 20f2

Sienna Environmental
Technologies

☒ Accept
☐ Reject

Sampled By: Paul J. Marry

Date: 12/16/08

Relinquished By: Paul J. Marry

Date:

Received By: _____

Date: 12/18/08 1500

2149



SIENNA ENVIRONMENTAL TECHNOLOGIES, LLC

429 Franklin St. · Suite 102 · Buffalo, NY 14202 · Ph: 716-332-3134 · Fax: 716-332-3136

LABORATORY REPORT

Attn: Jeffrey Robbins
C & S Engineers
499 Col. Eileen Collins Blvd
Syracuse, NY 13212

Date Received: 12/18/2008

Date Analyzed: 12/31/2008

Sienna ID: P158

Phone: 315-455-2000


Fax: 315-455-9667

Project: SET954 Merritt Hall

Polarized Light Microscopy (PLM) by NY State ELAP Method 198.1

Sample	Description	Location	% Fibrous	% Non-Fibrous	% Asbestos Type
1217-MER-100A-1 P158-1	Gray, Fibrous, Non-Homogenous	Plaster Skim Coat - Room 129	0%	100%	NAD
1217-MER-100A-2 P158-2	Gray, Non-Fibrous, Homogenous	Plaster Skim Coat - 2nd Floor Hall	0%	100%	NAD
1217-MER-100A-3 P158-3	Gray, Non-Fibrous, Homogenous	Plaster Skim Coat - 3rd Floor Hall	0%	100%	NAD
1217-MER-200A-1 P158-4	White, Non-Fibrous, Homogenous	Plaster Skim Coat - 1st Floor Custodial Room	5%	95%	NAD
1217-MER-200A-2 P158-5	White, Non-Fibrous, Homogenous	Plaster Skim Coat - 1st Floor Hall	0%	100%	NAD
1217-MER-100B-1 P158-6	Gray, Non-Fibrous, Homogenous	Plaster Base Coat - Room 129	0%	100%	NAD
1217-MER-100B-2 P158-7	White, Non-Fibrous, Homogenous	Plaster Base Coat - 2nd Floor Hall	0%	100%	NAD
1217-MER-100B-3 P158-8	Gray, Non-Fibrous, Homogenous	Plaster Base Coat - 3rd Floor Hall	0%	100%	NAD
1217-MER-200B-1 P158-9	Gray, Non-Fibrous, Homogenous	Plaster Base Coat - 1st Floor Custodial Room	0%	100%	NAD
1217-MER-200B-2 P158-10	Gray, Non-Fibrous, Homogenous	Plaster Base Coat - 1st Floor Hall	0%	100%	NAD
1217-MER-101-1 P158-11	Gray, Non-Fibrous, Homogenous	Glazed Block Mortar - Computer Lab	0%	100%	NAD
1217-MER-101-2 P158-12	Gray, Non-Fibrous, Homogenous	Glazed Block Mortar - Room 213 Storage	5%	95%	NAD
1217-MER-102A-1 P158-13	White, Fibrous, Homogenous	Drywall - 2nd Floor Storage	10%	90%	NAD

Tracy Skalski
Analyst(s)

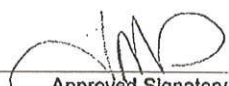
Approved Signatory

Disclaimers: NAD = No asbestos detected. Results relate only to samples provided by client. This report shall not be reproduced, except in full, without written approval by Sienna. Samples analyzed as NAD or Trace (<1%) cannot be guaranteed. Quantitative transmission electron microscopy is currently the only reliable method that can be used to determine if this material can be considered or treated as non-asbestos containing. Analysis performed by Sienna Environmental Technologies, NY ELAP #11727.



SIENNA ENVIRONMENTAL TECHNOLOGIES, LLC

429 Franklin St. • Suite 102 • Buffalo, NY 14202 • Ph: 716-332-3134 • Fax: 716-332-3136

LABORATORY REPORT

Attn: Jeffrey Robbins
C & S Engineers
499 Col. Eileen Collins Blvd
Syracuse, NY 13212

Date Received: 12/18/2008

Date Analyzed: 12/31/2008

Sienna ID: P158

Phone: 315-455-2000

Fax: 315-455-9667

Project: SET954 Merritt Hall

Polarized Light Microscopy (PLM) by NY State ELAP Method 198.1

Sample	Description	Location	% Fibrous	% Non-Fibrous	% Asbestos Type
1217-MER-102A-2 P158-14	White, Fibrous, Homogenous	Drywall - 2nd Floor Hall	5%	95%	NAD
1217-MER-102B-1 P158-15	White, Fibrous, Homogenous	Joint Compound - 2nd Floor Storage	0%	100%	NAD
1217-MER-102B-2 P158-16	White, Non-Fibrous, Homogenous	Joint Compound - 2nd Floor Hall	0%	100%	NAD
1217-MER-102B-3 P158-17	White, Non-Fibrous, Homogenous	Joint Compound - 2nd Floor Hall	0%	100%	NAD
1217-MER-103A-1 P158-18	White, Non-Fibrous, Homogenous	Grout of Ceramic Tile - Men's Locker Room	0%	100%	NAD
1217-MER-103A-2 P158-19	White, Non-Fibrous, Homogenous	Grout of Ceramic Tile - Men's Locker Room	0%	100%	NAD
1217-MER-103B-1 P158-20	Gray, Non-Fibrous, Homogenous	Thinset of Ceramic Tile - Men's Locker Room	5%	95%	NAD
1217-MER-103B-2 P158-21	Gray, Non-Fibrous, Homogenous	Thinset of Ceramic Tile - Men's Locker Room	0%	100%	NAD
1217-MER-104-1 P158-22	Gray, Non-Fibrous, Homogenous	Cinder Block Mortar - Basement	0%	100%	NAD
1217-MER-104-2 P158-23	Gray, Non-Fibrous, Homogenous	Cinder Block Mortar - Basement	0%	100%	NAD
1217-MER-105-1 P158-24	White, Non-Fibrous, Homogenous	Textured Wall Finish - Room 213 Storage	5%	95%	NAD
1217-MER-105-2 P158-25	White, Non-Fibrous, Homogenous	Textured Wall Finish - Room 213 Storage	5%	95%	NAD
1217-MER-105-3 P158-26	White, Non-Fibrous, Homogenous	Textured Wall Finish - Room 213 Storage	5%	95%	NAD

Tracy Skalski
Analyst(s)


Approved Signatory

Disclaimer: NAD = No asbestos detected. Results relate only to samples provided by client. This report shall not be reproduced, except in full, without written approval by Sienna. Samples analyzed as NAD or Trace (<1%) cannot be guaranteed. Quantitative transmission electron microscopy is currently the only reliable method that can be used to determine if this material can be considered or treated as non-asbestos containing. Analysis performed by Sienna Environmental Technologies, NY ELAP #11727.



SIENNA ENVIRONMENTAL TECHNOLOGIES, LLC

429 Franklin St. · Suite 102 · Buffalo, NY 14202 · Ph: 716-332-3134 · Fax: 716-332-3136

LABORATORY REPORT

Attn: Jeffrey Robbins
C & S Engineers
499 Col. Eileen Collins Blvd
Syracuse, NY 13212

Date Received: 12/18/2008

Date Analyzed: 12/31/2008

Sienna ID: P158

Phone: 315-455-2000

Fax: 315-455-9667

Project: SET954 Merritt Hall

Polarized Light Microscopy (PLM) by NY State ELAP Method 198.1

Sample	Description	Location	% Fibrous	% Non-Fibrous	% Asbestos Type
1217-MER-201A-1 P158-27	Brown / White, Fibrous, Non-Homogenous	1'x1' Dot Ceiling Tile - 1st Floor Hall	10%	90%	NAD
1217-MER-201A-2 P158-28	Brown / White, Fibrous, Non-Homogenous	1'x1' Dot Ceiling Tile - 1st Floor Hall	20%	80%	NAD
1217-MER-202-1 P158-31	Gray, Fibrous, Homogenous	2'x2' Cementitious Tile - Pool	10%	90%	8.2% Chrysotile
1217-MER-202-2 P158-32	Gray, Fibrous, Homogenous	2'x2' Cementitious Tile - Pool <i>ceiling tile</i>	10%	90%	8.2% Chrysotile
1217-MER-203-1 P158-33	Gray / White, Fibrous, Non-Homogenous	2'x4' Dot and Fissure Ceiling Tile - Daycare	50%	50%	NAD
1217-MER-203-2 P158-34	Gray / White, Fibrous, Non-Homogenous	2'x4' Dot and Fissure Ceiling Tile - Daycare	50%	50%	NAD
1217-MER-301-1 P158-39	Brown, Non-Fibrous, Non-Homogenous	Terrazzo - 3rd Floor Hall	0%	100%	NAD
1217-MER-301-2 P158-40	Brown, Non-Fibrous, Non-Homogenous	Terrazzo - 3rd Floor Hall	0%	100%	NAD

Tracy Skalski
Analyst(s)


Approved Signatory

Disclaimers: NAD = No asbestos detected. Results relate only to samples provided by client. This report shall not be reproduced, except in full, without written approval by Sienna. Samples analyzed as NAD or Trace (<1%) cannot be guaranteed. Quantitative transmission electron microscopy is currently the only reliable method that can be used to determine if this material can be considered or treated as non-asbestos containing. Analysis performed by Sienna Environmental Technologies, NY ELAP #11727.



SIENNA ENVIRONMENTAL TECHNOLOGIES, LLC

429 Franklin St. • Suite 102 • Buffalo, NY 14202 • Ph: 716-332-3134 • Fax: 716-332-3136

LABORATORY REPORT

Attn: Jeffrey Robbins
C & S Engineers
499 Col. Eileen Collins Blvd
Syracuse, NY 13212
Phone: 315-455-2000 Fax: 315-455-9667
Project: SET954 Merritt Hall

Date Received: 12/18/2008
Date Analyzed: 12/31/2008
Sienna ID: P158

Polarized Light Microscopy (PLM) of Non-Friable, Organically Bound Materials by NY State ELAP Method 198.6

Sample	Description	Location	% Fibrous	% Non-Fibrous	% Asbestos Type
1217-MER-201B-1 P158-29	Brown, Fibrous, Non-Homogenous	Glue of 1'x1' Dot Ceiling Tile - 1st Floor Hall	0%	100%	Inconclusive: No Asbestos Detected
1217-MER-201B-2 P158-30	Brown, Fibrous, Non-Homogenous	Glue of 1'x1' Dot Ceiling Tile - 1st Floor Hall	0%	100%	Inconclusive: No Asbestos Detected
1217-MER-300A-1 P158-35	Black, Non-Fibrous, Homogenous	18"x6" Floor Tile - Women's Locker Room	10%	90%	6.8% Chrysotile
1217-MER-300A-1 P158-36	Black, Non-Fibrous, Homogenous	18"x6" Floor Tile - Women's Locker Room	20%	80%	12.5% Chrysotile
1217-MER-300B-1 P158-37	Black, Non-Fibrous, Homogenous	Mastic of 18"x6" Floor Tile - Women's Locker Room	5%	95%	Inconclusive: No Asbestos Detected
1217-MER-300B-2 P158-38	Black, Non-Fibrous, Homogenous	Mastic of 18"x6" Floor Tile - Women's Locker Room	5%	95%	1.3% Chrysotile

Tracy Skalski
Analyst(s)

Approved Signatory

Disclaimers: Polarized Light Microscopy is not consistently reliable in detecting asbestos in floor coverings and similar non-friable, organically-bound materials. Quantitative transmission electron microscopy is currently the only method that can be used to determine if this material can be considered or treated as non-asbestos containing. Results relate only to samples provided by client. This report shall not be reproduced, except in full, without written approval by Sienna. Analysis performed by Sienna Environmental Technologies, NY ELAP #11727.

Table 1

Summary of Bulk Asbestos Analysis Results by NYS ELAP 198.4 NOB Method

SET 954; C&S Engineers; Merritt Hall / SUNY Potsdam

AmeriSci Sample #	Client Sample#	HG Area	Sample Weight (gram)	Heat Sensitive Organic %	Acid Soluble Inorganic %	Insoluble Non-Asbestos Inorganic %	** Asbestos % by TEM
D1	1217-MER-201B-1		0.890	50.7	6.4	42.9	NAD
Location: Glue Dob Of 201A / 1st Floor Hall							
D2	1217-MER-201B-2		0.340	50.3	7.4	42.4	NAD
Location: Glue Dob Of 201A / 1st Floor Hall							

Analyzed by: Madell E. Collins *Madell E. Collins* Date Analyzed: 12/30/2008

**Quantitative Analysis (Semi-Full): Bulk Asbestos Analysis - PLM by EPA 800/M4-82-020 per 40 CFR or ELAP 198.1 for New York (soluble samples or ELAP 198.6 for New York NOB samples; TEM (Semi-Full) by EPA 800/R-93/116 (not covered by NVLAP Bulk accreditation); or ELAP 198.4 for New York samples; NAD = no asbestos detected during a quantitative analysis; NA = not analyzed; Trace = <1%; Quantification for beginning weights of <0.1 grams should be considered as qualitative only. Qualitative Analysis: Asbestos analysis results of "Present" or "N/A" = No Visible Asbestos; represents results for Qualitative PLM or TEM Analysis only (no accreditation coverage available from any regulatory agency for qualitative analyses); AIHA Lab # 102843, NVLAP Lab Code 200543-Q, NYSDOH ELAP LAB ID 11480.

Warning Note: PLM limitation: only TEM will resolve fibers <0.25 micrometers in diameter. TEM bulk analysis is representative of the fine grained matrix material and may not be representative of non-uniformly dispersed debris for which PLM evaluation is recommended (i.e. soils and other heterogeneous materials).

Reviewed By: _____

SIENNA ENVIRONMENTAL TECHNOLOGIES, LLC

429 Franklin Street, Suite 102
Buffalo, NY 14202

Phone 716-332-3134
Fax 716-332-3136

Chain of Custody Document

Report to: _____

Client/Contact: <u>C & S Engineer, Jeffrey Robbins</u>	Turn around (circle) RUSH 48 Hour 24 Hour 72 Hour
Building/Location: <u>Merritt Hall, SUNY Potsdam</u>	
Job #: <u>SET954</u> Total # Samples: <u>20</u>	

☒ PLM ☒ TEM ☐ AAS ☐ OTHER _____

Sample #	Description of Sample	Location of Sample	Notes
1217-MER-100A-1	Plaster skim coat	Room 129	PSS-1
1217-MER-100A-2	Plaster skim coat	2nd floor hall	-2
1217-MER-100A-3	Plaster skim coat	3rd floor hall	-3
1217-MER-200A-1	Plaster skim coat	1st floor custodial	-4
1217-MER-200A-2	Plaster skim coat	1st floor hall	-5
1217-MER-100B-1	Plaster base coat	Room 129	-6
1217-MER-100B-2	Plaster base coat	2nd floor hall	-7
1217-MER-100B-3	Plaster base coat	3rd floor hall	-8
1217-MER-200B-1	Plaster base coat	1st floor custodial	-9
1217-MER-200B-2	Plaster base coat	1st floor hall	-10
1217-MER-101-1	Computer Lab Glazed block mortar	Computer lab	-11
1217-MER-101-2	Glazed block mortar	Room 213 storage	-12
1217-MER-102A-1	Drywall	2nd floor storage	-13
1217-MER-102A-2	Drywall	2nd floor hall	-14
1217-MER-102B-1	Joint compound	2nd floor storage	-15
1217-MER-102B-2	Joint compound	2nd floor hall	PSS-16

Notes:

Page 1 of 2

Sienna Environmental
Technologies

Sampled By: Paul / Mary

Relinquished By: Paul / Mary

Received By: Stas

☒ Accept
☐ Reject

Date: 12/17/08

Date: _____

Date: 12/18/08

SIENNA ENVIRONMENTAL TECHNOLOGIES, LLC

429 Franklin Street, Suite 102
Buffalo, NY 14202

Phone 716-332-3134
Fax 716-332-3136

Chain of Custody Document

Report to: _____

Client/Contact: <u>C & S Engineers, Jeffrey Robbins</u>		Turn around (circle) RUSH 48 Hour 24 Hour 72 Hour
Building/Location: <u>Merritt Hall / SUNY Potsdam</u>		
Job #: <u>SET954</u>	Total # Samples: <u>40</u>	

☒ PLM ☒ TEM ☐ AAS ☐ OTHER _____

Sample #	Description of Sample	Location of Sample	Notes
1217-MER-102B-3	Joint compound	2nd floor hall	P158-17
1217-MER-103A-1	Grout of ceramic tile	Men's locker room	-18
1217-MER-103A-2	Grout of ceramic tile	Men's locker room	-19
1217-MER-103B-1	Thinset of ceramic tile	Men's locker room	-20
1217-MER-103B-2	Thinset of ceramic tile	Men's locker room	-21
1217-MER-104-1	Cinder block mortar	Basement	-22
1217-MER-104-2	Cinder block mortar	Basement	-23
1217-MER-105-1	Textured wall finish	Room 213 storage	-24
1217-MER-105-2	Textured wall finish	Room 213 storage	-25
1217-MER-105-3	Textured wall finish	Room 213 storage	-26
1217-MER-201A-1	1x1 dot ceiling tile	1st floor hall	-27
1217-MER-201A-2	1x1 dot ceiling tile	1st floor hall	-28
1217-MER-201B-1	Glue job of 201A	1st floor hall	-29
1217-MER-201B-2	Glue job of 201A	1st floor hall	-30
1217-MER-202-1	2x2 cementitious tile	Pool	-31
1217-MER-202-2	2x2 cementitious tile	Pool	P158-32

Notes:

Page 2 of 3

Sienna Environmental
Technologies

☒ Accept

☐ Reject

Neg NOBs by PLM
for TEM

Sampled By:

Paul J. Main

Date: 12/17/08

Relinquished By:

Paul J. Main

Date: _____

Received By:

J. Stead 1800

P158

Date: 12/18/08

SIENNA ENVIRONMENTAL TECHNOLOGIES, LLC

429 Franklin Street, Suite 102
Buffalo, NY 14202

Phone 716-332-3134

Fax 716-332-3136

Chain of Custody Document

Report to: _____

Client/Contact: <u>C & S Engineers, Jeffrey Robbins</u>	Turn around (circle) RUSH 48 Hour 24 Hour 72 Hour
Building/Location: <u>Merritt Hall, SUNY Potsdam</u>	
Job #: <u>SET954</u> Total # Samples: <u>10</u>	

☒ PLM ☒ TEM ☐ AAS ☐ OTHER _____

Sample #	Description of Sample	Location of Sample	Notes
1217-MER-203-1	2x4 dot + fissure ceiling tile	Daycare	P158-33
1217-MER-203-2	2x4 dot + fissure ceiling tile	Daycare	-34
1217-MER-300A-1	18x6 Black floor tile	Women's locker room	-35
1217-MER-300A-2	18x6 Black floor tile	Women's locker room	-36
1217-MER-300B-1	Black mastic of 300A	Women's locker room	-37
1217-MER-300B-2	Black mastic of 300A	Women's locker room	-38
1217-MER-301-1	Terrazzo	3rd floor hall	-39
1217-MER-301-2	Terrazzo	3rd floor hall	P158-40

Sienna Environmental
Technologies
☒ Accept
☐ Reject

Notes: Page 3 of 3

Sampled By: Paul J. Maury Date: 12/17/08
Relinquished By: Paul J. Maury Date: _____
Received By: E. Skorski 1800 P158 Date: 12/18/08



SIENNA ENVIRONMENTAL TECHNOLOGIES, LLC

429 Franklin St. • Suite 102 • Buffalo, NY 14202 • Ph: 716-332-3134 • Fax: 716-332-3136

LABORATORY REPORT

Attn: Jeffrey Robbins
C & S Engineers
499 Col. Eileen Collins Blvd
Syracuse, NY 13212
Phone: 315-455-2000 Fax: 315-455-9667
Project: SET954 Maxcy Hall

Date Received: 12/18/2008
Date Analyzed: 12/29/2008
Sienna ID: P157

Polarized Light Microscopy (PLM) by NY State ELAP Method 198.1

Sample	Description	Location	% Fibrous	% Non-Fibrous	% Asbestos Type
1217-MAX-100-1 P157-1	Gray, Non-Fibrous, Homogenous	Cinder Block Mortar - 1st Floor Hall	0%	100%	NAD
1217-MAX-100-2 P157-2	Gray, Non-Fibrous, Homogenous	Cinder Block Mortar - Basement Stairwell	0%	100%	NAD
1217-MAX-101-1 P157-3	Brown, Non-Fibrous, Homogenous	Brick Mortar - 1st Floor Foyer	0%	100%	NAD
1217-MAX-101-2 P157-4	Brown, Non-Fibrous, Homogenous	Brick Mortar - 1st Floor Foyer	0%	100%	NAD
1217-MAX-200-1 P157-5	Gray, Non-Fibrous, Homogenous	2'x4' Dot Ceiling Tile - Ladies' Locker Room	40%	60%	NAD
1217-MAX-200-2 P157-6	Gray, Non-Fibrous, Homogenous	2'x4' Dot Ceiling Tile - Ladies' Locker Room	70%	30%	NAD
1217-MAX-201-1 P157-7	White, Non-Fibrous, Homogenous	Popcorn Ceiling - 1st Floor Foyer	0%	100%	NAD
1217-MAX-201-2 P157-8	White, Non-Fibrous, Homogenous	Popcorn Ceiling - 1st Floor Foyer	0%	100%	NAD
1217-MAX-201-3 P157-9	White, Non-Fibrous, Homogenous	Popcorn Ceiling - 1st Floor Foyer	0%	100%	NAD

Tracy Skalski
Analyst(s)


Approved Signatory

Disclaimers: NAD = No asbestos detected. Results relate only to samples provided by client. This report shall not be reproduced, except in full, without written approval by Sienna. Samples analyzed as NAD or Trace (<1%) cannot be guaranteed. Quantitative transmission electron microscopy is currently the only reliable method that can be used to determine if this material can be considered or treated as non-asbestos containing. Analysis performed by Sienna Environmental Technologies, NY ELAP #11727.

SIENNA ENVIRONMENTAL TECHNOLOGIES, LLC

429 Franklin Street, Suite 102
Buffalo, NY 14202

Phone 716-332-3134
Fax 716-332-3136

Chain of Custody Document

x Report to: _____

Client/Contact: <u>C&S Engineers - Jeffrey Robbins</u>		Turn around (circle) RUSH 48 Hour 24 Hour 72 Hour
Building/Location: <u>MAXCY HALL</u>		
Job #: <u>SET954</u>	Total # Samples: <u>9</u>	

☒ PLM ☐ TEM ☐ AAS ☐ OTHER _____

Sample #	Description of Sample	Location of Sample	Notes
12A-MAX-100-1	Cinder block mortar	1st fl. Hall	P157-1
12B-MAX-100-2	Cinder block mortar	Basement stairwell	1-2
12B-MAX-101-1	Brick mortar	1st fl. foyer	-3
12A-MAX-101-2	Brick mortar	1st fl. foyer	-4
12B-MAX-200-1	2x4 dot CT	Ladies locker Rm.	-5
12B-MAX-200-2	2x4 dot CT	Ladies locker Rm.	-6
12B-MAX-201-1	Popcorn ceiling	1st fl. foyer	-7
12B-MAX-201-2	Popcorn ceiling	1st fl. foyer	-8
12B-MAX-201-3	Popcorn ceiling	1st fl. foyer	P157-9
		Sienna Environmental Technologies	
		☒ Accept	
		☐ Reject	

Notes:

Sampled By: Paul J. Maw Date: 12/17/08
 Relinquished By: Paul J. Maw Date: 12/1/08
 Received By: J. Scalski 1500 P157 Date: 12/18/08



SIENNA ENVIRONMENTAL TECHNOLOGIES, LLC

429 Franklin St. • Suite 102 • Buffalo, NY 14202 • Ph: 716-332-3134 • Fax: 716-332-3136

LABORATORY REPORT

Attn: Jeffrey Robbins
C & S Engineers
499 Col. Eileen Collins Blvd
Syracuse, NY 13212

Date Received: 12/18/2008

Date Analyzed: 12/29/2008

Sienna ID: P156

Phone: 315-455-2000 Fax: 315-455-9667

Project: SET954 Lehmann Hall

Polarized Light Microscopy (PLM) by NY State ELAP Method 198.1

Sample	Description	Location	% Fibrous	% Non-Fibrous	% Asbestos Type
1217-LEH-100A-1 P156-1	Gray, Fibrous, Non-Homogenous	Drywall - Kitchen	10%	90%	NAD
1217-LEH-100A-2 P156-2	Gray, Fibrous, Non-Homogenous	Drywall - Kitchen	20%	80%	NAD
1217-LEH-100B-1 P156-3	Gray, Non-Fibrous, Homogenous	Joint Compound - Kitchen	0%	100%	NAD
1217-LEH-100B-2 P156-4	Gray, Non-Fibrous, Homogenous	Joint Compound - Kitchen	0%	100%	NAD
1217-LEH-100B-3 P156-5	Gray, Non-Fibrous, Homogenous	Joint Compound - Kitchen	0%	100%	NAD

Tracy Skalski
Analyst(s)

Approved Signatory

Disclaimers: NAD = No asbestos detected. Results relate only to samples provided by client. This report shall not be reproduced, except in full, without written approval by Sienna. Samples analyzed as NAD or Trace (<1%) cannot be guaranteed. Quantitative transmission electron microscopy is currently the only reliable method that can be used to determine if this material can be considered or treated as non-asbestos containing. Analysis performed by Sienna Environmental Technologies, NY ELAP #11727.

429 Franklin Street, Suite 102
Buffalo, NY 14202

Phone 716-332-3134
Fax 716-332-3136

Tax Report to: _____

X PLM _____ TEM _____ AAS OTHER _____

Notes: 107

Sampled By: Paul H. Haring Date: 12/17/08
Relinquished By: Paul H. Haring Date: _____
Received By: J. St. John 1500 P150 Date: 12/18/08



SIENNA ENVIRONMENTAL TECHNOLOGIES, LLC

429 Franklin St. · Suite 102 · Buffalo, NY 14202 · Ph: 716-332-3134 · Fax: 716-332-3136

LABORATORY REPORT

Attn: Jeffrey Robbins
C & S Engineers
499 Col. Eileen Collins Blvd
Syracuse, NY 13212
Phone: 315-455-2000 Fax: 315-455-9667
Project: SET954 Crane Music Complex

Date Received: 12/18/2008

Date Analyzed: 12/26/2008

Sienna ID: P151

Hosmer

Polarized Light Microscopy (PLM) by NY State ELAP Method 198.1

Sample	Description	Location	% Fibrous	% Non-Fibrous	% Asbestos Type
1217-CRA-100-1 P151-1	Gray, Non-Fibrous, Homogenous	Cinder Block Mortar - Maintenance Shop	0%	100%	NAD
1217-CRA-100-2 P151-2	Gray, Non-Fibrous, Homogenous	Cinder Block Mortar - Room 410	0%	100%	NAD
1217-CRA-101A-1 P151-3	Gray, Non-Fibrous, Homogenous	Drywall - Hosmer Gallery	0%	100%	NAD
1217-CRA-101A-2 P151-4	Gray, Non-Fibrous, Homogenous	Drywall - Hosmer Gallery	5%	95%	NAD
1217-CRA-101B-1 P151-5	White, Non-Fibrous, Homogenous	Joint Compound - Hosmer Gallery	0%	100%	NAD
1217-CRA-101B-2 P151-6	Tan, Non-Fibrous, Homogenous	Joint Compound - Hosmer Gallery	0%	100%	NAD
1217-CRA-101B-3 P151-7	Tan, Non-Fibrous, Homogenous	Joint Compound - Hosmer Gallery	0%	100%	NAD
1217-CRA-102-1 P151-8	Gray, Fibrous, Homogenous	Transite Wall Board - Room 407	15%	85%	9.8% Chrysotile
1217-CRA-102-2 P151-9	Gray, Fibrous, Homogenous	Transite Wall Board - Room 407	25%	75%	21.1% Chrysotile

Tracy Skalski
Analyst(s)

[Signature]
Approved Signatory

Disclaimers: NAD = No asbestos detected. Results relate only to samples provided by client. This report shall not be reproduced, except in full, without written approval by Sienna. Samples analyzed as NAD or Trace (<1%) cannot be guaranteed. Quantitative transmission electron microscopy is currently the only reliable method that can be used to determine if this material can be considered or treated as non-asbestos containing. Analysis performed by Sienna Environmental Technologies, NY ELAP #11727.

SIENNA ENVIRONMENTAL TECHNOLOGIES, LLC

429 Franklin Street, Suite 102
Buffalo, NY 14202

Phone 716-332-3134
Fax 716-332-3136

Chain of Custody Document

Lab Report to: _____

Client/Contact: <u>C/S Engineers - Jeffrey Robbins</u>		Turn around (circle) RUSH 48 Hour 24 Hour 72 Hour
Building/Location: <u>CRANE MUSIC COMPLEX</u>		
Job #: <u>SET954</u>	Total # Samples: <u>9</u>	

☒ PLM ☐ TEM ☐ AAS ☐ OTHER _____

Sample #	Description of Sample	Location of Sample	Notes
12F-CRA-100-1	Cinder block mortar	Maintenance Shop	PS1-1
12F-CRA-100-2	Cinder block mortar	Rm 410	-2
12F-CRA-101A-1	Dry wall	Hosmer gallery	-3
12F-CRA-101A-2	Dry wall	Hosmer gallery	-4
12F-CRA-101B-1	Joint compound	Hosmer gallery	-5
12F-CRA-101B-2	Joint compound	Hosmer gallery	-6
12F-CRA-101B-3	Joint compound	Hosmer gallery	-7
12F-CRA-102-1	Transite wall board	Rm 407	-8
12F-CRA-102-2	Transite wall board	Rm 407	PS1-9

Sienna Environmental
Technologies
☒ Accept
☐ Reject

Notes:

Sampled By: Paul J. Maw Date: 12/17/08
Relinquished By: Paul J. Maw Date: _____
Received By: AS Stalski 1500 P151 Date: 12/18/08



SIENNA ENVIRONMENTAL TECHNOLOGIES, LLC

429 Franklin St. • Suite 102 • Buffalo, NY 14202 • Ph: 716-332-3134 • Fax: 716-332-3136

LABORATORY REPORT

Attn: Jeffrey Robbins
C & S Engineers
499 Col. Eileen Collins Blvd
Syracuse, NY 13212

Date Received: 12/18/2008

Date Analyzed: 12/29/2008

Sienna ID: P154

Phone: 315-455-2000

Fax: 315-455-9667

Project: SET954 Healing Plant / Service Center

Polarized Light Microscopy (PLM) by NY State ELAP Method 198.1

Sample	Description	Location	% Fibrous	% Non-Fibrous	% Asbestos Type
1217-HPL-100-1 P154-1	Gray, Non-Fibrous, Homogenous	Cinder Block Mortar - Garage	0%	100%	NAD
1217-HPL-100-2 P154-2	Gray, Non-Fibrous, Homogenous	Cinder Block Mortar - Garage	0%	100%	NAD
1217-HPL-101-1 P154-3	Gray, Non-Fibrous, Homogenous	Brick Mortar - Switch Gear Room	0%	100%	NAD
1217-HPL-101-2 P154-4	Gray, Non-Fibrous, Homogenous	Brick Mortar - Switch Gear Room	0%	100%	NAD

Tracy Skalski
Analyst(s)

Approved Signatory

Disclaimers: NAD = No asbestos detected. Results relate only to samples provided by client. This report shall not be reproduced, except in full, without written approval by Sienna. Samples analyzed as NAD or Trace (<1%) cannot be guaranteed. Quantitative transmission electron microscopy is currently the only reliable method that can be used to determine if this material can be considered or treated as non-asbestos containing. Analysis performed by Sienna Environmental Technologies, NY ELAP #11727.

429 Franklin Street, Suite 102
Buffalo, NY 14202

Phone 716-332-3134
Fax 716-332-3136

Tax Report to: _____

Client/Contact: <u>C.S. Engineers- Jeffrey Robbins</u>	Turn around (circle)
Building/Location: <u>HEATING PLANT / SERVICE CENTER</u>	
Job #: <u>SET954</u> Total # Samples: <u>4</u>	RUSH 48 Hour 24 Hour 72 Hour

X PLM _____ TEM _____ AAS OTHER _____

[illegible]

Notes:

Sampled By: Paul Maw Date: 12/17/08
Relinquished By: Paul Maw Date: _____
Received By: A. Stalski 1500 P154 Date: 12/18/08



SIENNA ENVIRONMENTAL TECHNOLOGIES, LLC

429 Franklin St. · Suite 102 · Buffalo, NY 14202 · Ph: 716-332-3134 · Fax: 716-332-3136

LABORATORY REPORT

Attn: Jeffrey Robbins
C & S Engineers
499 Col. Eileen Collins Blvd
Syracuse, NY 13212
Phone: 315-455-2000 Fax: 315-455-9667
Project: SET954 Knowles Dining Hall

Date Received: 12/18/2008
Date Analyzed: 12/29/2008
Sienna ID: P155

Polarized Light Microscopy (PLM) by NY State ELAP Method 198.1

Sample	Description	Location	% Fibrous	% Non-Fibrous	% Asbestos Type
1217-KNO-100-1 P155-1	Brown, Non-Fibrous, Homogenous	Brick Mortar - Dining Room	0%	100%	NAD
1217-KNO-100-2 P155-2	Brown, Non-Fibrous, Homogenous	Brick Mortar - Dining Room	0%	100%	NAD

Tracy Skalski
Analyst(s)


Approved Signatory

Disclaimers: NAD = No asbestos detected. Results relate only to samples provided by client. This report shall not be reproduced, except in full, without written approval by Sienna. Samples analyzed as NAD or Trace (<1%) cannot be guaranteed. Quantitative transmission electron microscopy is currently the only reliable method that can be used to determine if this material can be considered or treated as non-asbestos containing. Analysis performed by Sienna Environmental Technologies, NY ELAP #11727.

429 Franklin Street, Suite 102
Buffalo, NY 14202

Phone 716-332-3134
Fax 716-332-3136

Tax Report to: _____

Client/Contact: <u>C & S Engineers, Jeffrey Robbins</u>	Turn around (circle)
Building/Location: <u>Knowles Dining Hall</u>	
Job #: <u>SET 954</u> Total # Samples: <u>2</u>	☒ RUSH 48 Hour ☐ 24 Hour 72 Hour

X PLM TEM AAS OTHER

[illegible]

Notes:

Page 1 of 1

Sampled By:

Paul J. Manning

Date: 12/17/08

Relinquished By:

Kau 17 März

Date: _____


Received By:

Erstakt 1800 P55

Date: 12/18/08

Appendix D Asbestos sample location maps


(

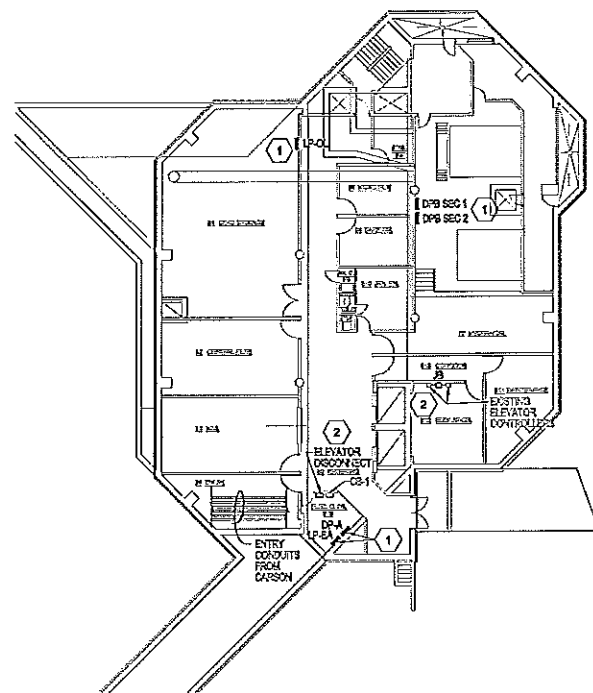

DRAWING SPECIFIC NOTES:
 1 REMOVE EXISTING PANELBOARD IN THIS LOCATION AND REPLACE WITH NEW PANEL BOARD AS SHOWN.
 SEE A1 100B-1 FOR WORK ASSOCIATED IN THESE AREAS.




C1 RAYMOND - BASEMENT PLAN
 SCALE: 1/8" = 1'-0"

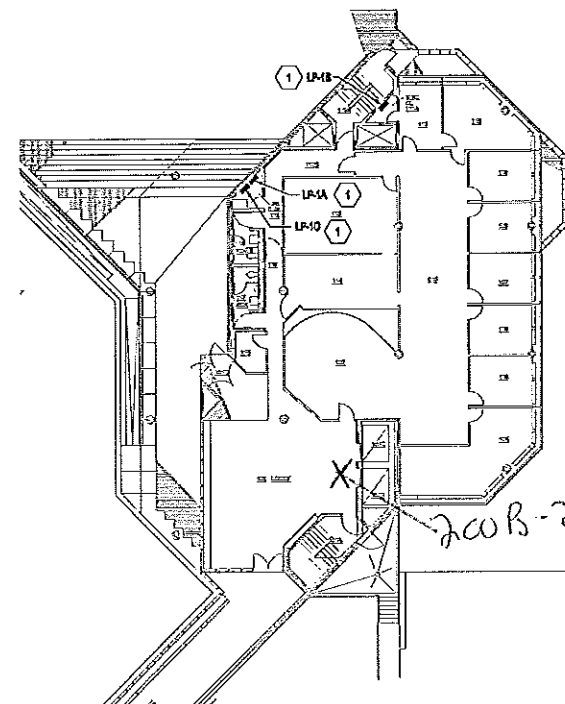

DRAWING SPECIFIC NOTES:
 1 REMOVE EXISTING PANELBOARD IN THIS LOCATION AND REPLACE WITH NEW PANEL BOARD AS SHOWN.




C3 RAYMOND - FIRST FLOOR PLAN
 SCALE: 1/8" = 1'-0"

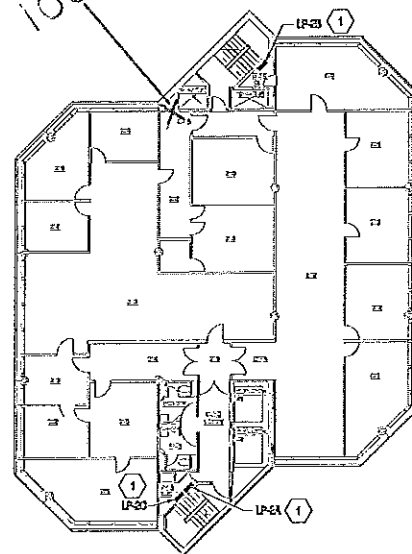

DRAWING SPECIFIC NOTES:
 1 REMOVE EXISTING PANELBOARD IN THIS LOCATION AND REPLACE WITH NEW PANEL BOARD AS SHOWN.



A1 RAYMOND - SECOND FLOOR PLAN
 SCALE: 1/8" = 1'-0"

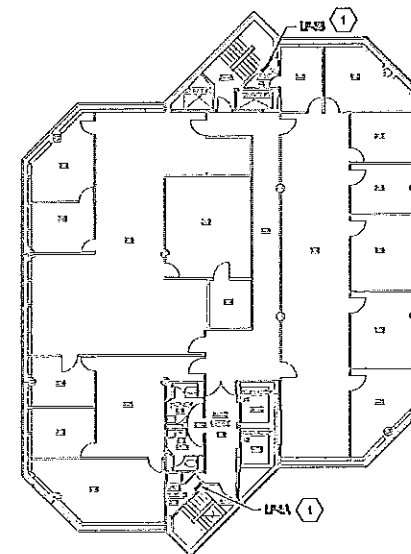

DRAWING SPECIFIC NOTES:
 1 REMOVE EXISTING PANELBOARD IN THIS LOCATION AND REPLACE WITH NEW PANEL BOARD AS SHOWN.




A3 RAYMOND - THIRD FLOOR PLAN
 SCALE: 1/8" = 1'-0"



C&S Engineers, Inc.
 499 Col. Eileen Collins Blvd.
 Syracuse, New York 13212
 Phone: 315-455-2000
 Fax: 315-455-9687
 www.cscos.com

INSERT C&S
 PE SEAL HERE

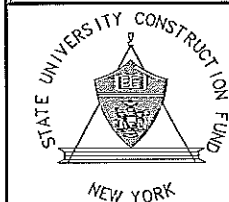

STATE UNIVERSITY CONSTRUCTION FUND
 SUCF PROJECT NO. 12290
 STATE UNIVERSITY OF NEW YORK AT POTSDAM
 PRE-BID SUBMISSION - NOT FOR CONSTRUCTION
 UPGRADE ELECTRICAL DISTRIBUTION SYSTEMS
 VARIOUS BUILDINGS

MARK	DATE	DESCRIPTION
REVISIONS		
PROJECT NO:	193-433-001	
DATE:	DECEMBER 5, 2003	
SCALE:	AS SHOWN	
DRAWN BY:	P.N.W.	
DESIGNED BY:	T.A. KUKIEWICZ	
CHECKED BY:	J.L. ROSS, P.E.	

NO ALTERATION PERMITTED HEREON EXCEPT AS PROVIDED UNDER SECTION 2209 SUBDIVISION 2 OF THE NEW YORK EDUCATION LAW

ELECTRICAL

**RAYMOND
 BASEMENT, 1ST
 2ND & 3RD
 PLANS**

E-100-1a



C&S Engineers, Inc.
499 Col. Eileen Collins Blvd.
Syracuse, New York 13212
Phone: 315-455-2000
Fax: 315-455-6687
www.cscos.com

NEED C&S
PE SEAL HERE




STATE UNIVERSITY CONSTRUCTION FUND
SUCC PROJECT NO. 12290
STATE UNIVERSITY OF NEW YORK AT POTSDAM
PRE-BID SUBMISSION - NOT FOR CONSTRUCTION
UPGRADE ELECTRICAL DISTRIBUTION SYSTEMS
VARIOUS BUILDINGS

MARK	DATE	DESCRIPTION
REVISIONS		
PROJECT NO: 190433.001		
DATE: DECEMBER 5, 2003		
SCALE: AS SHOWN		
DRAWN BY: P.H.UU		
DESIGNED BY: T.G. KUKIEWICZ		
CHECKED BY: J.L. ROSSINI, P.E.		
NO ALTERATION PERMITTED HEREON EXCEPT AS PROVIDED UNDER SECTION 7209 SUBDIVISION 2 OF THE NEW YORK EDUCATION LAW		

ELECTRICAL

RAYMOND
4TH, 5TH, 6TH, 7TH
& 8TH FLOOR PLANS


E-100-1b

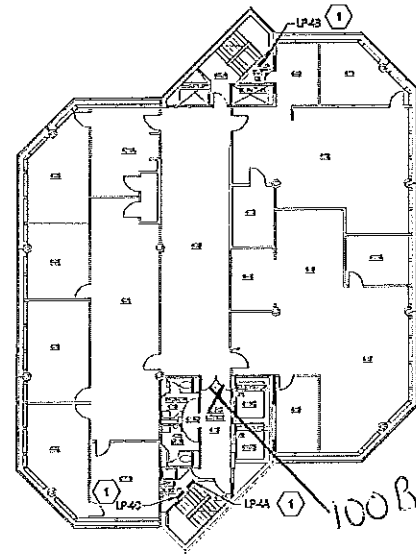

DRAWING SPECIFIC NOTES:
1 REMOVE EXISTING PANELBOARD IN THIS LOCATION AND
REPLACE WITH NEW PANEL BOARD AS SHOWN.




C1 RAYMOND - FOURTH FLOOR PLAN
SCALE: 1/16" = 1'-0"

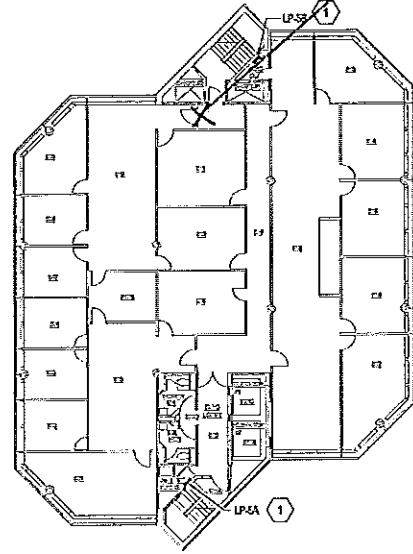

DRAWING SPECIFIC NOTES:
1 REMOVE EXISTING PANELBOARD IN THIS LOCATION AND
REPLACE WITH NEW PANEL BOARD AS SHOWN.




C2 RAYMOND - FIFTH FLOOR PLAN
SCALE: 1/16" = 1'-0"

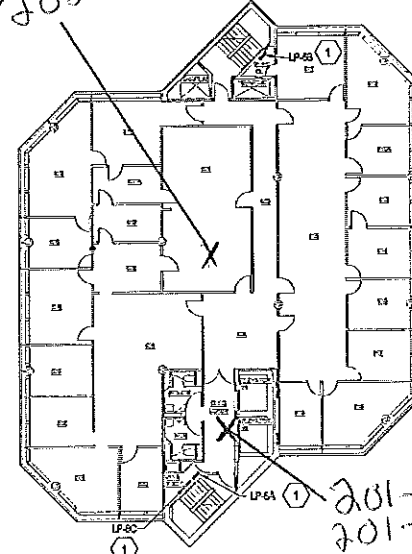

DRAWING SPECIFIC NOTES:
1 REMOVE EXISTING PANELBOARD IN THIS LOCATION AND
REPLACE WITH NEW PANEL BOARD AS SHOWN.




C3 RAYMOND - SIXTH FLOOR PLAN
SCALE: 1/16" = 1'-0"

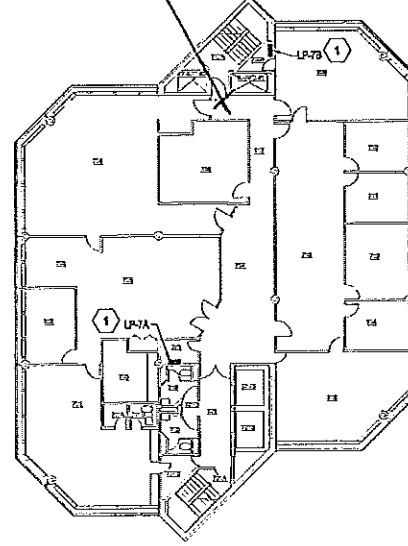

DRAWING SPECIFIC NOTES:
1 REMOVE EXISTING PANELBOARD IN THIS LOCATION AND
REPLACE WITH NEW PANEL BOARD AS SHOWN.



C4 RAYMOND - SEVENTH FLOOR PLAN
SCALE: 1/16" = 1'-0"

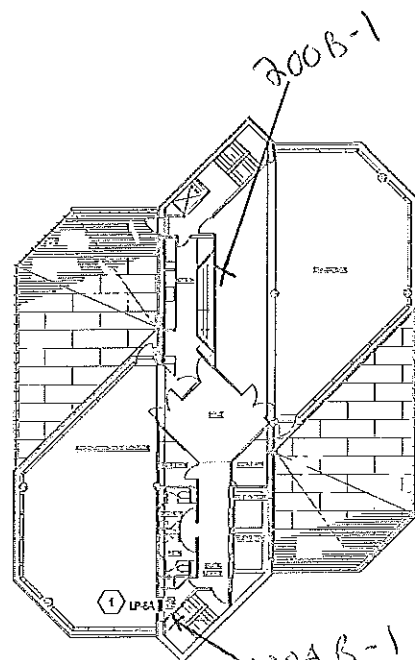

DRAWING SPECIFIC NOTES:
1 REMOVE EXISTING PANELBOARD IN THIS LOCATION AND
REPLACE WITH NEW PANEL BOARD AS SHOWN.



A1 RAYMOND - EIGHTH FLOOR PLAN
SCALE: 1/16" = 1'-0"



C&S Engineers, Inc.
499 Col. Elson Collins Blvd.
Syracuse, New York 13212
Phone: 315-455-2000
Fax: 315-455-0667
www.cscs.com



STATE UNIVERSITY CONSTRUCTION FUND
NEW YORK


STATE UNIVERSITY CONSTRUCTION FUND
SUCF PROJECT NO. 12290
STATE UNIVERSITY OF NEW YORK AT POISDAM
PRE-BID SUBMISSION - NOT FOR CONSTRUCTION
UPGRADE ELECTRICAL DISTRIBUTION SYSTEMS
VARIOUS BUILDINGS

MARK	DATE	DESCRIPTION
REVISIONS		
PROJECT NO.	190.453.001	
DATE:	DECEMBER 5, 2003	
SCALE:	AS SHOWN	
DRAWN BY:	P.N.W.	
DESIGNED BY:	T.O. HILKINCH	
CHECKED BY:	J.L. ROSSINI, P.E.	


NO ALTERATION PERMITTED HEREON
EXCEPT AS PROVIDED UNDER SECTION
7209 SUBDIVISION 2 OF THE NEW YORK
EDUCATION LAW

ELECTRICAL
FLAGG
BASEMENT & 1ST
FLOOR PLANS



E-100-3a

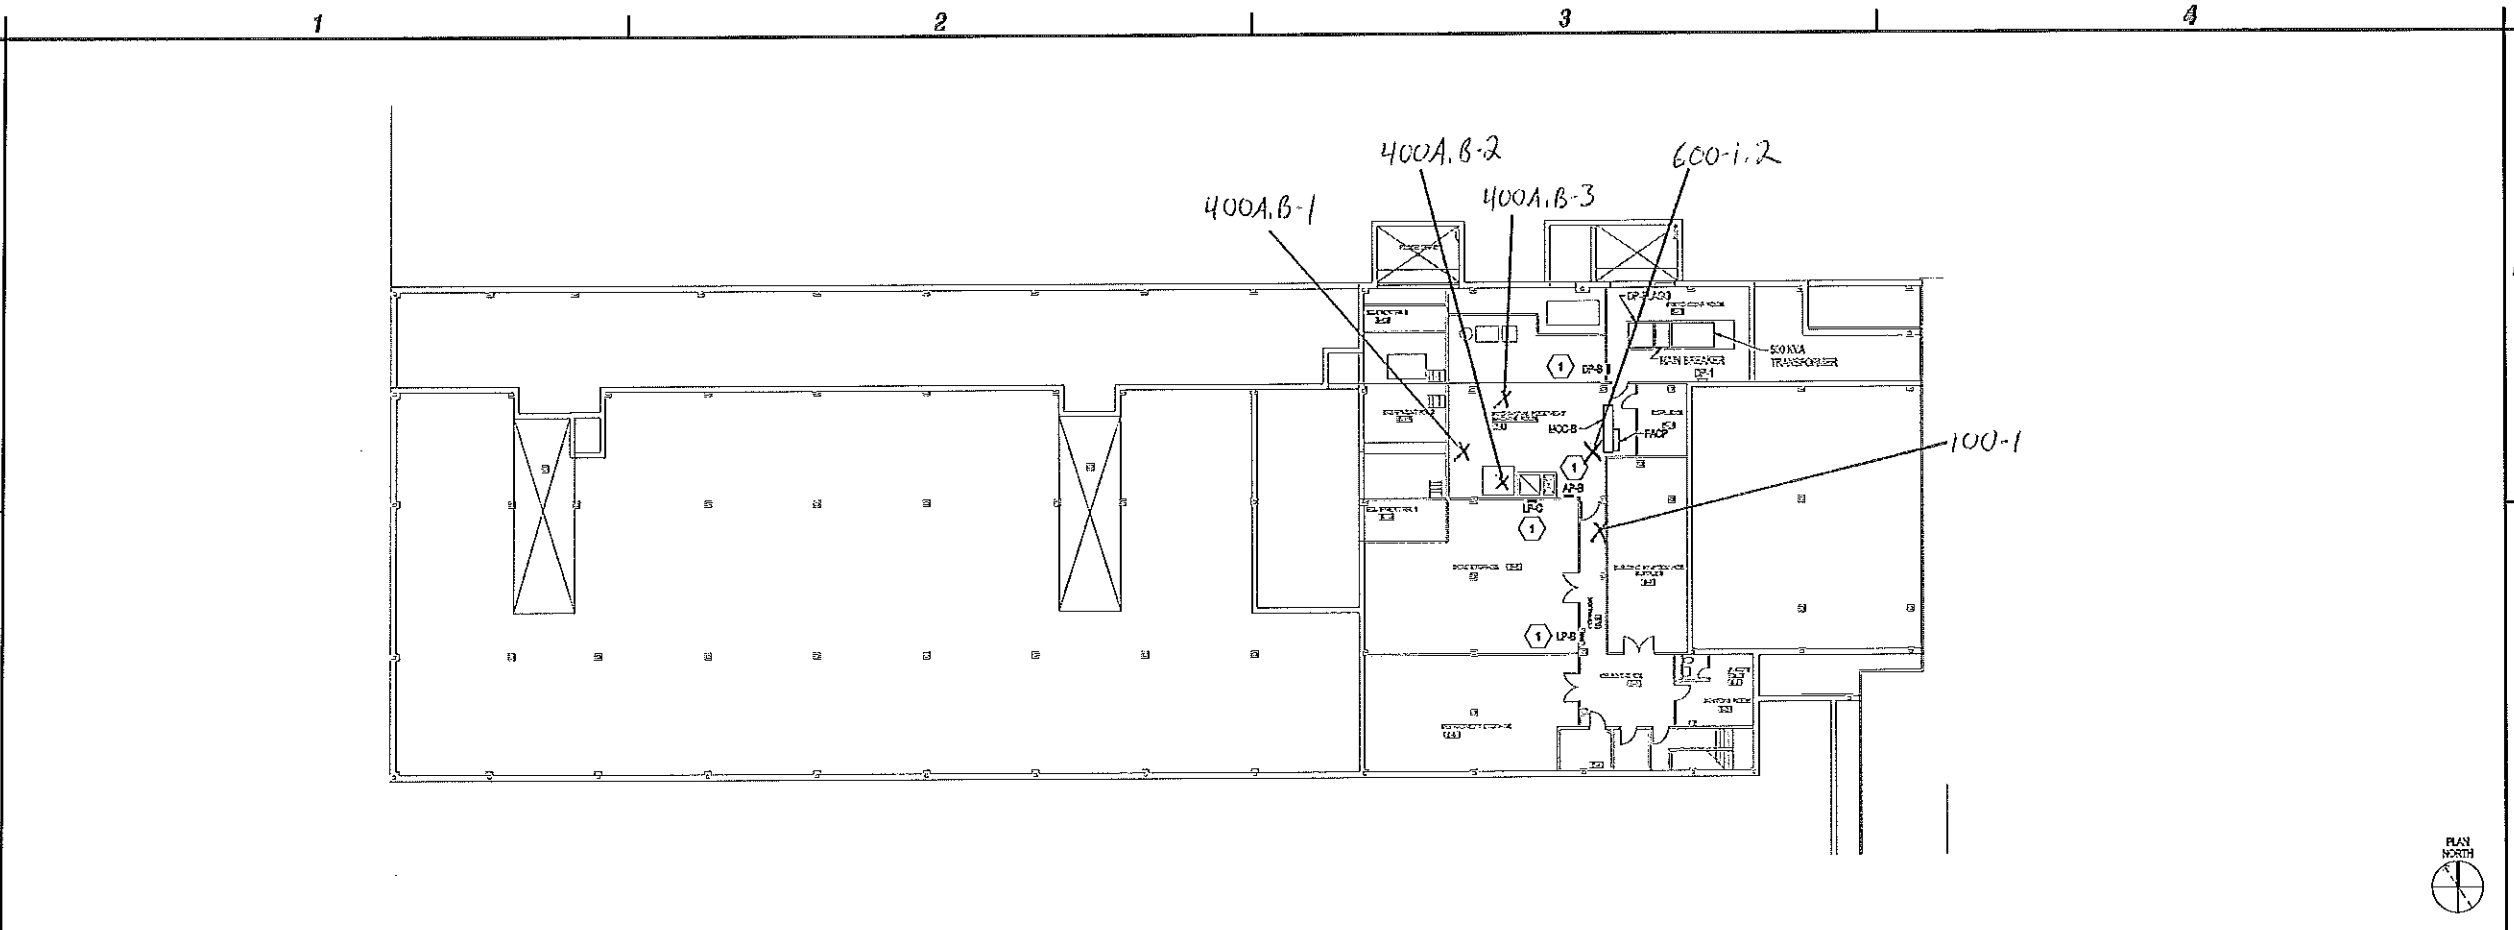

C1 FLAGG - BASEMENT PLAN
SCALE: 1/8" = 1'-0"

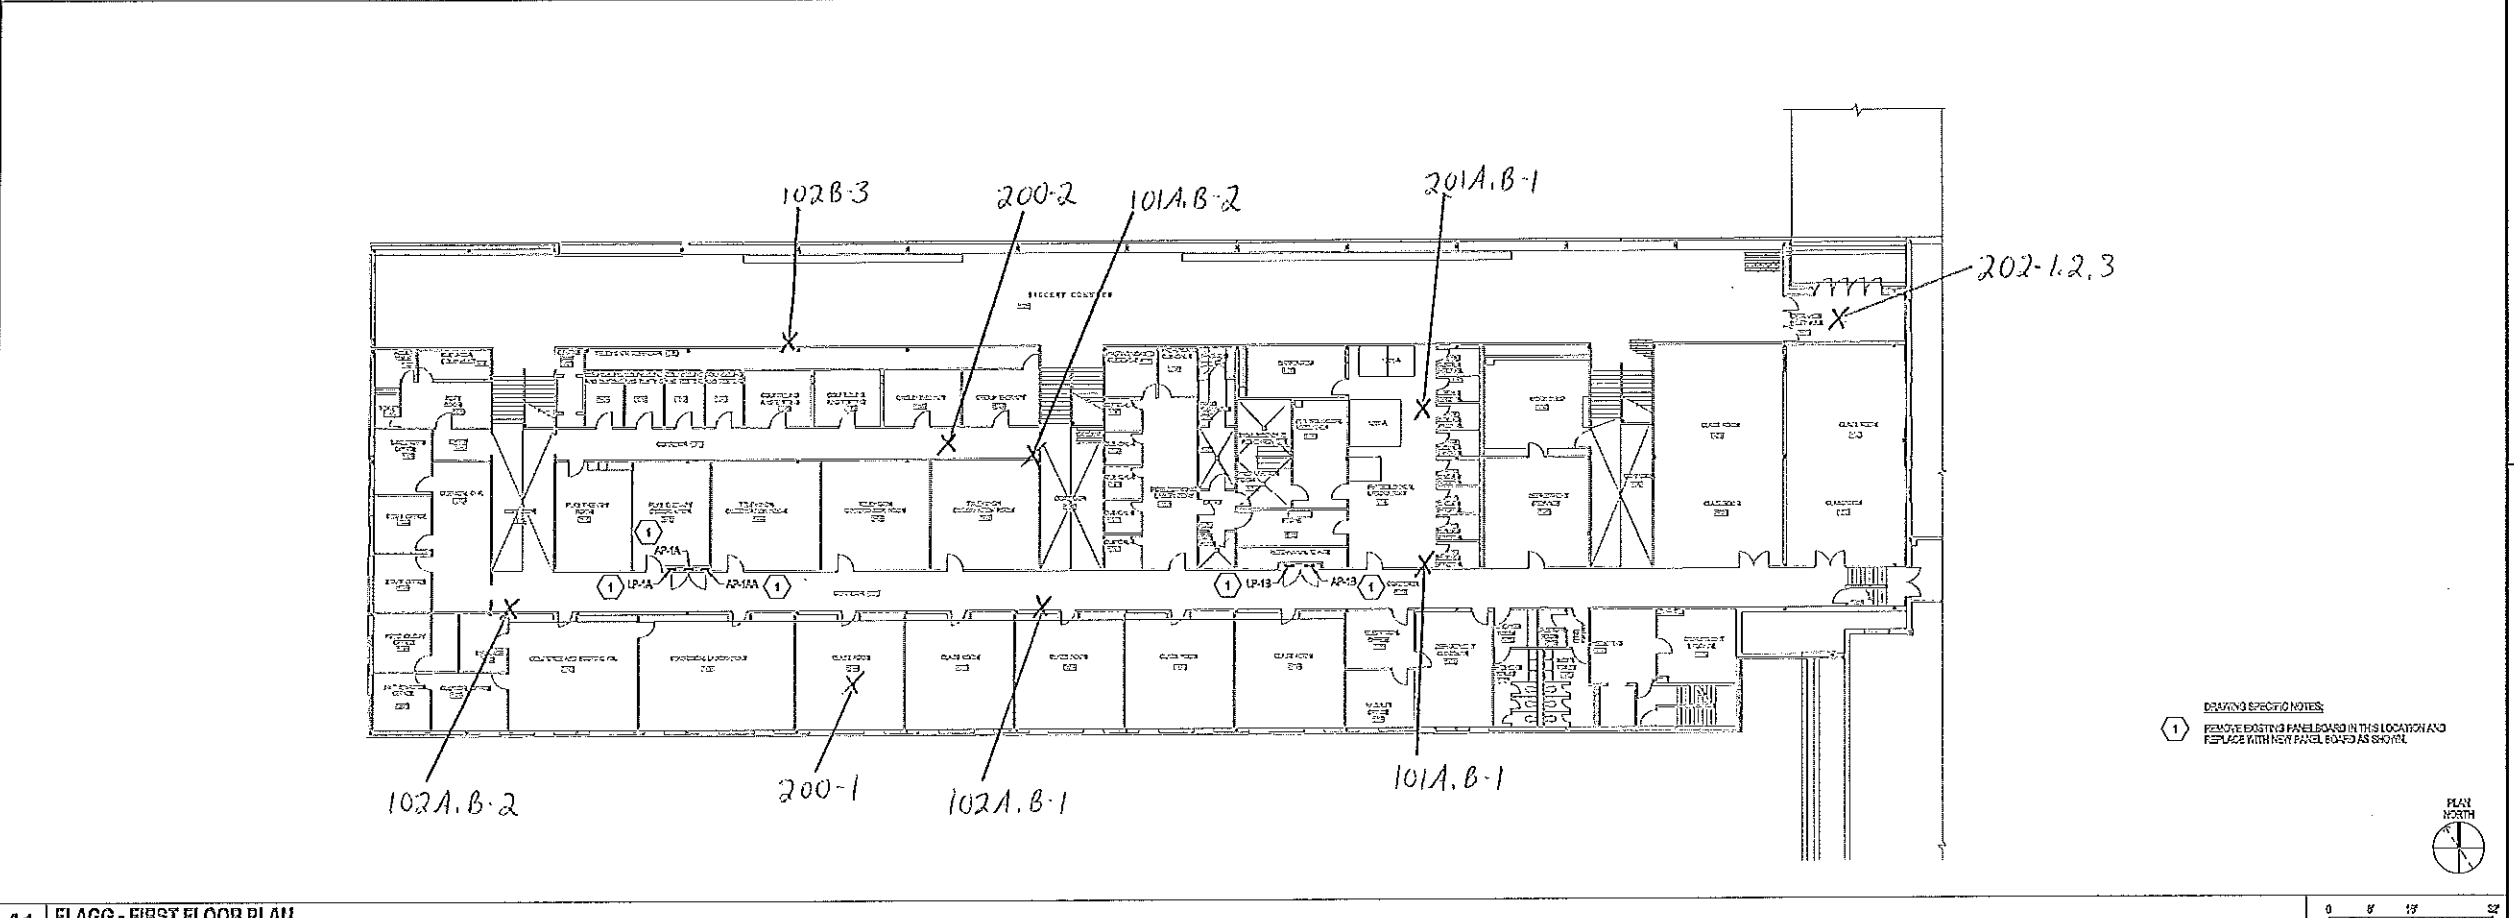

A1 FLAGG - FIRST FLOOR PLAN
SCALE: 1/8" = 1'-0"

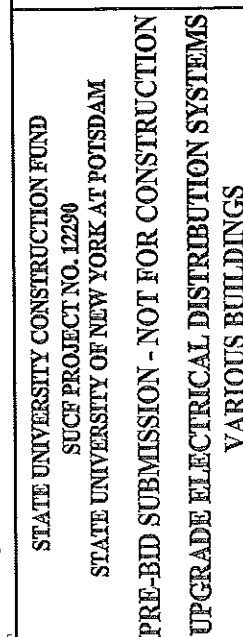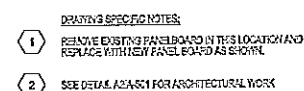


MARK	DATE	DESCRIPTION
		REVISIONS
		PROJECT NO: 190.453.001
		DATE: DECEMBER 5, 2003
		SCALE: AS SHOWN
		DRAWN BY: P. NUU
		CHECKED BY: T. KURKOW
		DESIGNED BY: J. L. ROSS, P.E.
		NO ALTERATION PERMITTED HEREON EXCEPT AS PROVIDED UNDER SECTION 2409 SUBSECTION 2 OF THE NEW YORK EDUCATION LAW


ELECTRICAL

FLAGG
SECOND FLOOR
PLAN


E-100-3b

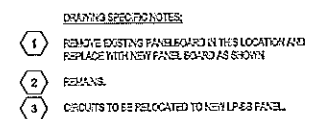


PLAY NORTH

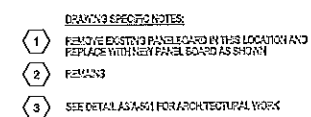


PLAN
NORTH

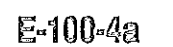


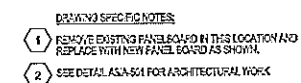

E-100-4b

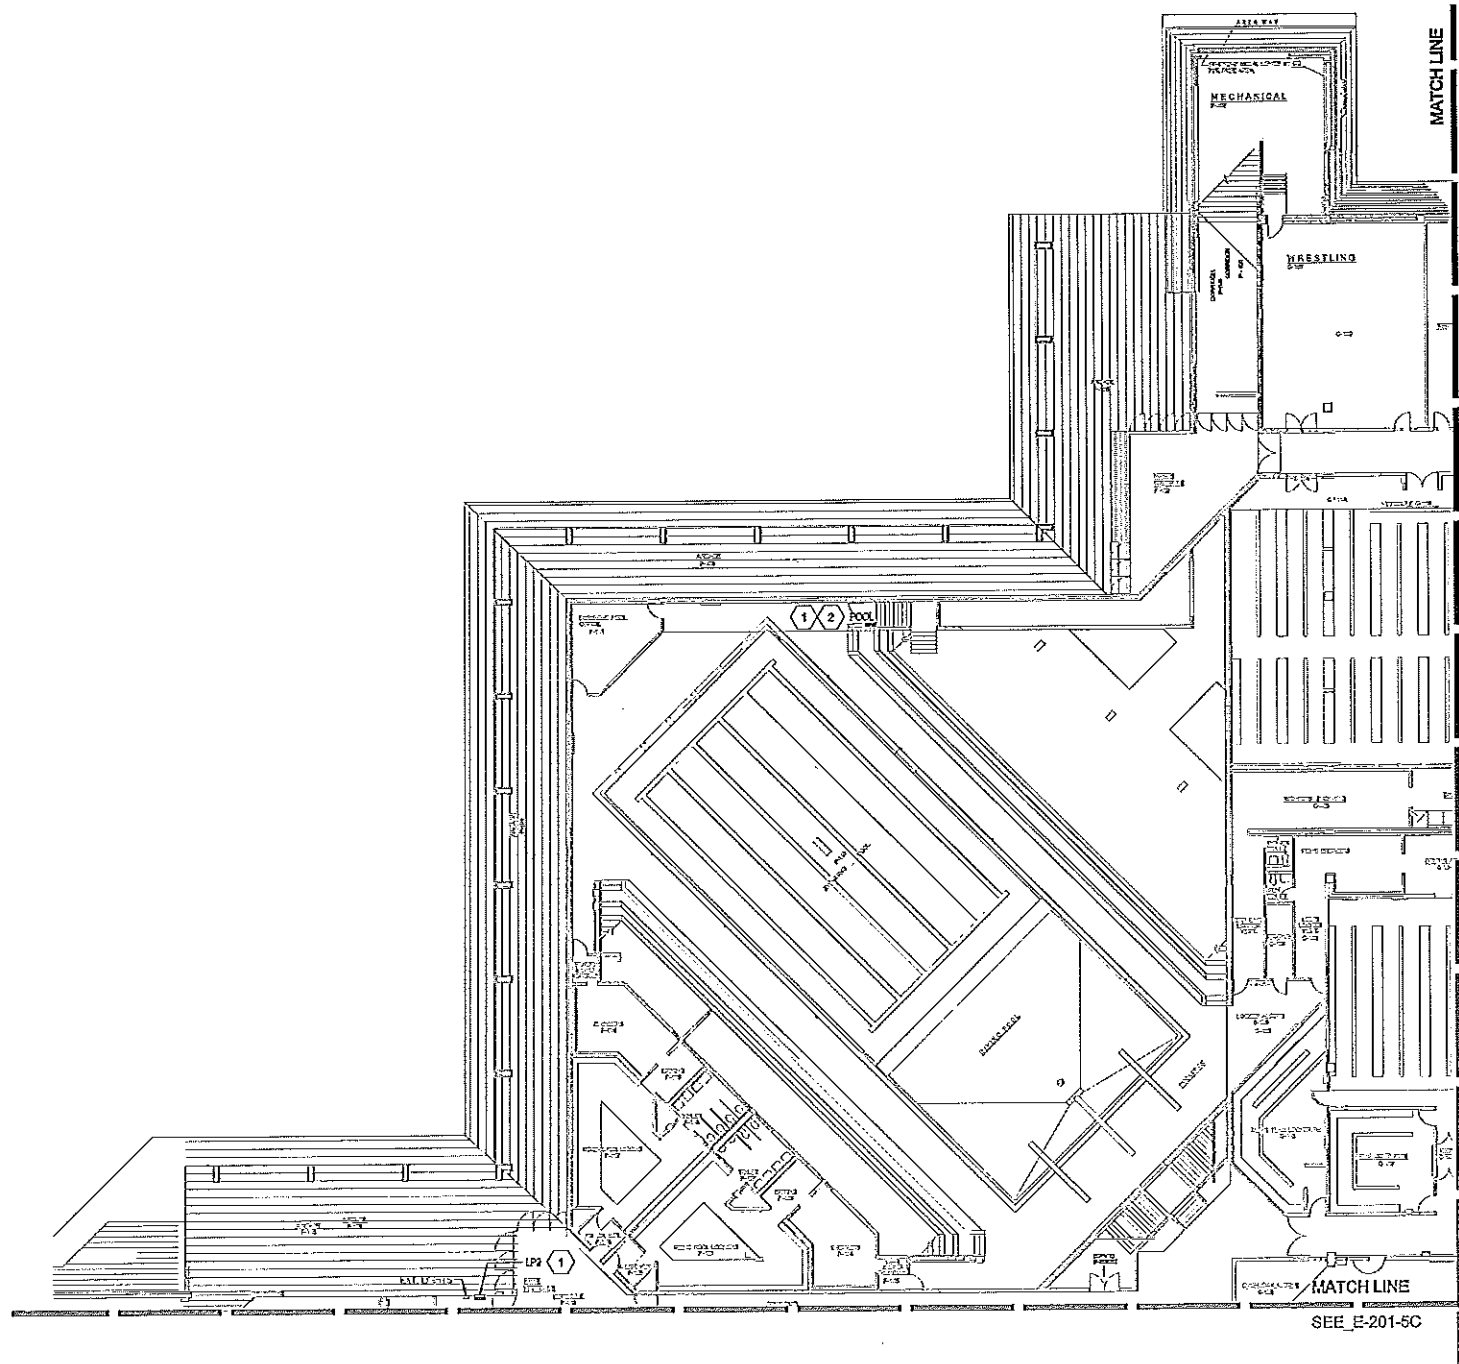

- DRAWING SPECIFIC NOTES:**
- 1 REMOVE EXISTING PANELBOARDS IN THIS LOCATION AND REPLACE WITH NEW PANELBOARDS AS SHOWN.
 - 2 PROVIDE NEW ENCLOSURE FOR THIS ELECTRICAL PANEL.

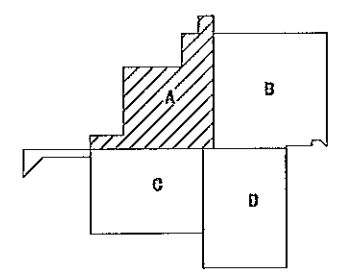

A1 MAXCY - FIRST FLOOR PLAN
SCALE: 1/8" = 1'-0"

A4 KEY PLAN
SCALE: 1/4" = 1'-0"



C&S ENGINEERS, INC.
499 Col. Eileen Collins Blvd.
Syracuse, New York 13212
Phone: 315-455-2000
Fax: 315-455-9687
www.cscos.com



STATE UNIVERSITY CONSTRUCTION FUND
NEW YORK


STATE UNIVERSITY CONSTRUCTION FUND
SUCF PROJECT NO. 12290
STATE UNIVERSITY OF NEW YORK AT POTSDAM
PRE-BID SUBMISSION - NOT FOR CONSTRUCTION
UPGRADE ELECTRICAL DISTRIBUTION SYSTEMS
VARIOUS BUILDINGS

MARK	DATE	DESCRIPTION
REVISIONS		
PROJECT NO:	190.533001	
DATE:	DECEMBER 5, 2003	
SCALE:	AS SHOWN	
DRAWN BY:	P.H. LUJ	
DESIGNED BY:	M.R. HAYES, P.E.	
CHECKED BY:	J.L. ROSS, P.E.	
NO ALTERATION PERMITTED HEREON EXCEPT AS PROVIDED UNDER SECTION 1703 SUBDIVISION 2 OF THE NEW YORK EDUCATION LAW.		

ELECTRICAL


MAXCY FIRST FLOOR PLAN

E-201-5a

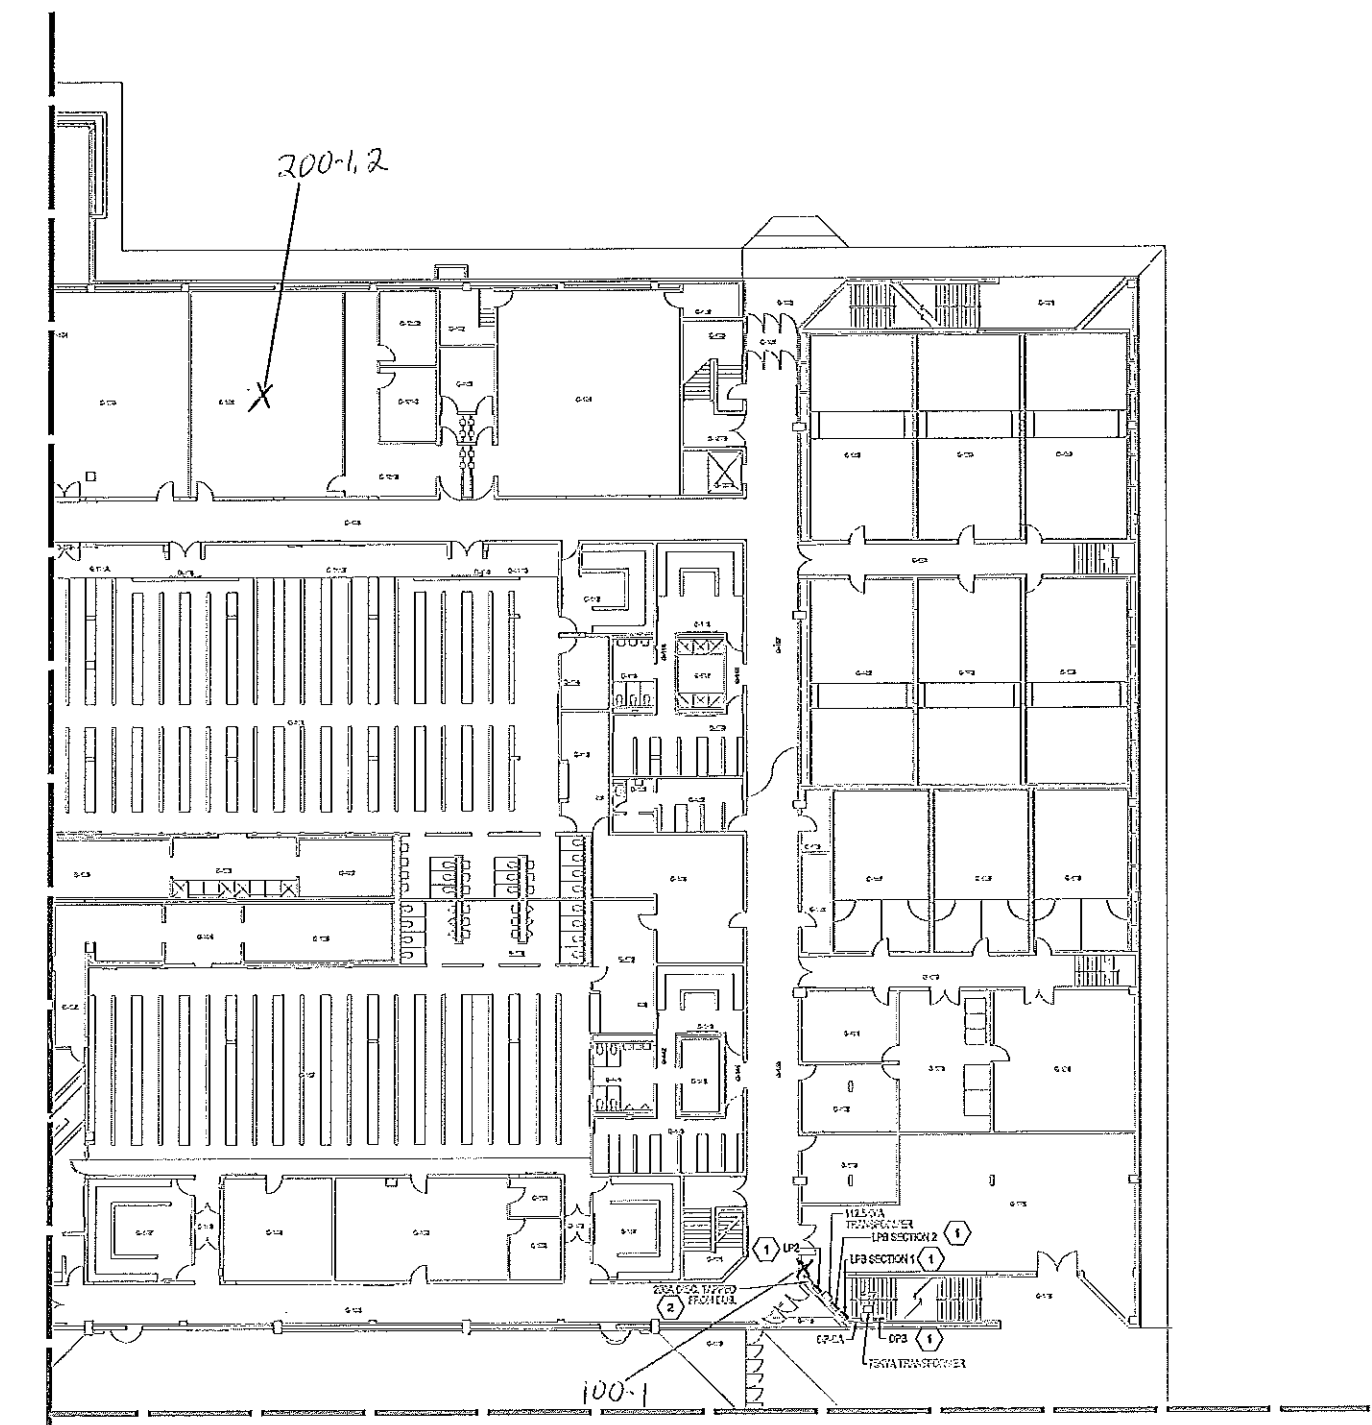

MATCH LINE
SEE E-201-5A

- REVISION SPECIFIC NOTES
- (1) REMOVE EXISTING PANELS SHOWN IN THIS LOCATION AND REPLACE WITH NEW PANEL BOARD AS SHOWN
 - (2) SWITCH REMOVED

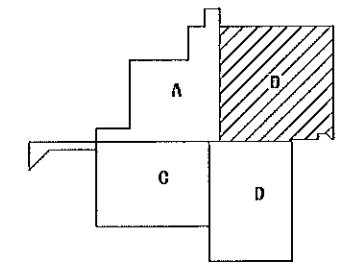

A1 MAXCY - FIRST FLOOR PLAN
09/25/11 11' x 15'

0 6 12 24

A4 KEY PLAN
DATE: 10/10/11

C&S COMPANIES

C&S Engineers, Inc.
499 Col. Elson Collins Blvd.
Syracuse, New York 13212
Phone: 315-455-2000
Fax: 315-455-9637
www.cscos.com

STATE UNIVERSITY CONSTRUCTION FUND
NEW YORK

STATE UNIVERSITY CONSTRUCTION FUND
SUCF PROJECT NO. 12290
STATE UNIVERSITY OF NEW YORK AT POTSDAM
PRE-BID SUBMISSION - NOT FOR CONSTRUCTION
UPGRADE ELECTRICAL DISTRIBUTION SYSTEMS
VARIOUS BUILDINGS

MARK	DATE	DESCRIPTION
REVISIONS		
PROJECT NO:	190.458.001	
DATE:	DECEMBER 5, 2009	
SCALE:	AS SHOWN	
DRAWN BY:	P. N. LUM	
DESIGNED BY:	H. R. HAYES, P.E.	
CHECKED BY:	J. L. ROBBINS, P.E.	
NO ALTERATION PERMITTED HEREON EXCEPT AS PROVIDED UNDER SECTION 7209 SUBDIVISION 2 OF THE NEW YORK EDUCATION LAW		



ELECTRICAL

**MAXCY
FIRST FLOOR
PLAN**

E-201-5b



C&S Engineers, Inc.
499 Col. Eileen Collins Blvd.
Syracuse, New York 13212
Phone: 315-455-2000
Fax: 315-455-9687
www.ccs.com

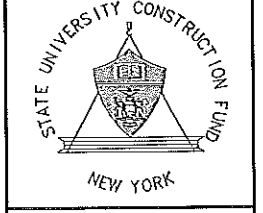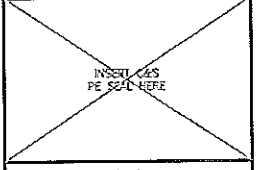

STATE UNIVERSITY CONSTRUCTION FUND
SUCF PROJECT NO. 12290
STATE UNIVERSITY OF NEW YORK AT POTSDAM
PRE-BID SUBMISSION - NOT FOR CONSTRUCTION
UPGRADE ELECTRICAL DISTRIBUTION SYSTEMS
VARIOUS BUILDINGS

MARK	DATE	DESCRIPTION

REVISIONS
PROJECT NO: 190,453.001
DATE: DECEMBER 5, 2003
SCALE: AS SHOWN
DRAWN BY: P.N.UU
DESIGNED BY: R.M.HYER, P.E.
CHECKED BY: J.L.ROBBINS, P.E.
NO ALTERATION PERMITTED HEREON EXCEPT AS PROVIDED UNDER SECTION 2209 SUBDIVISION 2 OF THE NEW YORK EDUCATION LAW

ELECTRICAL
MAXCY
FIRST FLOOR
PLAN


E-201-5c

C3 MAXCY - PARTIAL FIRST FLOOR PLAN
SCALE: 1/8" = 1'-0"


MATCH LINE
SEE E-201-5A

GENERAL NOTE
1. PANELS R1 AND R2 NOT LABELED IN FIELD. R1 STANDS FOR ICE RINK.


- DRAWING SPECIFIC NOTES:
- 1 REMOVE EXISTING PANELBOARD IN THIS LOCATION AND REPLACE WITH NEW PANEL BOARD AS SHOWN.
 - 2 REMOVE EXISTING MOTOR STARTERS REPLACE WITH NEMA SIZE 2 COORDINATION STARTERS IN NEMA 4X ENCLOSURES. RECONNECT EXISTING CONTROLS.
 - 3 EXISTING MOTOR STARTERS REMAIN.
 - 4 REMOVE EXISTING MOTOR STARTERS REPLACE WITH NEMA SIZE 1 COORDINATION STARTERS IN NEMA 4X ENCLOSURES. RECONNECT EXISTING CONTROLS.
 - 5 REMOVE EXISTING FUSED DISCONNECT SWITCH REPLACE WITH 200 AMP, 3 POLE UNFUSED SWITCH.
 - 6 PROVIDE CIRCUIT BREAKER IN SPACE IN EXISTING SWITCHBOARD. SEE SHEET E-201-5A ONE LINE DIAGRAM.
 - 7 PROVIDE DISTRIBUTION PANEL DPH. SEE PANEL SCHEDULE ON E-201-5A.
 - 8 REMOVE EXISTING 45 KVA TRANSFORMER MOUNTED ON FRAME SUPPORTED FROM CEILING. REMOVE FRAME.
 - 9 PROVIDE 112.5 KVA TRANSFORMER. PROVIDE NEW TRAPEZOID MOUNT. SEE DETAIL ON SHEET E-201-5A.

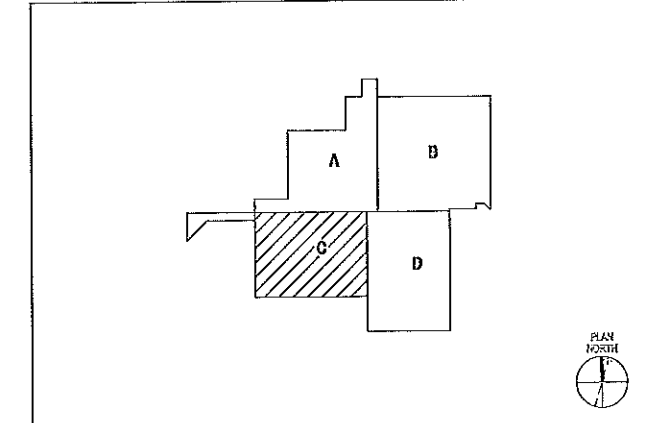


A4 KEY PLAN
SCALE: 1/8" = 1'-0"

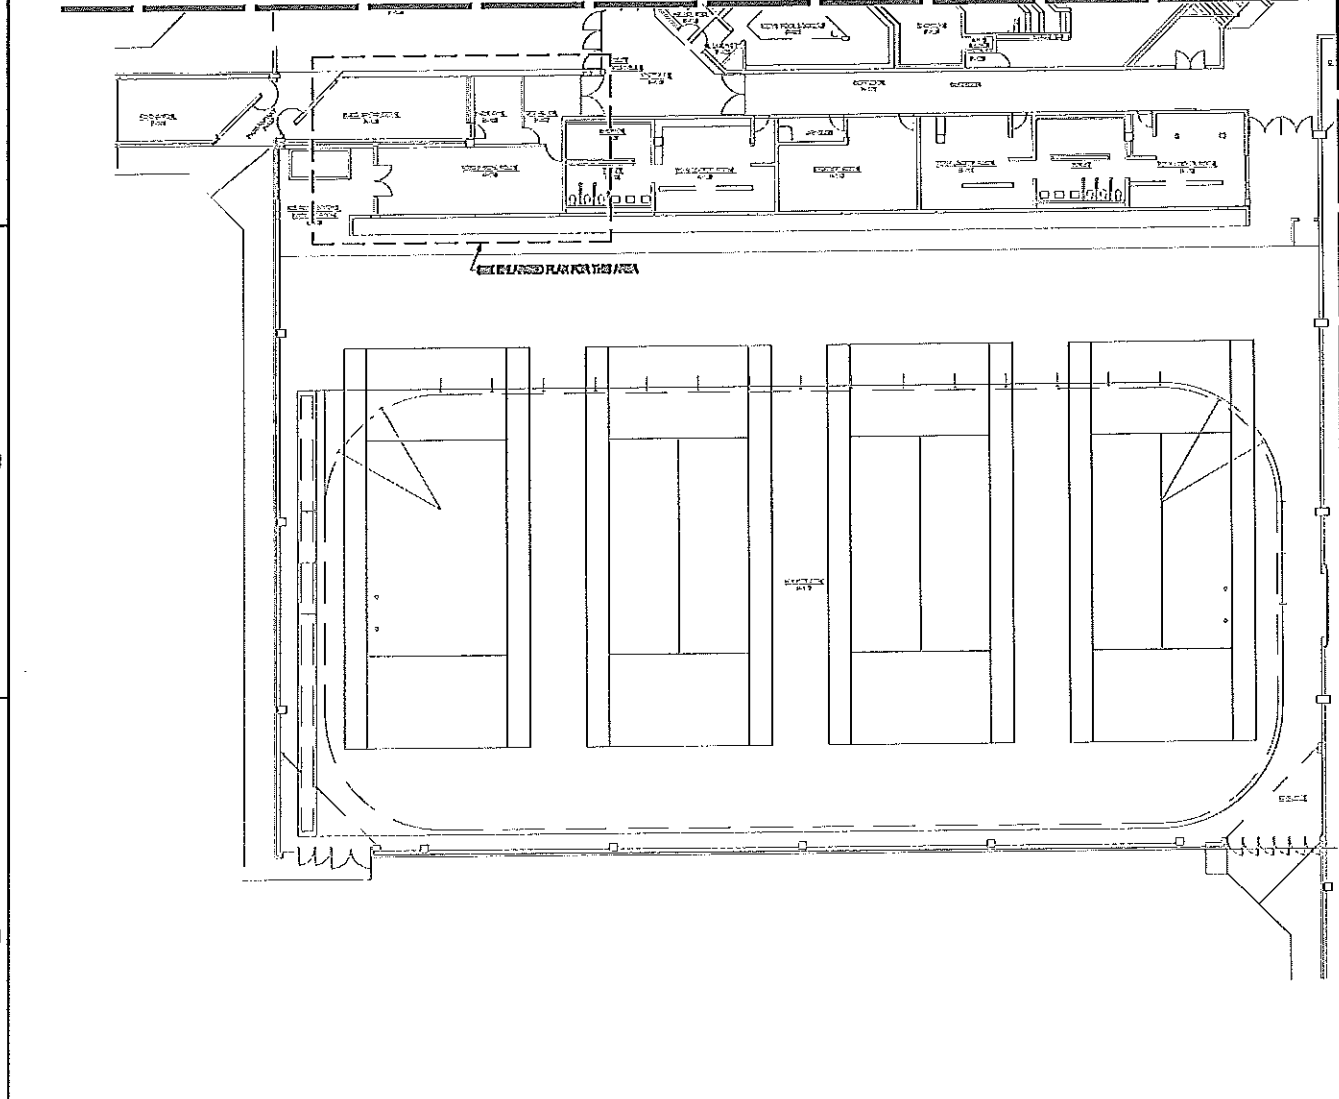

A1 MAXCY - FIRST FLOOR PLAN
SCALE: 1/8" = 1'-0"

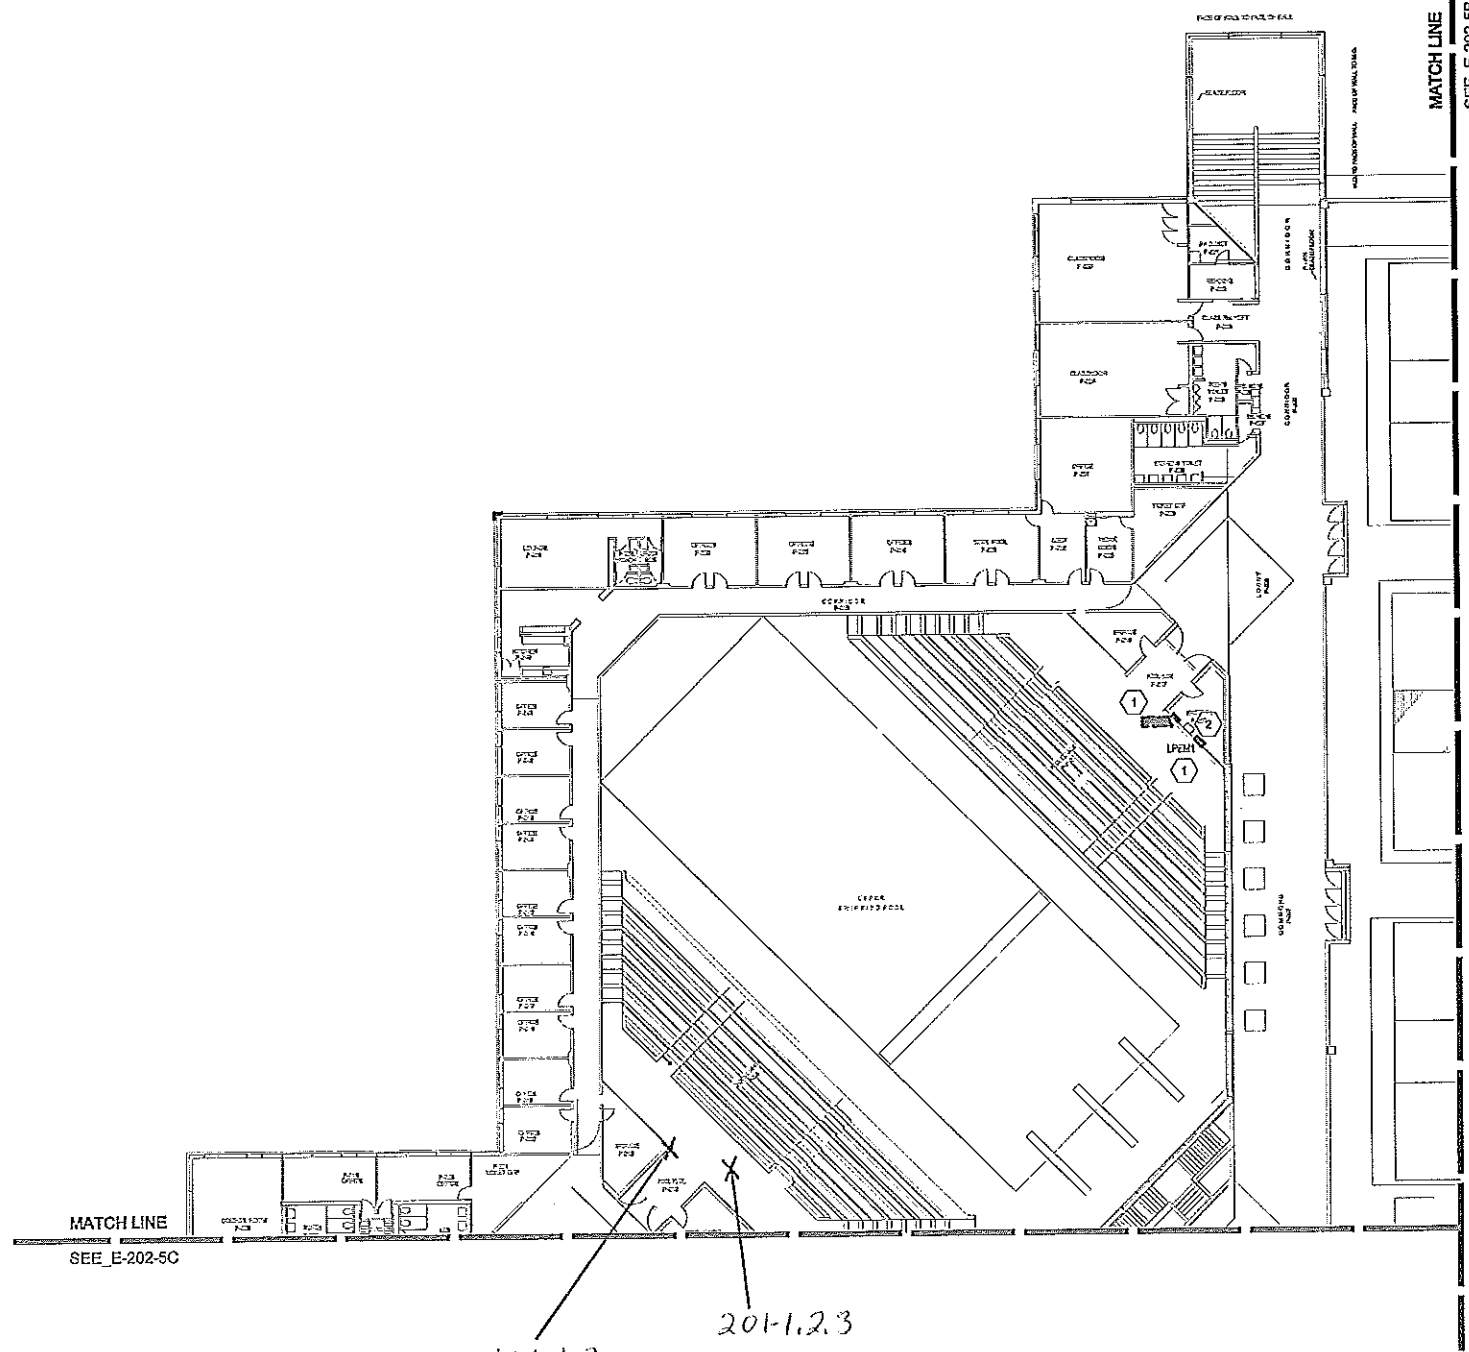

- DRAWING SPECIFIC NOTES:
- 1 REMOVE EXISTING PANELBOARD IN THIS LOCATION AND REPLACE WITH NEW PANEL BOARD AS SHOWN.
 - 2 EMERGENCY RELAY PANEL AND TRANSFORMER AS SHOWN.

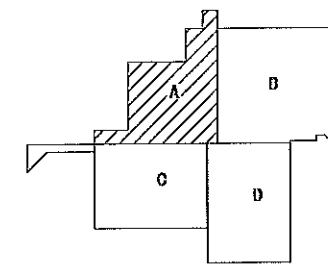

C&S Engineers, Inc.
 499 Col. Elmer Collins Blvd.
 Syracuse, New York 13212
 Phone: 315-455-2000
 Fax: 315-455-9001
 WWW.CS00S.COM



STATE UNIVERSITY CONSTRUCTION FUND
 NEW YORK

STATE UNIVERSITY CONSTRUCTION FUND
 SUCF PROJECT NO. 12290
 STATE UNIVERSITY OF NEW YORK AT POTSDAM
 PRE-BID SUBMISSION - NOT FOR CONSTRUCTION
 UPGRADE ELECTRICAL DISTRIBUTION SYSTEMS
 VARIOUS BUILDINGS

MARK	DATE	DESCRIPTION
REVISIONS		
1		
2		
3		
4		
5		
6		
7		
8		
9		
10		


PROJECT NO: 199453.001
 DATE: DECEMBER 5, 2003
 SCALE: AS SHOWN
 DRAWN BY: P.H.W.
 DESIGNED BY: M.H.W.S., P.E.
 CHECKED BY: J.L. ROSEN, P.E.
 NO ALTERATION PERMITTED HEREON
 EXCEPT AS PROVIDED UNDER SECTION
 7209 SUBDIVISION 2 OF THE NEW YORK
 EDUCATION LAW

ELECTRICAL
MAXCY
SECOND FLOOR
PLAN
E-202-5a

JUL 16, 2004 - 0415pm
 ON DRAWING - SUCF PROJECT NO. 12290
 BY: P.H.W.


A1 MAXCY - SECOND FLOOR PLAN
 SCALE: 1/8" = 1'-0"

A4 KEY PLAN
 SCALE: NOT TO SCALE

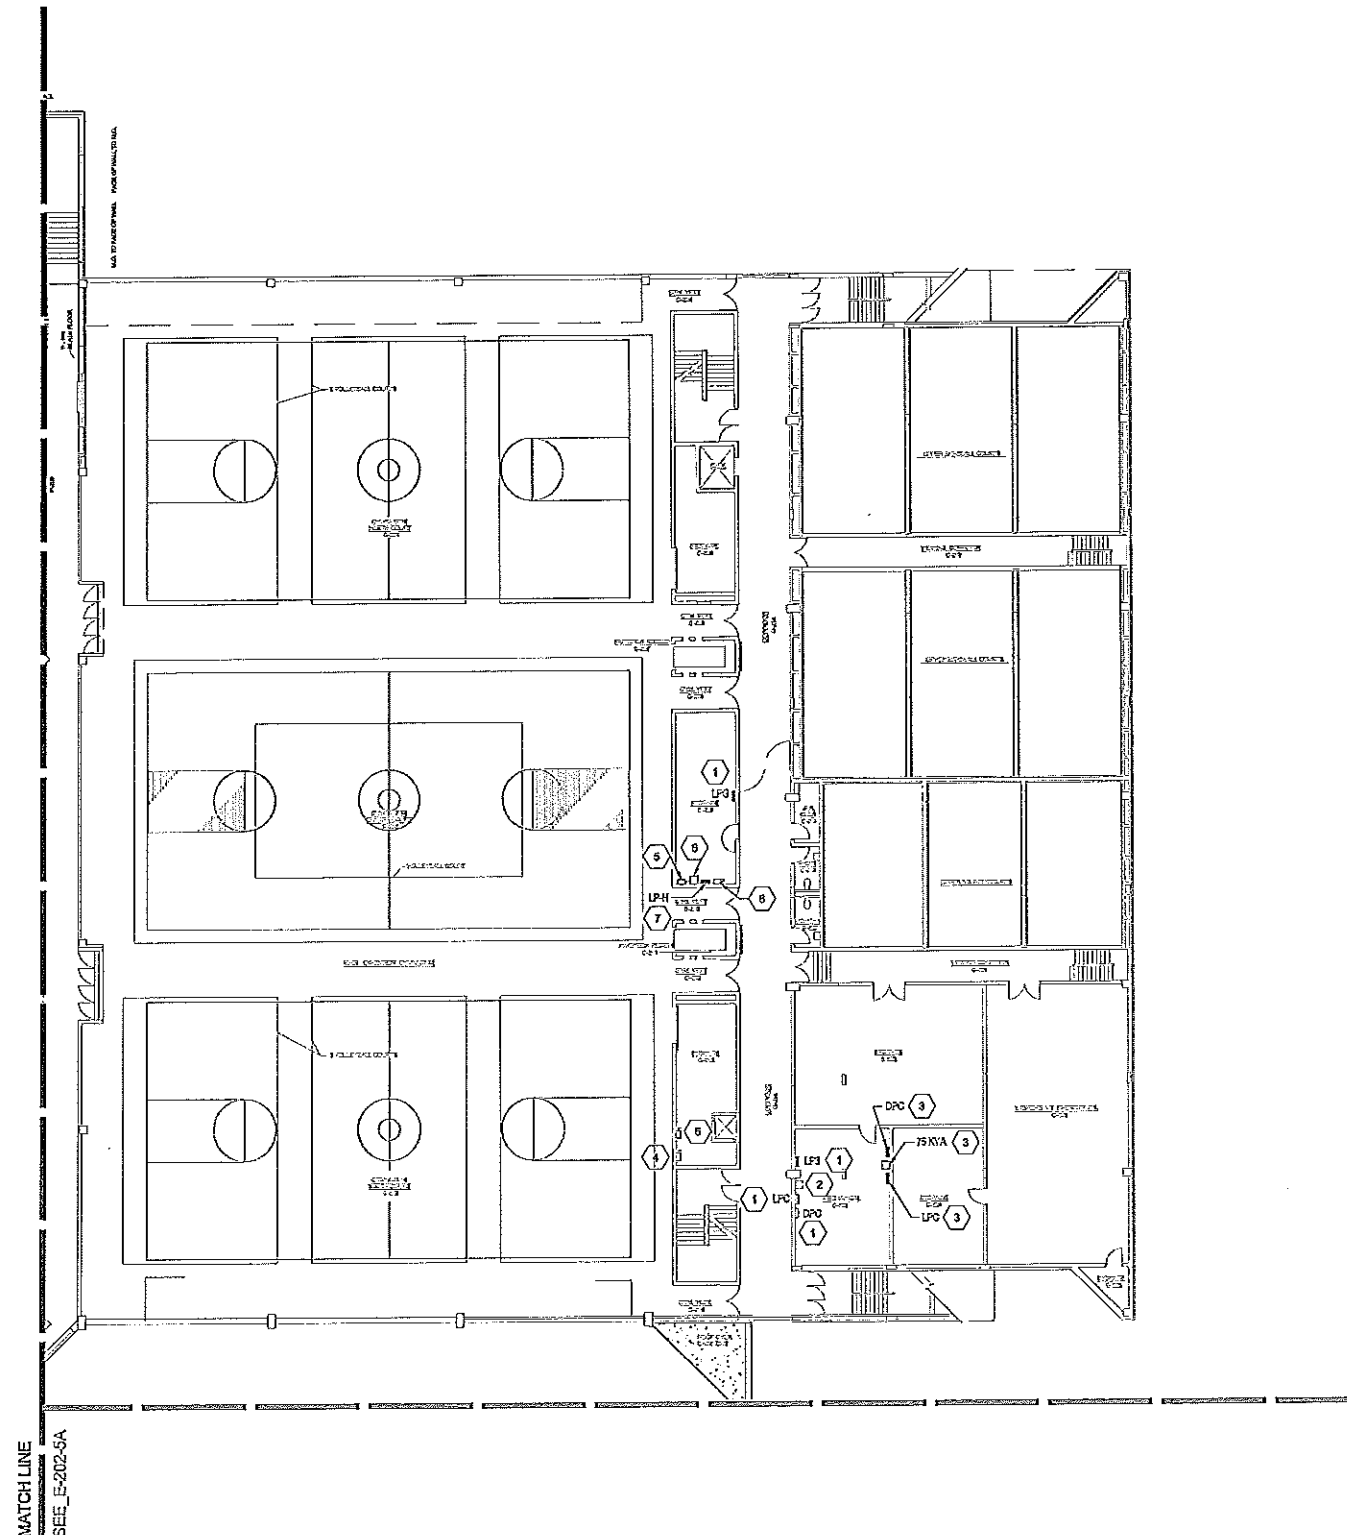

GENERAL NOTE:
1. EXTEND CIRCUITS TO NEW PANELBOARDS AS REQUIRED.

- DRAWING SPECIFIC NOTES:
1. REPAIR EXISTING PANELBOARD IN THIS LOCATION AND REPLACE WITH NEW PANELBOARD AS SHOWN LPO AND DPO TO BE RELOCATED. REPLACEMENT PANELBOARD FOR LPS SHALL BE INSTALLED IN SAME LOCATION AS EXISTING.
 2. REMOVE 40 KVA TRANSFORMER. INSTALL 75 KVA TRANSFORMER RELOCATED FROM ELECTRIC ROOM SHOWN ON SHEET E-202-5A.
 3. NEW LOCATION FOR DPO, LPO, AND TRANSFORMER. EXTEND BRANCH CIRCUITS AS REQUIRED.
 4. EXISTING 200 AMP FUSED SWITCH REMAINS.
 5. PROVIDE 400 AMP UNFUSED SWITCH.
 6. PROVIDE 150 KVA TRANSFORMER.
 7. PROVIDE PANEL LPH.
 8. PROVIDE 200 AMP UNFUSED SWITCH.

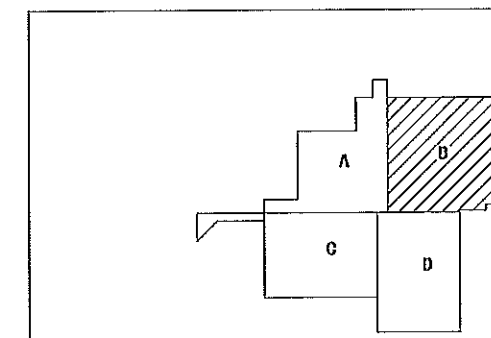

A1 MAXCY - SECOND FLOOR PLAN
SCALE: 1/8" = 1'-0"

A4 KEY PLAN
SCALE: 1/8" = 1'-0"



C&S Companies

C&S Engineers, Inc.
499 Col. Eileen Collins Blvd.
Syracuse, New York 13212
Phone: 315-455-2000
Fax: 315-455-6667
WWW.CS008.COM



STATE UNIVERSITY CONSTRUCTION FUND
NEW YORK

STATE UNIVERSITY CONSTRUCTION FUND
SUCF PROJECT NO. 12290
STATE UNIVERSITY OF NEW YORK AT POTSDAM
PRE-BID SUBMISSION - NOT FOR CONSTRUCTION
UPGRADE ELECTRICAL DISTRIBUTION SYSTEMS
VARIOUS BUILDINGS

MARK	DATE	DESCRIPTION
REVISIONS		
PROJECT NO: 191-453-001		
DATE: DECEMBER 5, 2003		
SCALE: AS SHOWN		
DRAWN BY: P.N. LUN		
DESIGNED BY: R.M. HAYS, P.E.		
CHECKED BY: J.L. ROSS, P.E.		
NO ALTERATION PERMITTED HEREON EXCEPT AS PROVIDED UNDER SECTION 7203 SUBDIVISION 2 OF THE NEW YORK EDUCATION LAW		

ELECTRICAL


MAXCY
SECOND FLOOR
PLAN

E-202-5b



C&S Engineers, Inc.
499 Col. Elsen Collins Blvd.
Syosset, New York 11791
Phone: 315-455-2000
Fax: 315-455-9687
www.cscos.com

INSERT C&S
FE SEAL HERE

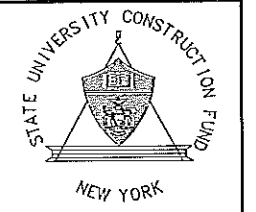


STATE UNIVERSITY CONSTRUCTION FUND
SUFC PROJECT NO. 12290
STATE UNIVERSITY OF NEW YORK AT POTSDAM
PRE-BID SUBMISSION - NOT FOR CONSTRUCTION
UPGRADE ELECTRICAL DISTRIBUTION SYSTEMS
VARIOUS BUILDINGS

MARK	DATE	DESCRIPTION
REVISIONS		
PROJECT NO:	190.631.001	
DATE:	DECEMBER 5, 2003	
SCALE:	AS SHOWN	
DRAWN BY:	P.N. LUU	
DESIGNED BY:	M.R. HAYES, P.E.	
CHECKED BY:	J.L. ROSS, P.E.	
NO ALTERATION PERMITTED HEREIN EXCEPT AS PROVIDED UNDER SECTION 7209 SUBDIVISION 2 OF THE NEW YORK EDUCATION LAW		


ELECTRICAL
MAXCY
SECOND FLOOR
PLAN

E-202-5c

Copyright ©


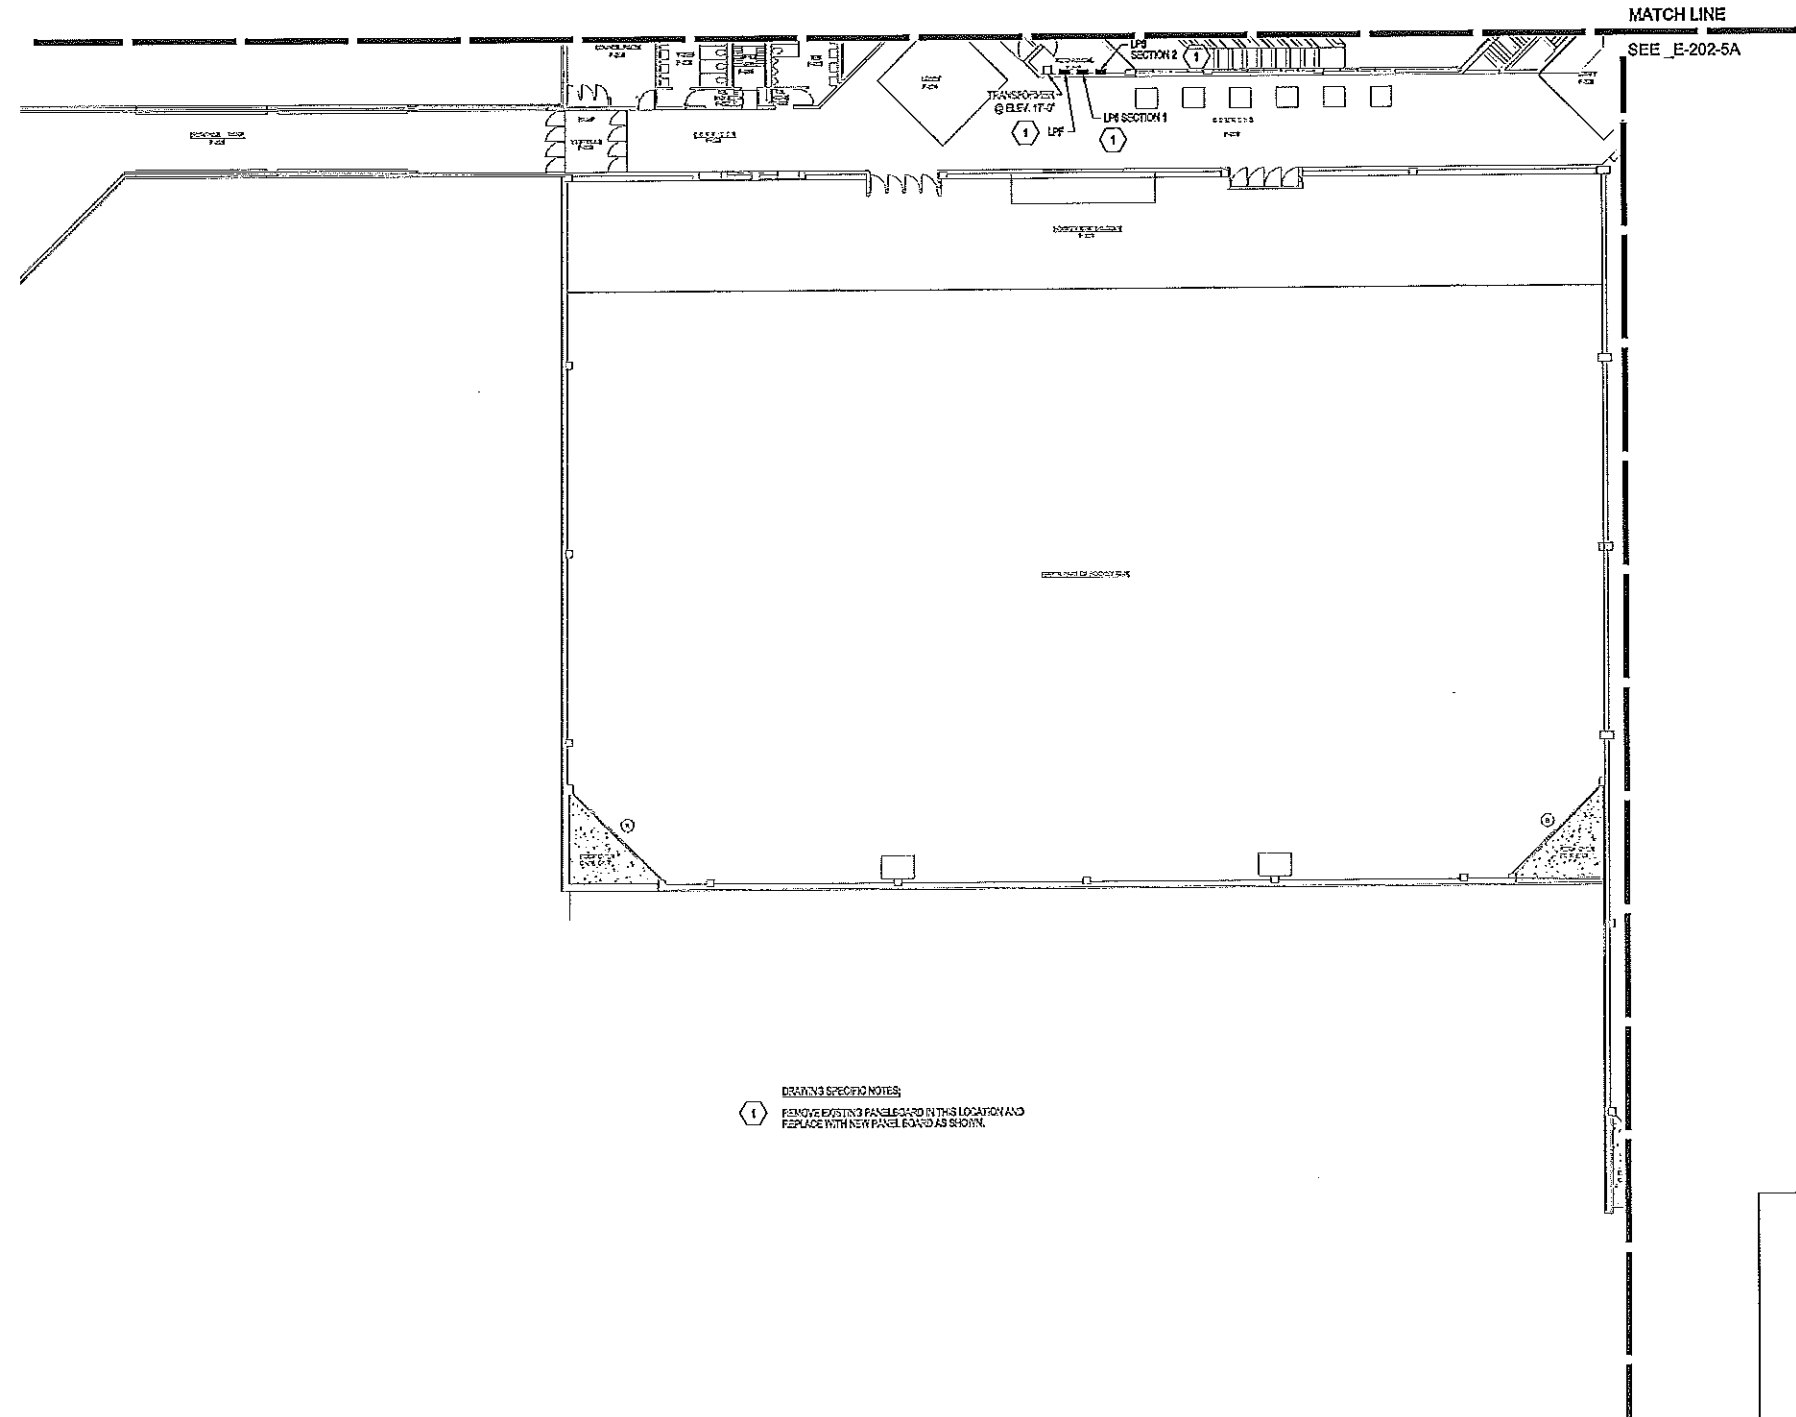


1. REMOVE EXISTING PANELBOARD IN THIS LOCATION AND
REPLACE WITH NEW PANELBOARD AS SHOWN.

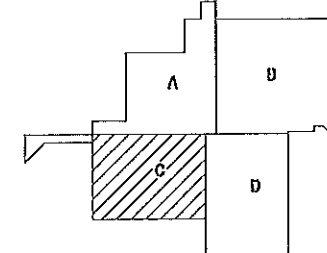


A1 MAXCY - SECOND FLOOR PLAN
SCALE: 1/8" = 1'-0"


A4 KEY PLAN
SCALE: 1/8" = 1'-0"

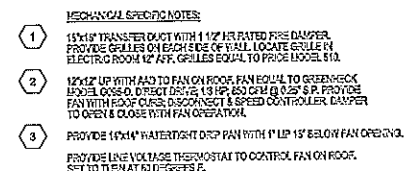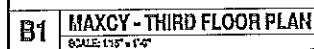

A1	ELECTRIC ROOM - MECHANICAL PLAN SHEET 15 OF 17
----	---

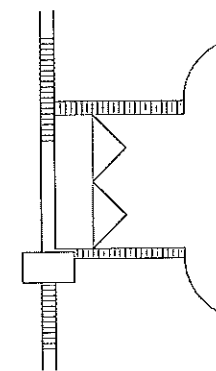


D3	ELECTRIC ROOM - DEMOLITION PLAN SCALE: 1/8" = 1'-0"
-----------	---

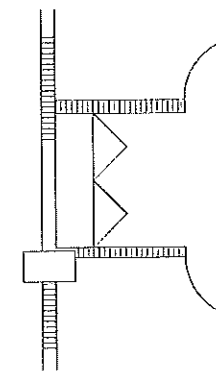

C3	ELECTRIC ROOM - FLOOR PLAN
----	----------------------------

A4	KEY PLAN SCALE: NOT TO SCALE
----	---------------------------------

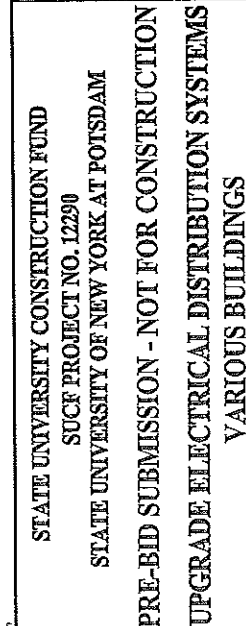

MARK	DATE	DESCRIPTION
FEYSIONS		
PROJECT NO: 190-633,001		
DATE: DECEMBER 5, 2003		
SCALE: AS SHOWN		
DRAWN BY: P.N. WAJ		
DESIGNED BY: M.R. HAYES, P.E.		
CHECKED BY: J.L. ROSSINI, P.E.		
NO ALTERATION PERMITTED HEREON EXCEPT AS PROVIDED UNDER SECTION 2209 SUBDIVISION 2 OF THE NEW YORK EDUCATION LAW		

ELECTRICAL

MAXCY
THIRD FLOOR
PLANS

E-203-5b

C&S
COMPANIES

C&S Engineers, Inc.
499 Col. Eileen Collins Blvd.
Syracuse, New York 13212
Phone: 315-455-2000
Fax: 315-455-0667
www.cscos.com




STATE UNIVERSITY CONSTRUCTION FUND
SUCF PROJECT NO. 12290
STATE UNIVERSITY OF NEW YORK AT POTSDAM
PRE-BID SUBMISSION - NOT FOR CONSTRUCTION
UPGRADE ELECTRICAL DISTRIBUTION SYSTEMS
VARIOUS BUILDINGS


MARK	DATE	DESCRIPTION
REVISIONS		
PROJECT NO.	190,453,001	
DATE:	DECEMBER 5, 2003	
SCALE:	AS SHOWN	
DRAWN BY:	P.N.UJ	
DESIGNED BY:	TOHLUNIEWICZ, MARIANNA, P.E.	
CHECKED BY:	J.L. ROSEN, P.E.	
NO ALTERATION PERMITTED HEREON EXCEPT AS PROVIDED UNDER SECTION 7209 SUBDIVISION 2 OF THE NEW YORK EDUCATION LAW		

ELECTRICAL
CRANE MUSIC COMPLEX
BASEMENT PLANS


E-100-9a

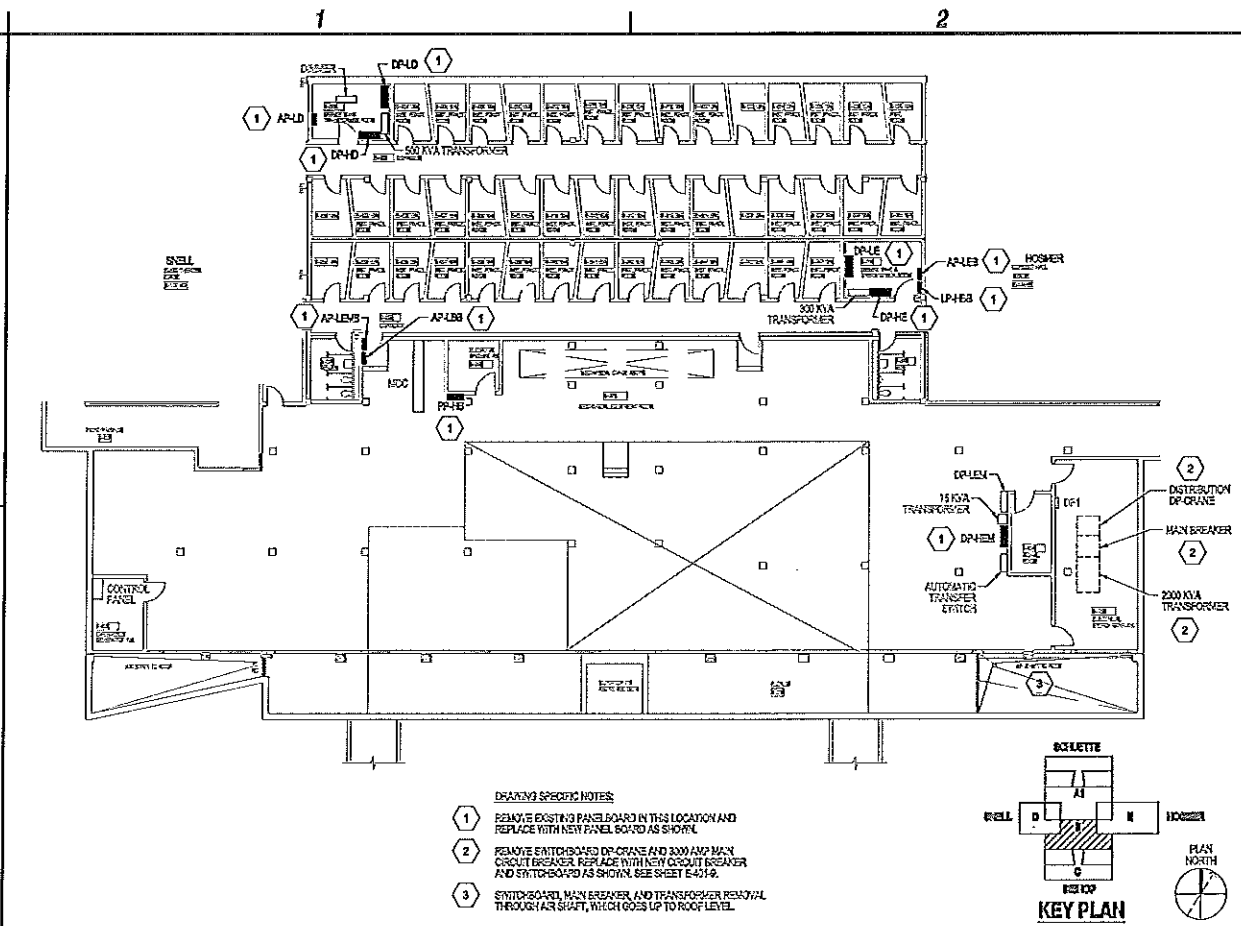

C1 CRANE MUSIC COMPLEX - BUILDING "B" BASEMENT PLAN
SCALE: 1/8" = 1'-0"

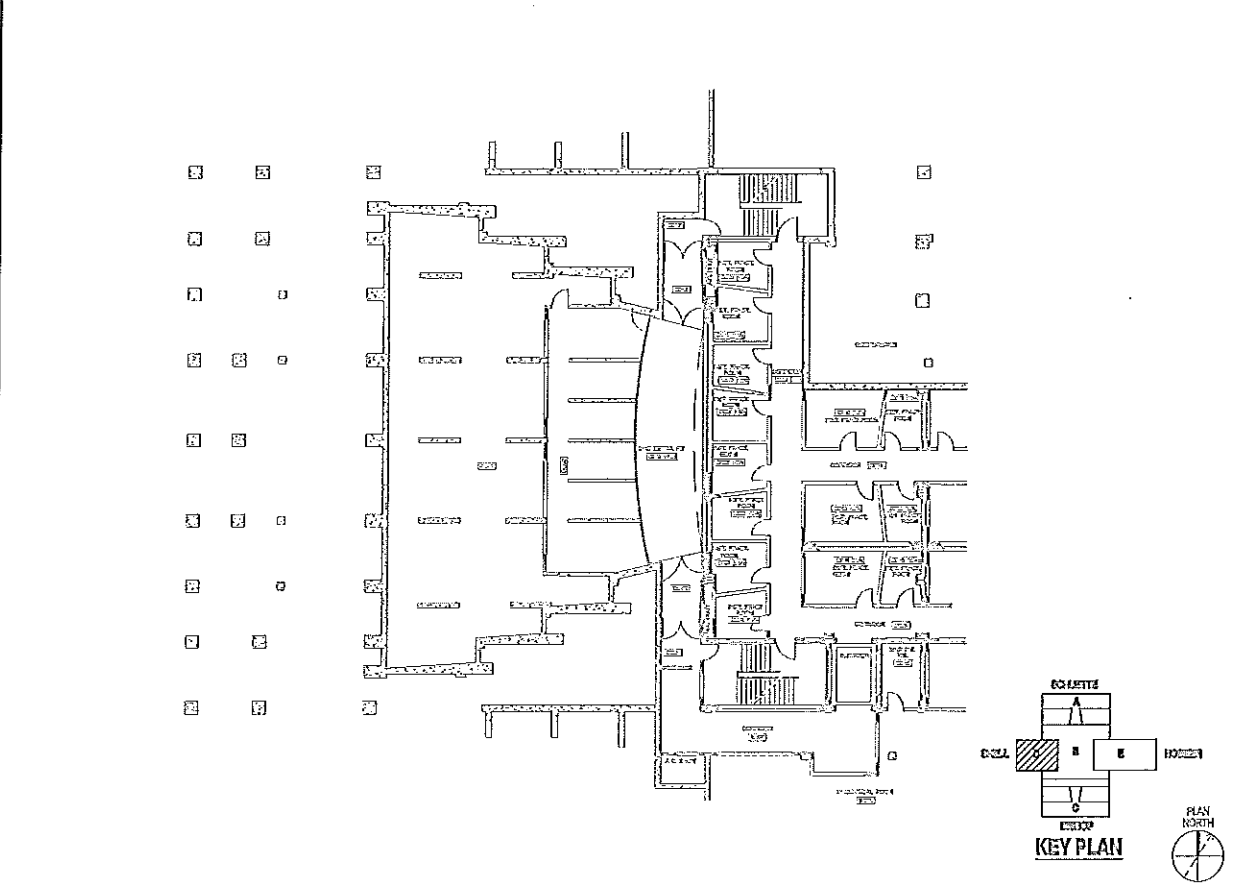

A1 CRANE MUSIC COMPLEX - SNELL BASEMENT PLAN
SCALE: 1/8" = 1'-0"

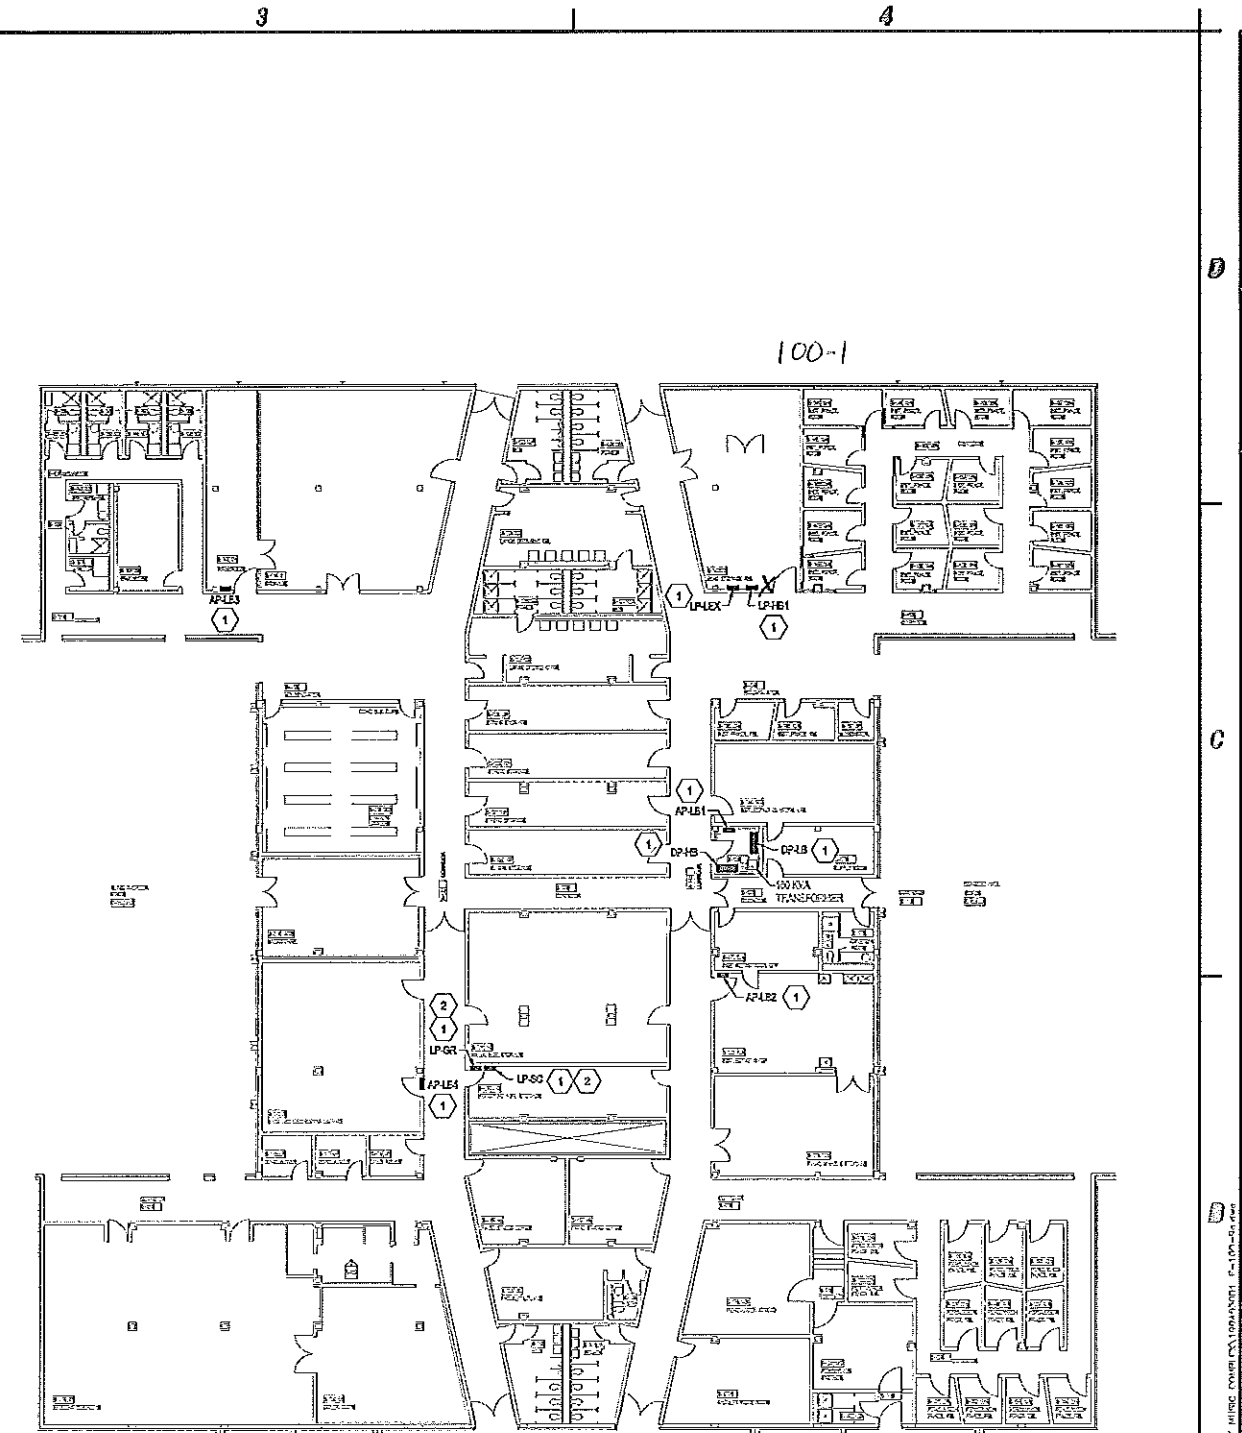

A3 CRANE MUSIC COMPLEX - BUILDING "B" LOWER LEVEL PLAN
SCALE: 1/8" = 1'-0"



C&S Engineers, Inc.
499 Col. Ellen Collins Blvd.
Syracuse, New York 13212
Phone: 315-455-2000
Fax: 315-455-9587
WWW.CS008.COM

PROJECT C&S
FE 520-9692




STATE UNIVERSITY CONSTRUCTION FUND
SUCF PROJECT NO. 12290
STATE UNIVERSITY OF NEW YORK AT POTSDAM
PRE-BID SUBMISSION - NOT FOR CONSTRUCTION
UPGRADE ELECTRICAL DISTRIBUTION SYSTEMS
VARIOUS BUILDINGS


MARK	DATE	DESCRIPTION
REVISIONS		
1	DECEMBER 5, 2003	PROJECT NO. 191453.001
2	AS SHOWN	SCALE: AS SHOWN
3		DRAWN BY: P.H. LUU
4		DESIGNED BY: TOLKRENCZ, MAHYESPE
5		CHECKED BY: J.L. ROBERTS, P.E.
NO ALTERATION PERMITTED HEREON EXCEPT AS PROVIDED UNDER SECTION 7209 SUBDIVISION 2 OF THE NEW YORK EDUCATION LAW		

ELECTRICAL
CRANE MUSIC COMPLEX
FIRST FLOOR PLANS


E-100-9b

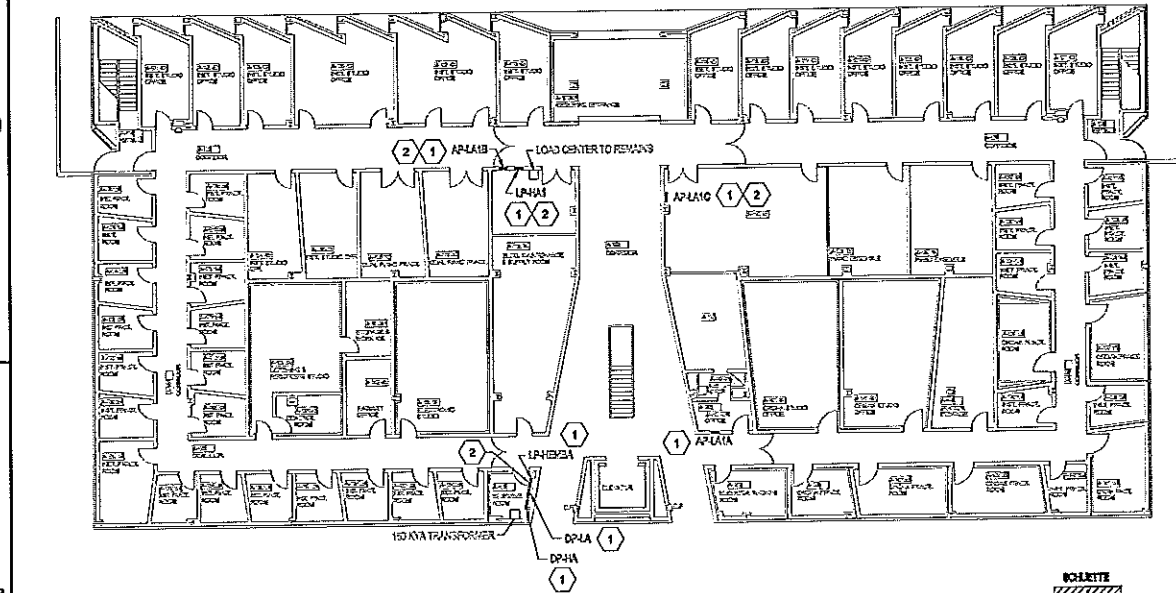


- DRAWING SPECIFICATIONS:
- 1 REMOVE EXISTING PANEL BOARD IN THIS LOCATION AND REPLACE WITH NEW PANEL BOARD AS SHOWN.
 - 2 SEE DETAIL D5-A-601 FOR ARCHITECTURAL WORK.

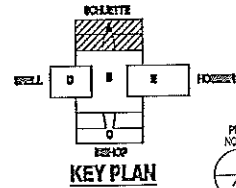


C1 CRANE MUSIC COMPLEX - SCHUETTE LOWER LEVEL PLAN
SCALE 1/8" = 1'-0"

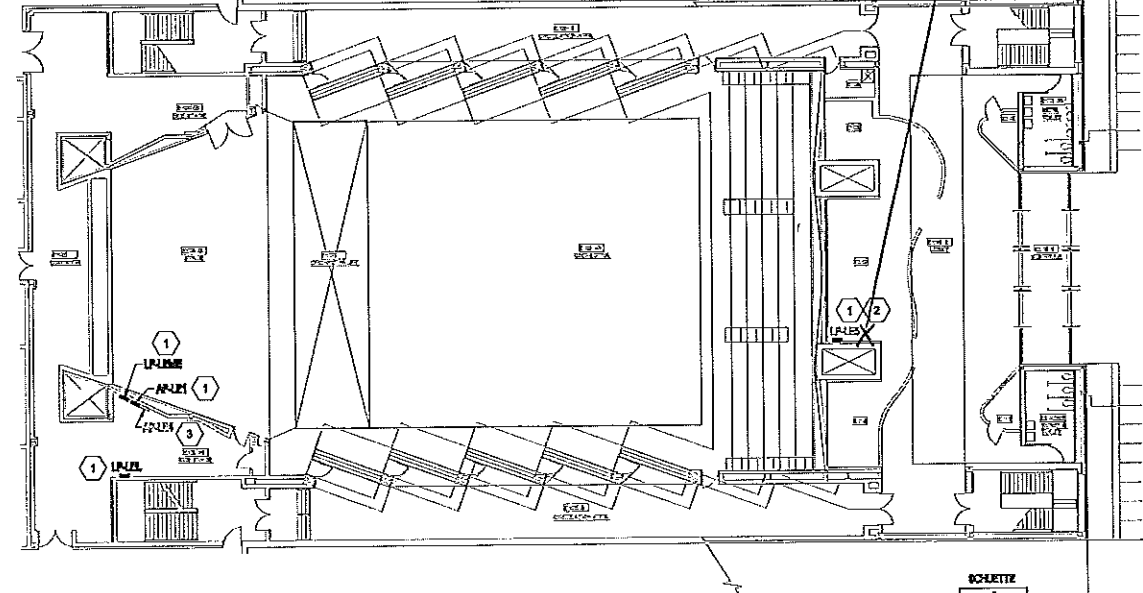


- DRAWING SPECIFICATIONS:
- 1 REMOVE EXISTING PANEL BOARD IN THIS LOCATION AND REPLACE WITH NEW PANEL BOARD AS SHOWN.
 - 2 REMOVE TO 100 AMP.
 - 3 REMOVE.

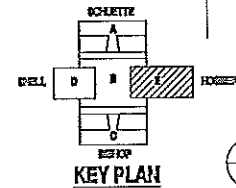


C3 CRANE MUSIC COMPLEX - HOSMER ORCHESTRA LEVEL FLOOR PLAN
SCALE 1/8" = 1'-0"

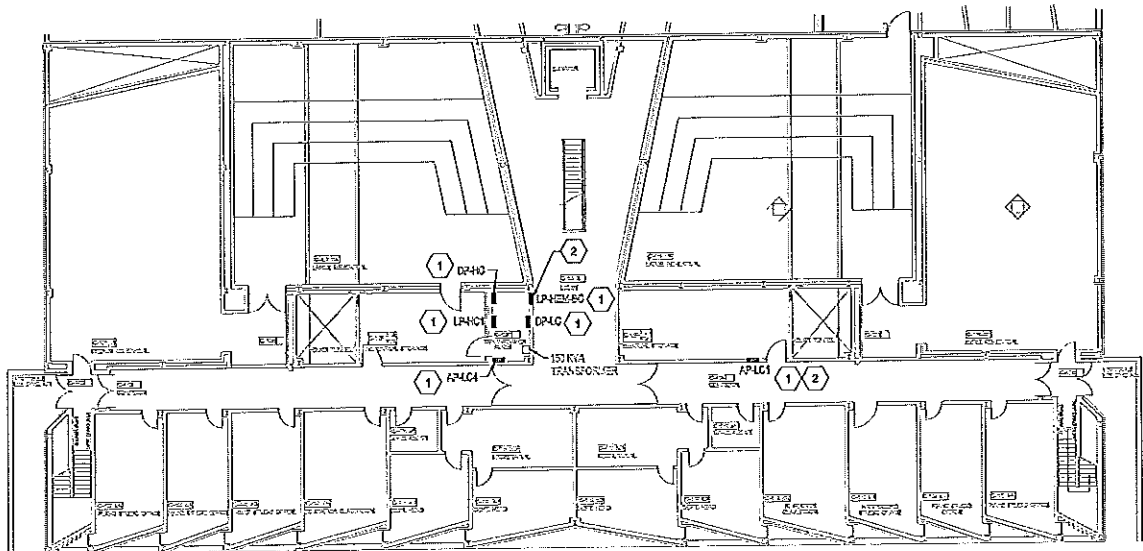


- DRAWING SPECIFICATIONS:
- 1 REMOVE EXISTING PANEL BOARD IN THIS LOCATION AND REPLACE WITH NEW PANEL BOARD AS SHOWN.
 - 2 SEE DETAIL D5-A-601 FOR ARCHITECTURAL WORK.

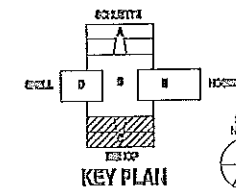


A1 CRANE MUSIC COMPLEX - BISHOP LOWER LEVEL FLOOR PLAN
SCALE 1/8" = 1'-0"

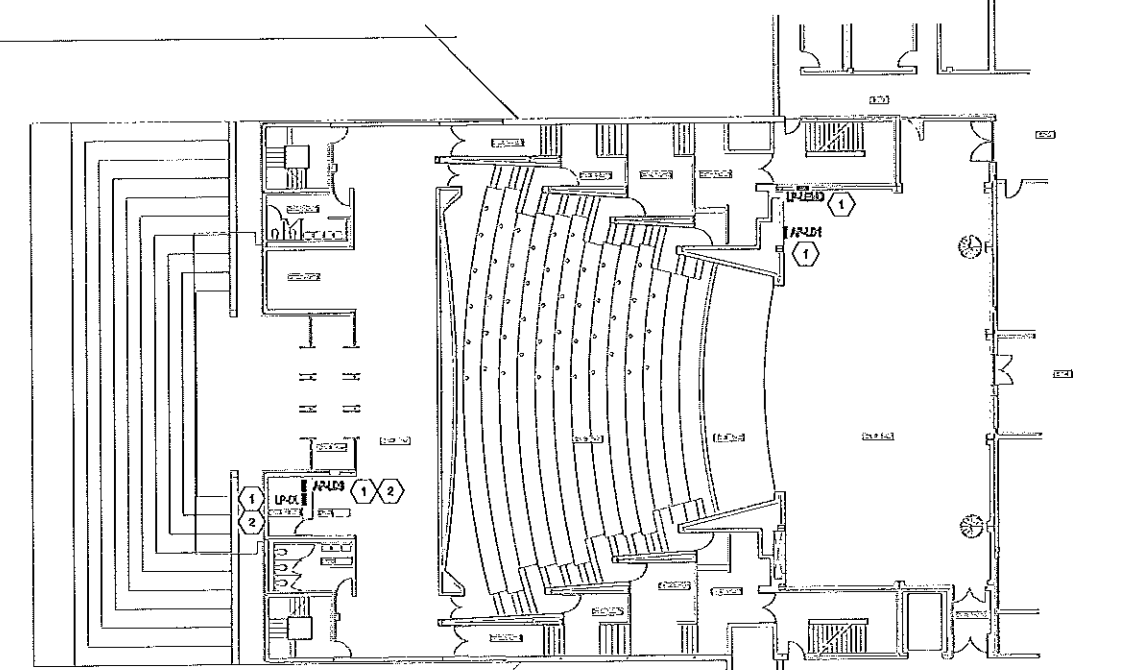


- DRAWING SPECIFICATIONS:
- 1 REMOVE EXISTING PANEL BOARD IN THIS LOCATION AND REPLACE WITH NEW PANEL BOARD AS SHOWN.
 - 2 SEE DETAIL D5-A-601 FOR ARCHITECTURAL WORK.

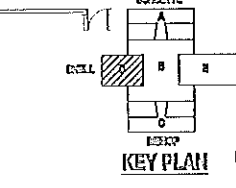


A3 CRANE MUSIC COMPLEX - SNELL ORCHESTRA LEVEL FLOOR PLAN
SCALE 1/8" = 1'-0"

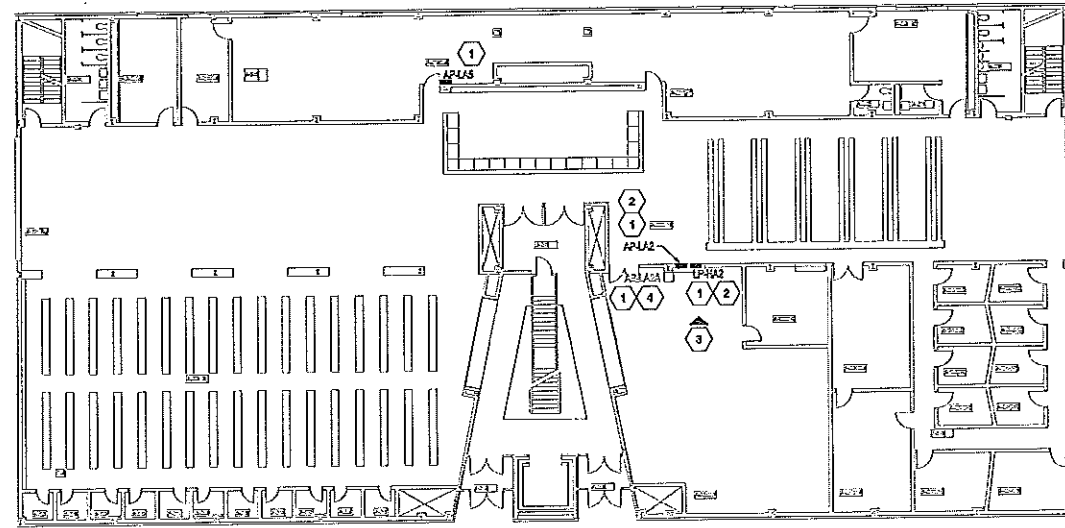


- DRAWING SPECIFIC NOTES:**
- 1 REMOVE EXISTING PANEL BOARD IN THIS LOCATION AND REPLACE WITH NEW PANEL BOARD AS SHOWN.
 - 2 SEE DETAIL D3-551 FOR ARCHITECTURAL WORK.
 - 3 SEE PHOTO A1-551.
 - 4 REMOVE TO APPLA, EXISTING PANEL REMAINS.

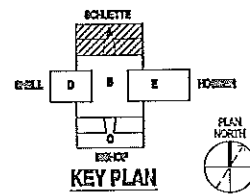


C1 CRANE MUSIC COMPLEX - SCHUETTE PLAZA LEVEL FLOOR PLAN
SCALE: 1/8" = 1'-0"

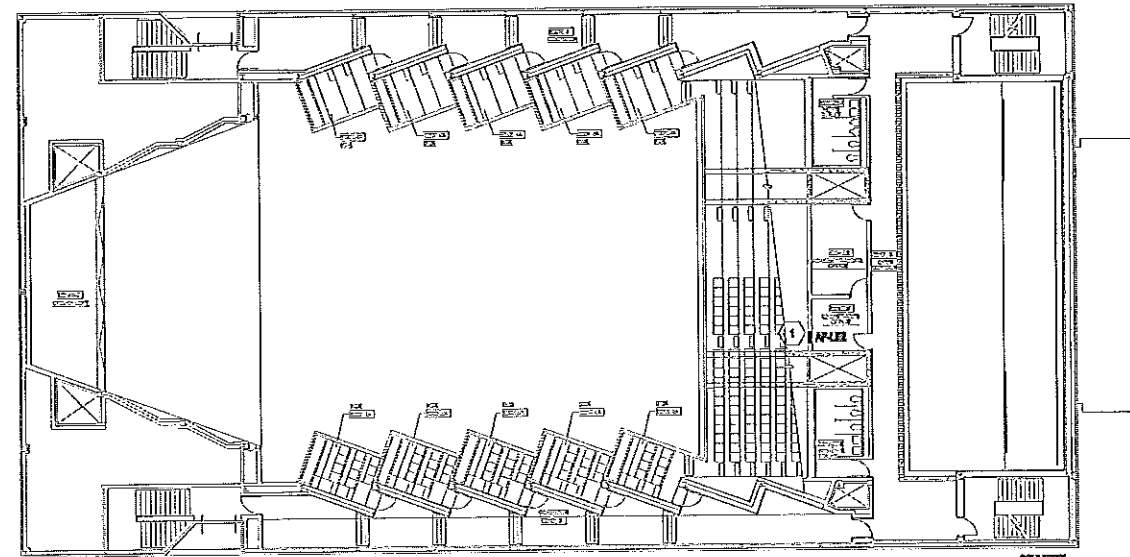


- DRAWING SPECIFIC NOTES:**
- 1 REMOVE EXISTING PANEL BOARD IN THIS LOCATION AND REPLACE WITH NEW PANEL BOARD AS SHOWN.

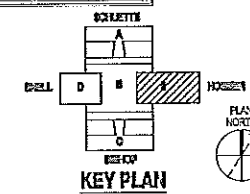


C3 CRANE MUSIC COMPLEX - HOSMER SECOND FLOOR PLAN
SCALE: 1/8" = 1'-0"

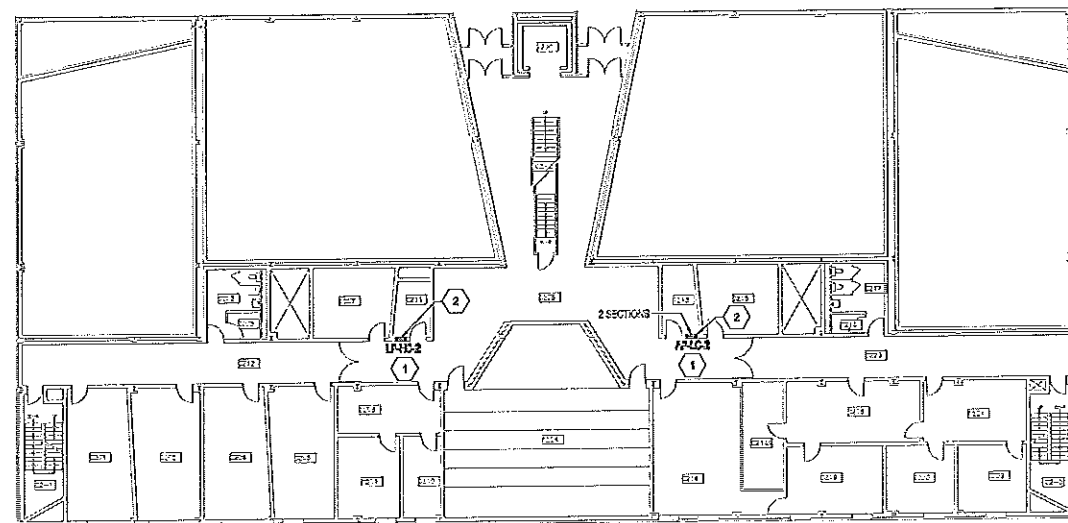


- DRAWING SPECIFIC NOTES:**
- 1 REMOVE EXISTING PANEL BOARD IN THIS LOCATION AND REPLACE WITH NEW PANEL BOARD AS SHOWN.
 - 2 SEE DETAIL D3-551 FOR ARCHITECTURAL WORK.

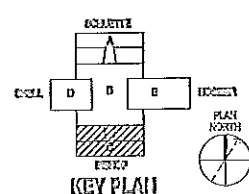

A1 CRANE MUSIC COMPLEX - BISHOP PLAZA LEVEL FLOOR PLAN
SCALE: 1/8" = 1'-0"

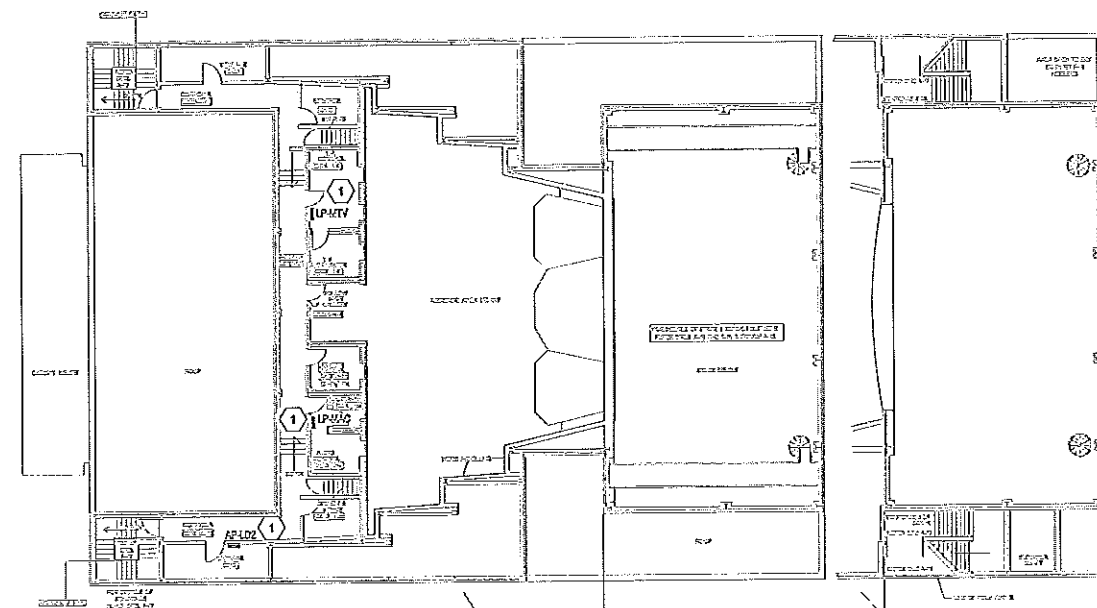


- DRAWING SPECIFIC NOTES:**
- 1 REMOVE EXISTING PANEL BOARD IN THIS LOCATION AND REPLACE WITH NEW PANEL BOARD AS SHOWN.

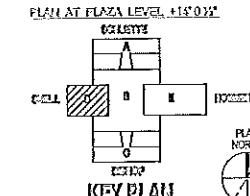

A3 CRANE MUSIC COMPLEX - SHELL, UPPER LEVEL FLOOR PLAN
SCALE: 1/8" = 1'-0"



C&S Engineers, Inc.
499 Col. Elton Collins Blvd.
Syracuse, New York 13212
Phone: 315-455-2000
Fax: 315-455-9887
WWW.CSOS.COM

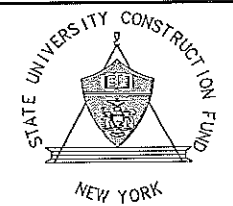


STATE UNIVERSITY CONSTRUCTION FUND
SUCF PROJECT NO. 12290
STATE UNIVERSITY OF NEW YORK AT POTSDAM
PRE-BID SUBMISSION - NOT FOR CONSTRUCTION
UPGRADE ELECTRICAL DISTRIBUTION SYSTEMS
VARIOUS BUILDINGS


MARK	DATE	DESCRIPTION
REVISIONS		
PROJECT NO:	19043001	
DATE:	DECEMBER 5, 2003	
SCALE:	AS SHOWN	
DRAWN BY:	P.N.U.	
DESIGNED BY:	TOMUKEWICZ/ARPADES, P.E.	
CHECKED BY:	J.L. ROSSAS, P.E.	
NO ALTERATION PERMITTED HEREON EXCEPT AS PROVIDED UNDER SECTION 2209 SUBDIVISION 2 OF THE NEW YORK EDUCATION LAW		

ELECTRICAL
CRANE MUSIC COMPLEX
SECOND FLOOR PLANS



E-100-9c

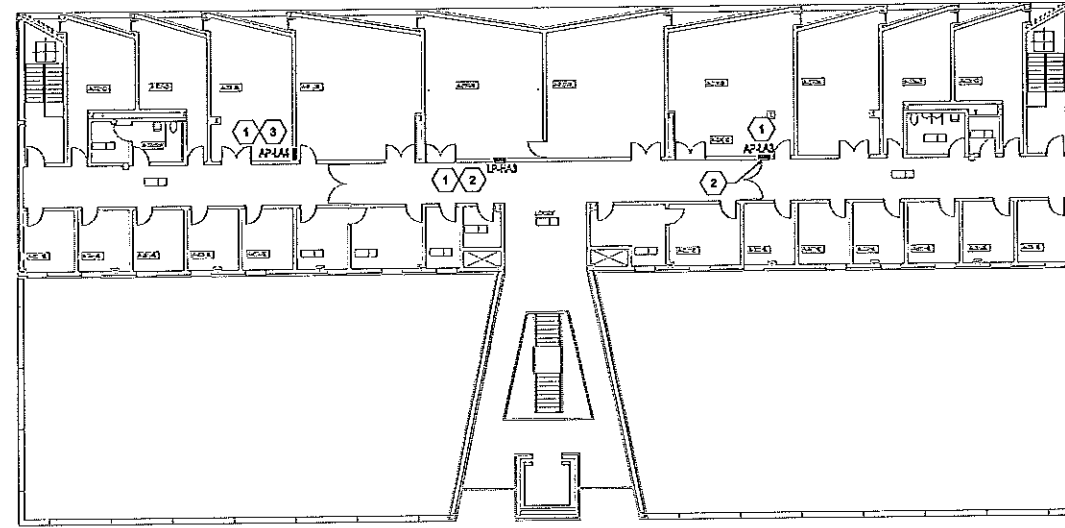


- DRAWING SPECIFIC NOTES:**
- 1 REMOVE EXISTING PANELBOARD IN THIS LOCATION AND REPLACE WITH NEW PANEL BOARD AS SHOWN.
 - 2 SEE DETAIL DASH-51 FOR ARCHITECTURAL WORK.
 - 3 SEE DETAIL DASH-51 FOR ARCHITECTURAL DRY WALL WORK.

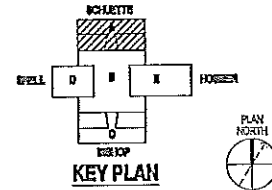


C1 CRANE MUSIC COMPLEX - SCHUETTE UPPER LEVEL FLOOR PLAN
SCALE: 1/16" = 1'-0"

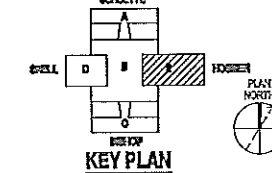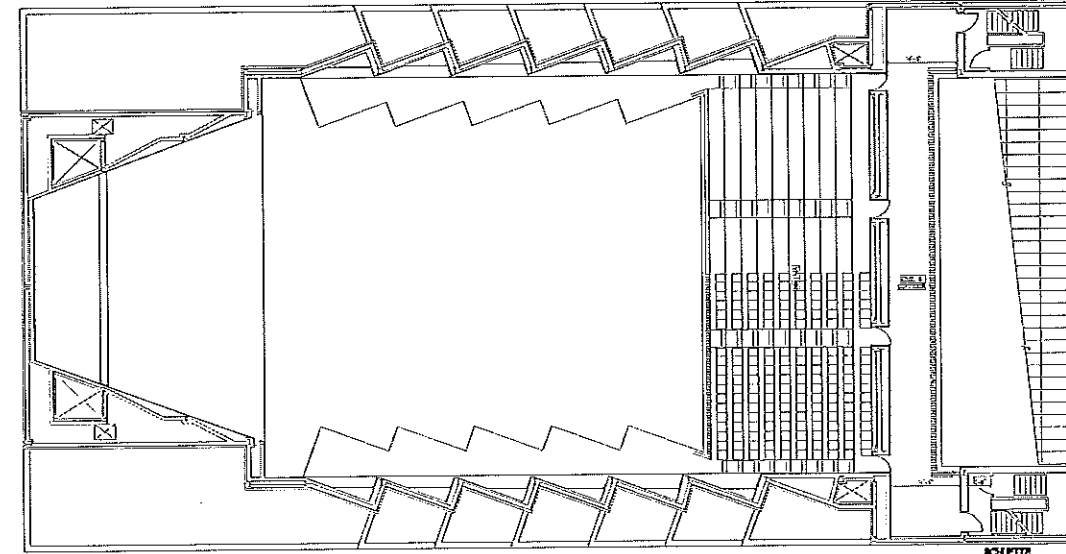


C3 CRANE MUSIC COMPLEX - HOSMER BALCONY LEVEL FLOOR PLAN
SCALE: 1/16" = 1'-0"

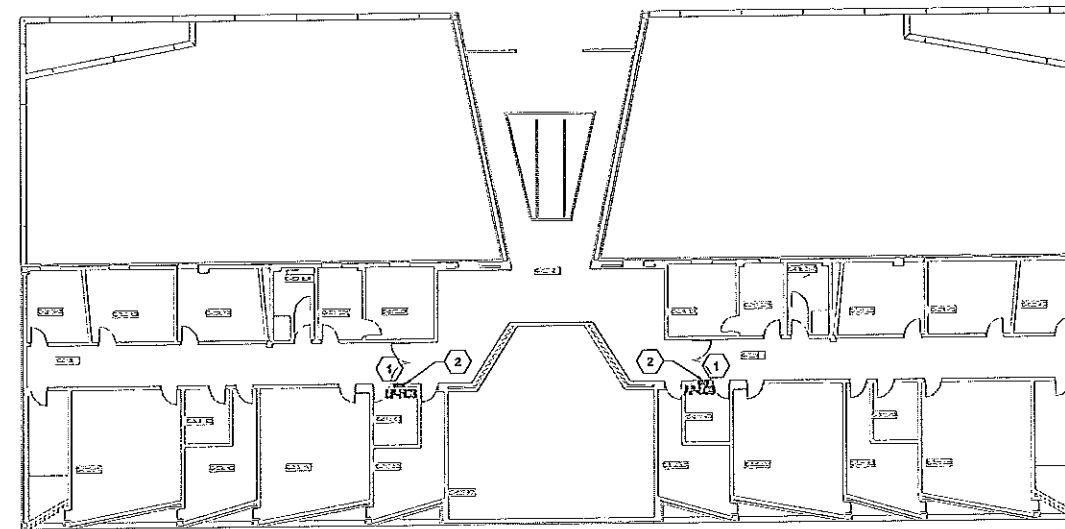


- DRAWING SPECIFIC NOTES:**
- 1 REMOVE EXISTING PANELBOARD IN THIS LOCATION AND REPLACE WITH NEW PANEL BOARD AS SHOWN.
 - 2 SEE DETAIL DASH-51 FOR ARCHITECTURAL WORK.

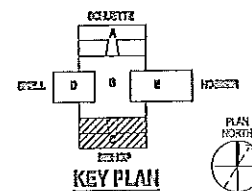

A1 CRANE MUSIC COMPLEX - BISHOP UPPER LEVEL FLOOR PLAN
SCALE: 1/16" = 1'-0"

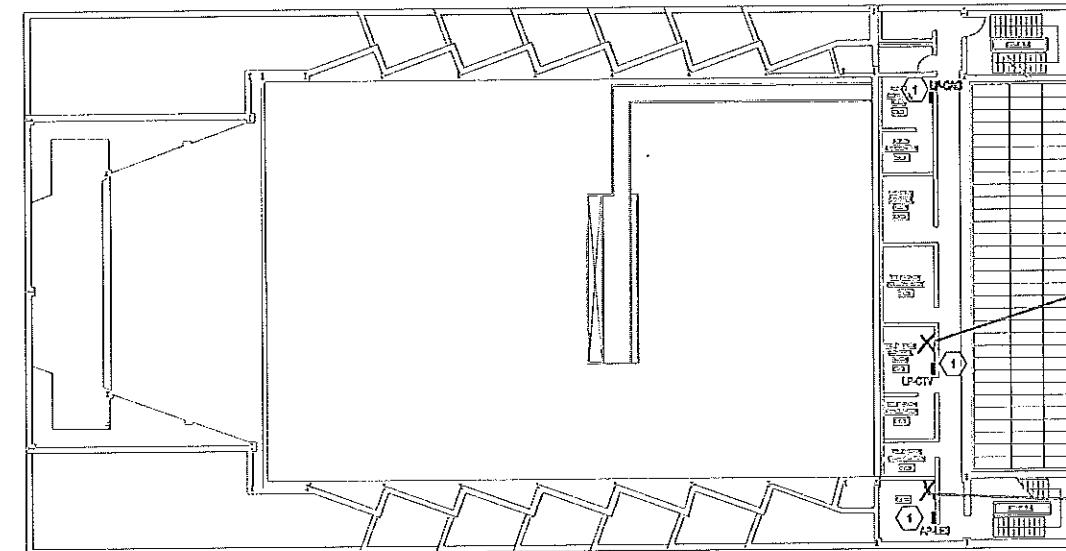

- DRAWING SPECIFIC NOTES:**
- 1 REMOVE EXISTING PANELBOARD IN THIS LOCATION AND REPLACE WITH NEW PANEL BOARD AS SHOWN.

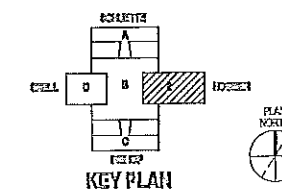


A1 CRANE MUSIC COMPLEX - HOSMER CONTROL LEVEL FLOOR PLAN
SCALE: 1/16" = 1'-0"



C&S Engineers, Inc.
499 Col. Eileen Collins Blvd.
Syracuse, New York 13212
Phone: 315-455-2000
Fax: 315-455-9097
www.csoos.com

INVEST C&S
PE 002 NEPE

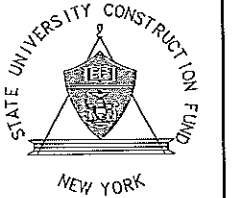

STATE UNIVERSITY CONSTRUCTION FUND
SUCF PROJECT NO. 12290
STATE UNIVERSITY OF NEW YORK AT POTSDAM
PRE-BID SUBMISSION - NOT FOR CONSTRUCTION
UPGRADE ELECTRICAL DISTRIBUTION SYSTEMS
VARIOUS BUILDINGS

MARK	DATE	DESCRIPTION
REVISIONS		
PROJECT NO:	190.453.001	
DATE:	DECEMBER 5, 2003	
SCALE:	AS SHOWN	
DRAWN BY:	P.H. LUU	
DESIGNED BY:	TOLIKIEWICZ, MURRAY, P.E.	
CHECKED BY:	J.L. ROSS, P.E.	
NO ALTERATION PERMITTED HEREON EXCEPT AS PROVIDED UNDER SECTION 7209 SUBDIVISION 2 OF THE NEW YORK EDUCATION LAW		

ELECTRICAL


CRANE MUSIC COMPLEX
THIRD & FOURTH FLOOR PLANS

E-100-9d



C&S Engineers, Inc.
499 Col. Eileen Collins Blvd.
Syracuse, New York 13212
Phone: 315-455-2000
Fax: 315-455-0687
www.cscs.com

INVEST C&S
FE SEE HERE

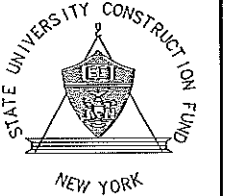

STATE UNIVERSITY CONSTRUCTION FUND
SUCF PROJECT NO. 12290
STATE UNIVERSITY OF NEW YORK AT POTSDAM
PRE-BID SUBMISSION - NOT FOR CONSTRUCTION
UPGRADE ELECTRICAL DISTRIBUTION SYSTEMS
VARIOUS BUILDINGS

MARK	DATE	DESCRIPTION
REVISIONS		
PROJECT NO:	193.453.001	
DATE:	DECEMBER 6, 2009	
SCALE:	AS SHOWN	
DRAWN BY:	P. H. LUM	
DESIGNED BY:	T. C. KILKENNY	
CHECKED BY:	J. L. ROBBINS, P.E.	
NO ALTERATION PERMITTED HEREON EXCEPT AS PROVIDED UNDER SECTION 2209 SUBDIVISION 2 OF THE NEW YORK EDUCATION LAW		


ELECTRICAL

SATTERLEE
BASEMENT
PLAN


E-100-10a



DATE: 10/10/2009 10:43:00 AM
DRAWN BY: P. H. LUM
DESIGNED BY: T. C. KILKENNY
CHECKED BY: J. L. ROBBINS, P.E.

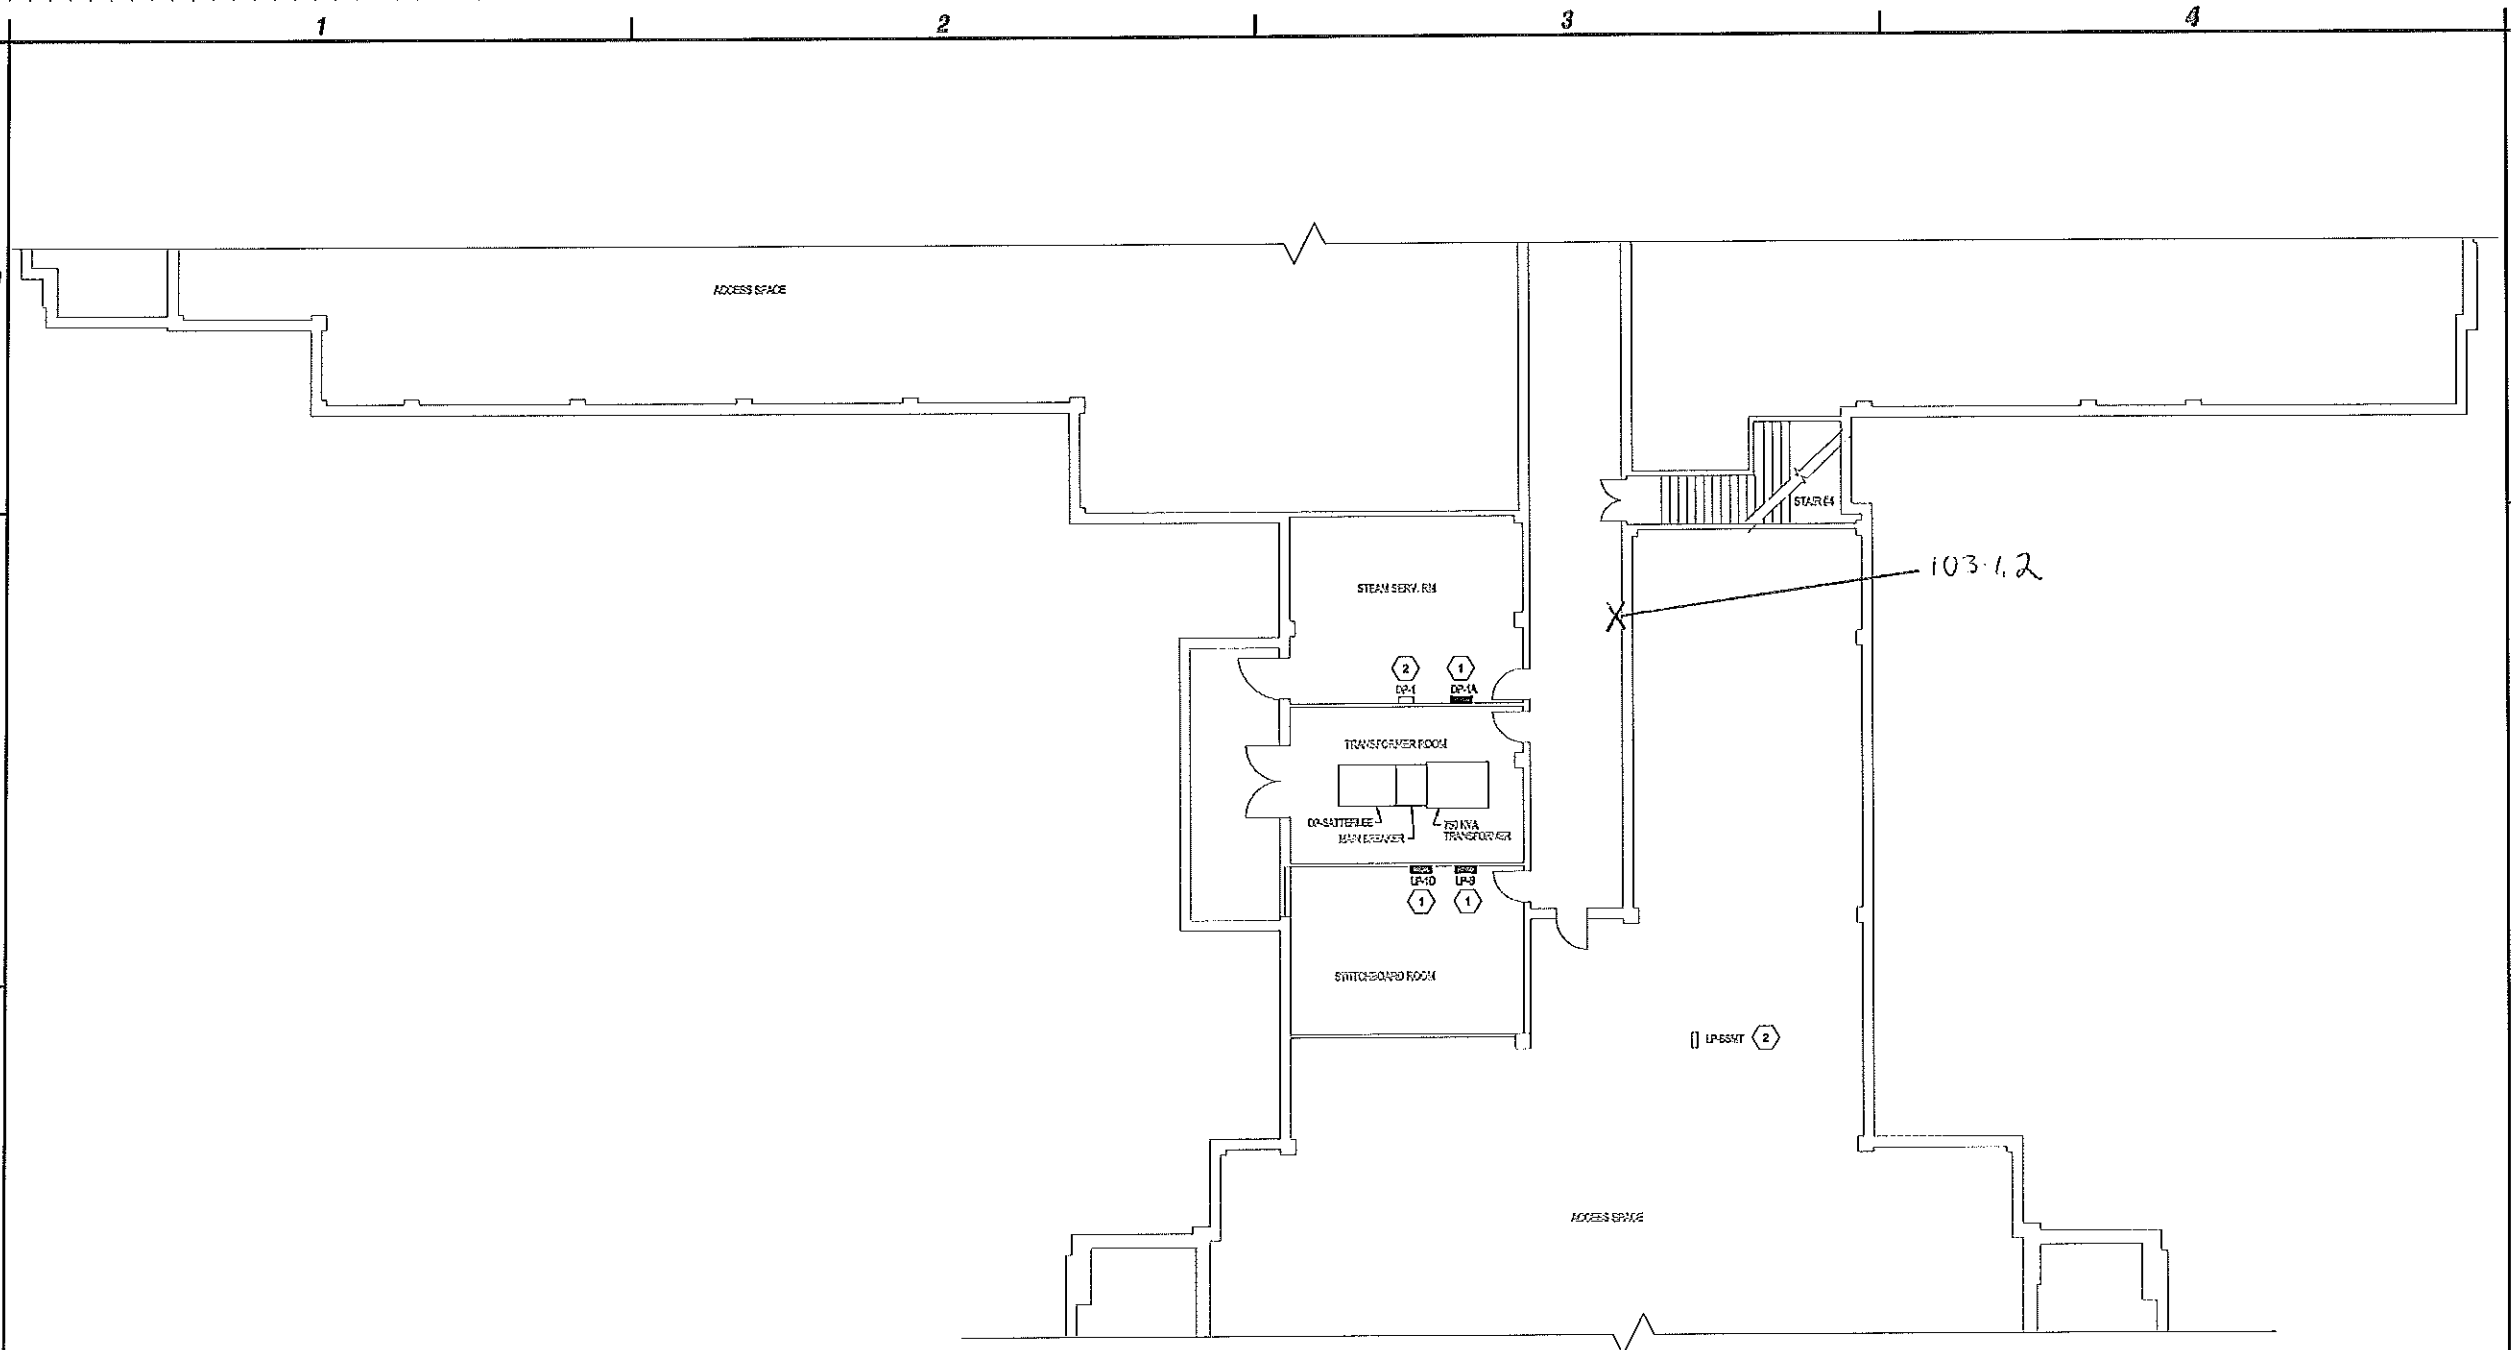


- DRAWING SPECIFICATIONS
- 1 REMOVE EXISTING PANELBOARDS IN THIS LOCATION AND REPLACE WITH NEW PANEL BOARDS AS SHOWN.
 - 2 REMAINS.

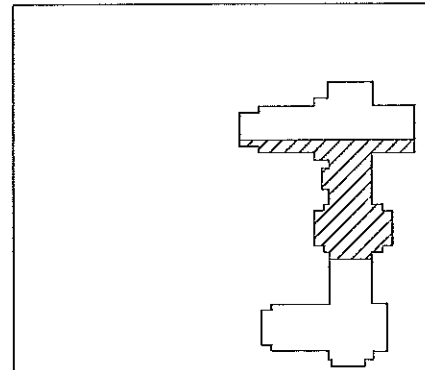


A1 SATTERLEE - PARTIAL BASEMENT PLAN
SCALE: 1/4" = 1'-0"

A4 KEY PLAN
SCALE: NOT TO SCALE

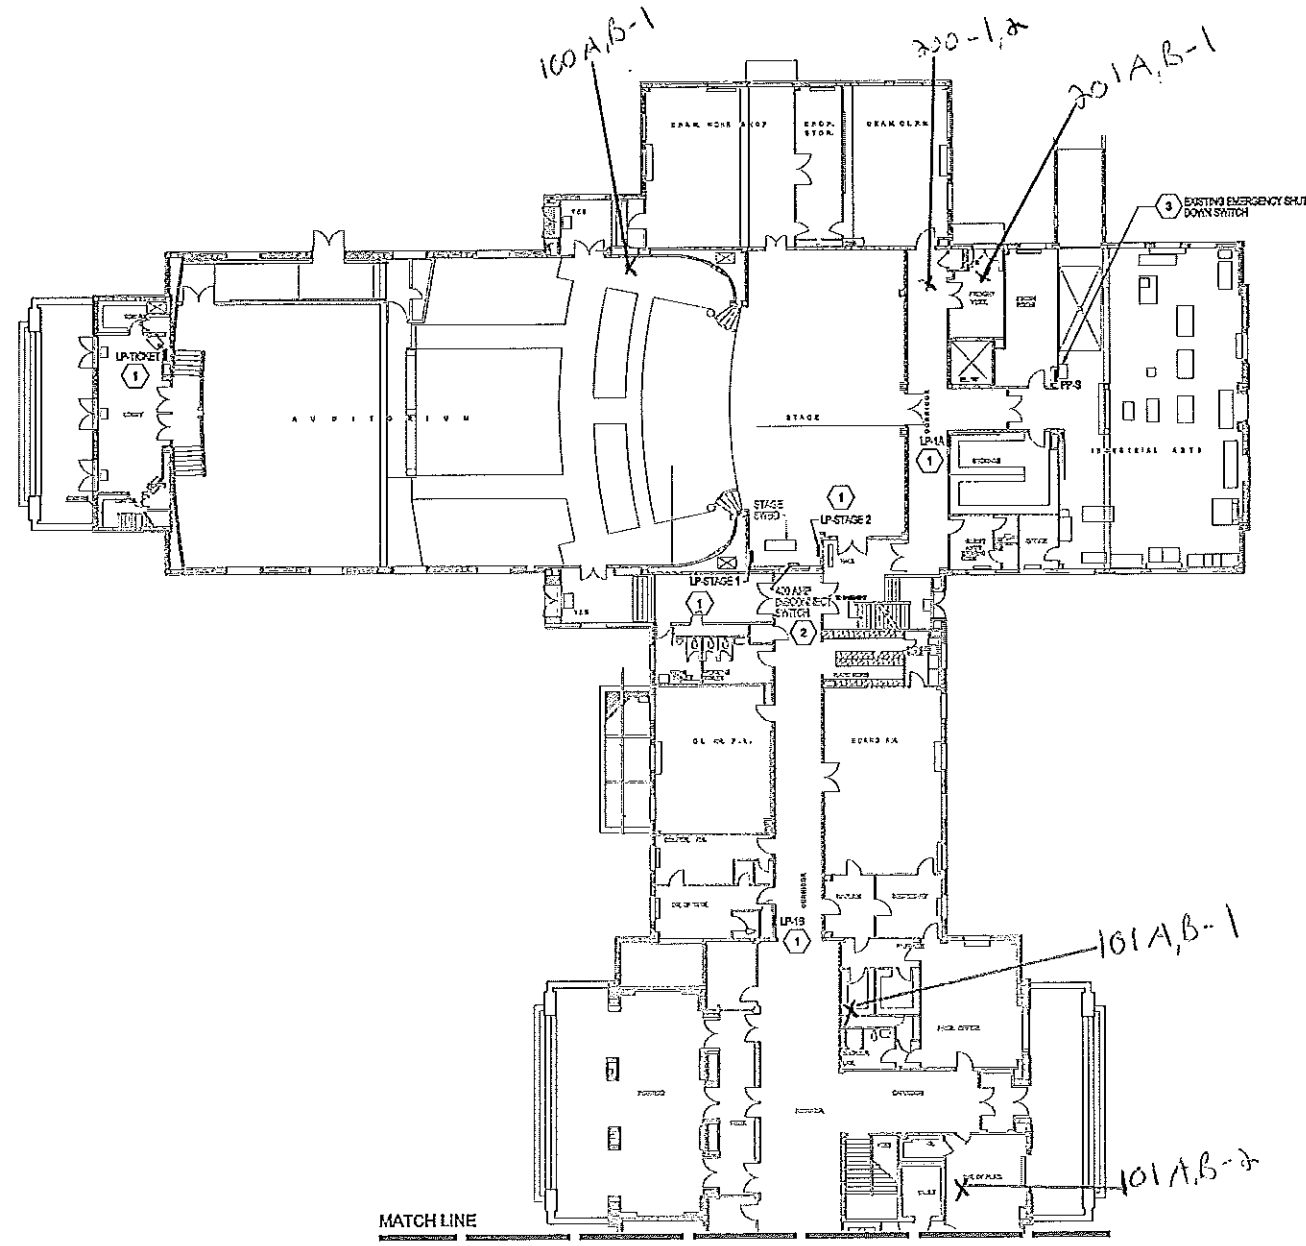

MATCH LINE
SEE DWG. RIGHT SIDE

- DRAWING SPECIFIC NOTES:**
- 1 REMOVE EXISTING PANELBOARD IN THIS LOCATION AND REPLACE WITH NEW PANELBOARD AS SHOWN.
 - 2 REMAIN.
 - 3 RELOCATE EXISTING EMERGENCY SHUT DOWN SWITCH TO SHUNT TRIP MAIN BREAKER IN PAB

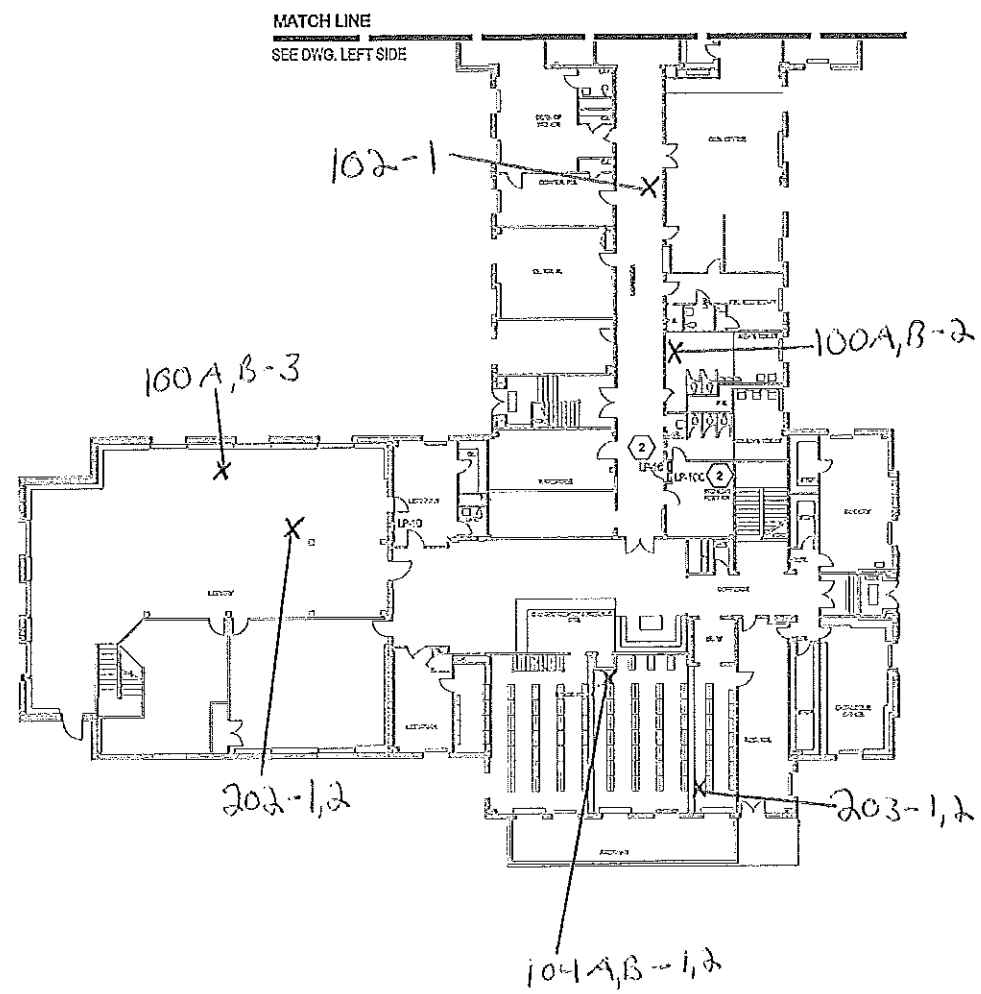

MATCH LINE
SEE DWG. LEFT SIDE



A1 SATTERLEE - FIRST FLOOR PLAN
SCALE: 1/8" = 1'-0"

C&S COMPANIES

C&S Engineers, Inc.
499 Col. Elsen Collins Blvd.
Syosset, New York 11791
Phone: 315-455-2000
Fax: 315-455-9687
www.cscos.com

STATE UNIVERSITY CONSTRUCTION FUND
NEW YORK



STATE UNIVERSITY CONSTRUCTION FUND
SUCF PROJECT NO. 12290
STATE UNIVERSITY OF NEW YORK AT POTSDAM
PRE-BID SUBMISSION - NOT FOR CONSTRUCTION
UPGRADE ELECTRICAL DISTRIBUTION SYSTEMS
VARIOUS BUILDINGS

MARK	DATE	DESCRIPTION
REVISIONS		
PROJECT NO:	192453-001	
DATE:	DECEMBER 5, 2008	
SCALE:	AS SHOWN	
DRAWN BY:	P.N.D.U.	
DESIGNED BY:	T.A.KUMAR	
CHECKED BY:	J.L. ROBBINS, P.E.	
NO ALTERATION PERMITTED HEREON EXCEPT AS PROVIDED UNDER SECTION 2209 SUBDIVISION 2 OF THE NEW YORK EDUCATION LAW		

ELECTRICAL

SATTERLEE
FIRST FLOOR
PLANS

E-100-10b

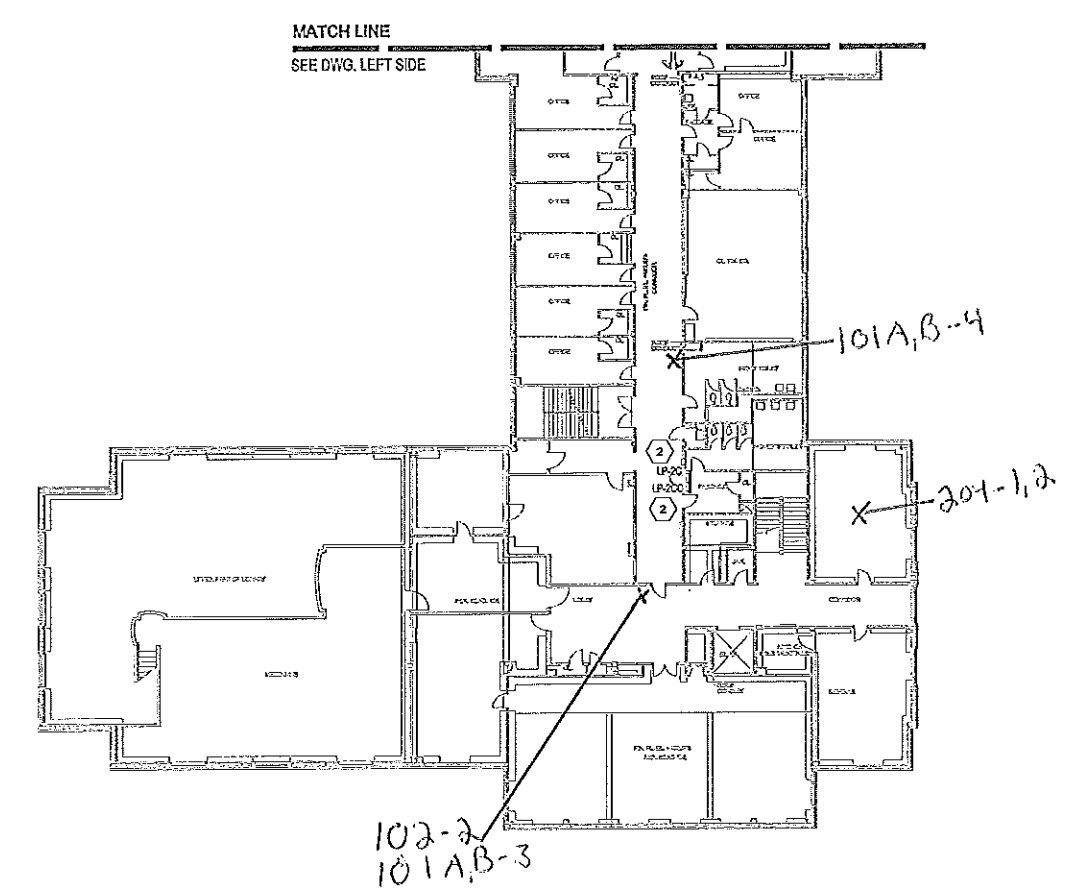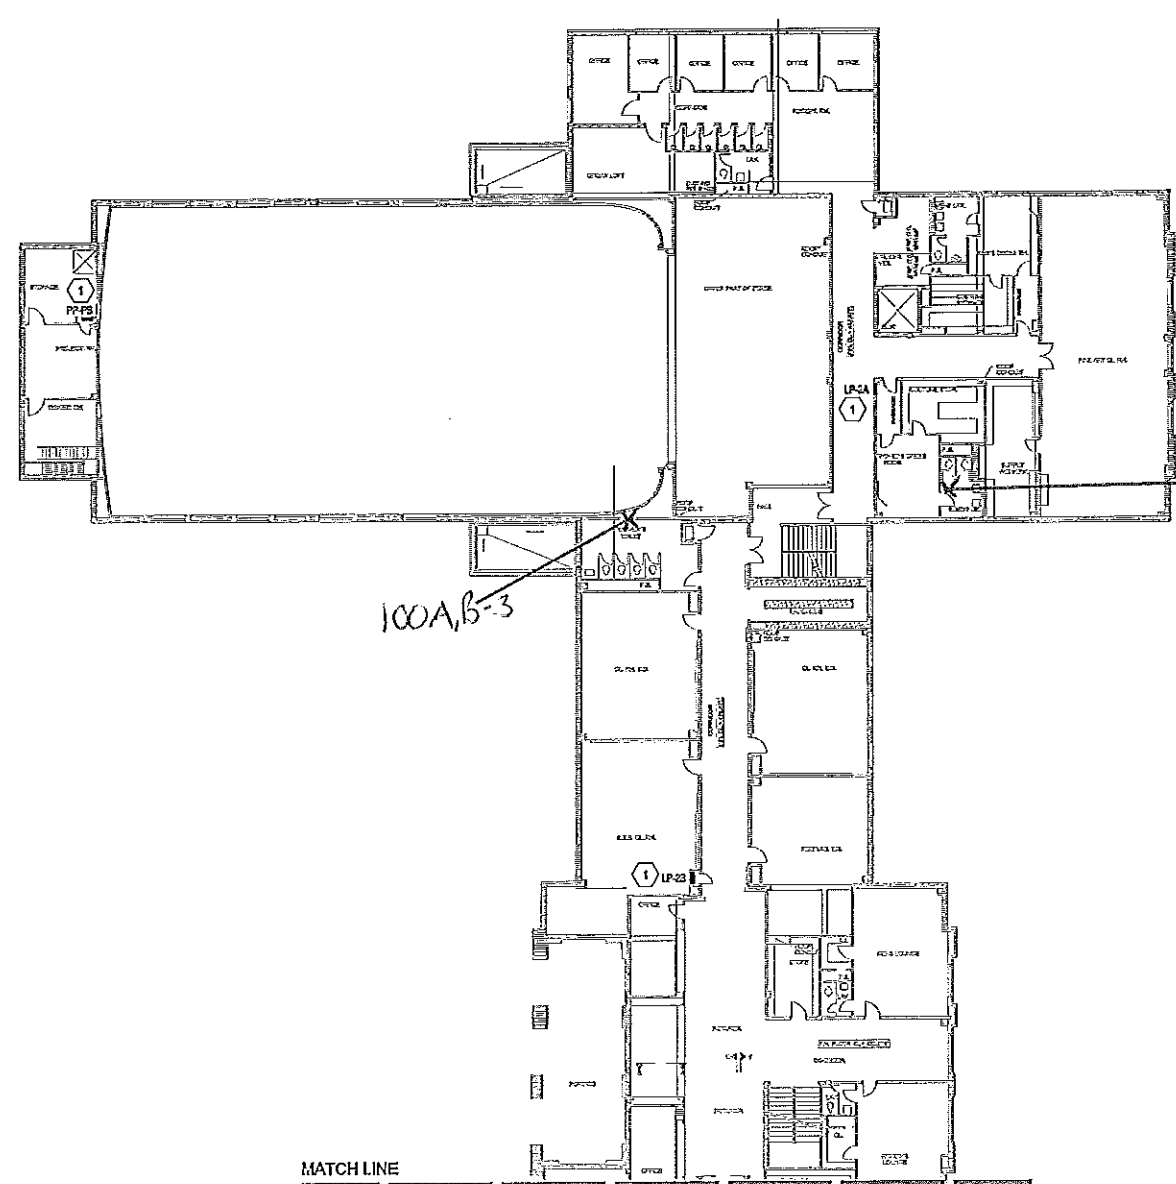

MATCH LINE
SEE DWG. RIGHT SIDE

MATCH LINE
SEE DWG. LEFT SIDE

- DRIVING SPECIFIC NOTES:
- (1) REMOVE EXISTING PANELS IN THIS LOCATION AND REPLACE WITH NEW PANELS SHOWN AS SHOWN (NOT USED)
 - (2) REMAINS



0 5 10

A1 SATTERLEE - SECOND FLOOR PLAN
SCALE: 1/8" = 1'-0"



C&S Engineers, Inc.
499 Col. Eileen Collins Blvd.
Syracuse, New York 13212
Phone: 315-455-2000
Fax: 315-455-6667
www.csc008.com





STATE UNIVERSITY CONSTRUCTION FUND
NEW YORK

STATE UNIVERSITY CONSTRUCTION FUND
SUCF PROJECT NO. 12290
STATE UNIVERSITY OF NEW YORK AT POTSDAM
PRE-BID SUBMISSION - NOT FOR CONSTRUCTION
UPGRADE ELECTRICAL DISTRIBUTION SYSTEMS
VARIOUS BUILDINGS

MARK	DATE	DESCRIPTION
REVISIONS		
PROJECT NO:	190-453-001	
DATE:	DECEMBER 5, 2003	
SCALE:	AS SHOWN	
DRAWN BY:	P.N.U.U.	
DESIGNED BY:	T.O. KURKOWICZ	
CHECKED BY:	J.L. ROSSINI, P.E.	
NO ALTERATION PERMITTED HEREON EXCEPT AS PROVIDED UNDER SECTION 2203 SUBDIVISION 2 OF THE NEW YORK EDUCATION LAW		

ELECTRICAL
SATTERLEE
SECOND FLOOR
PLANS

E-100-10c

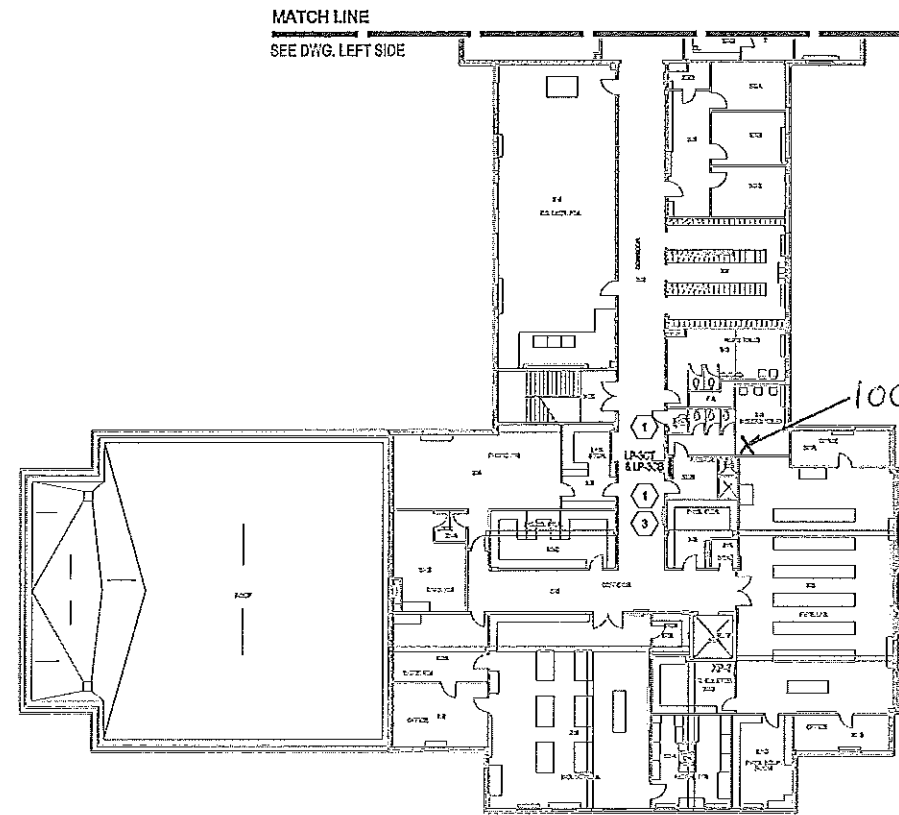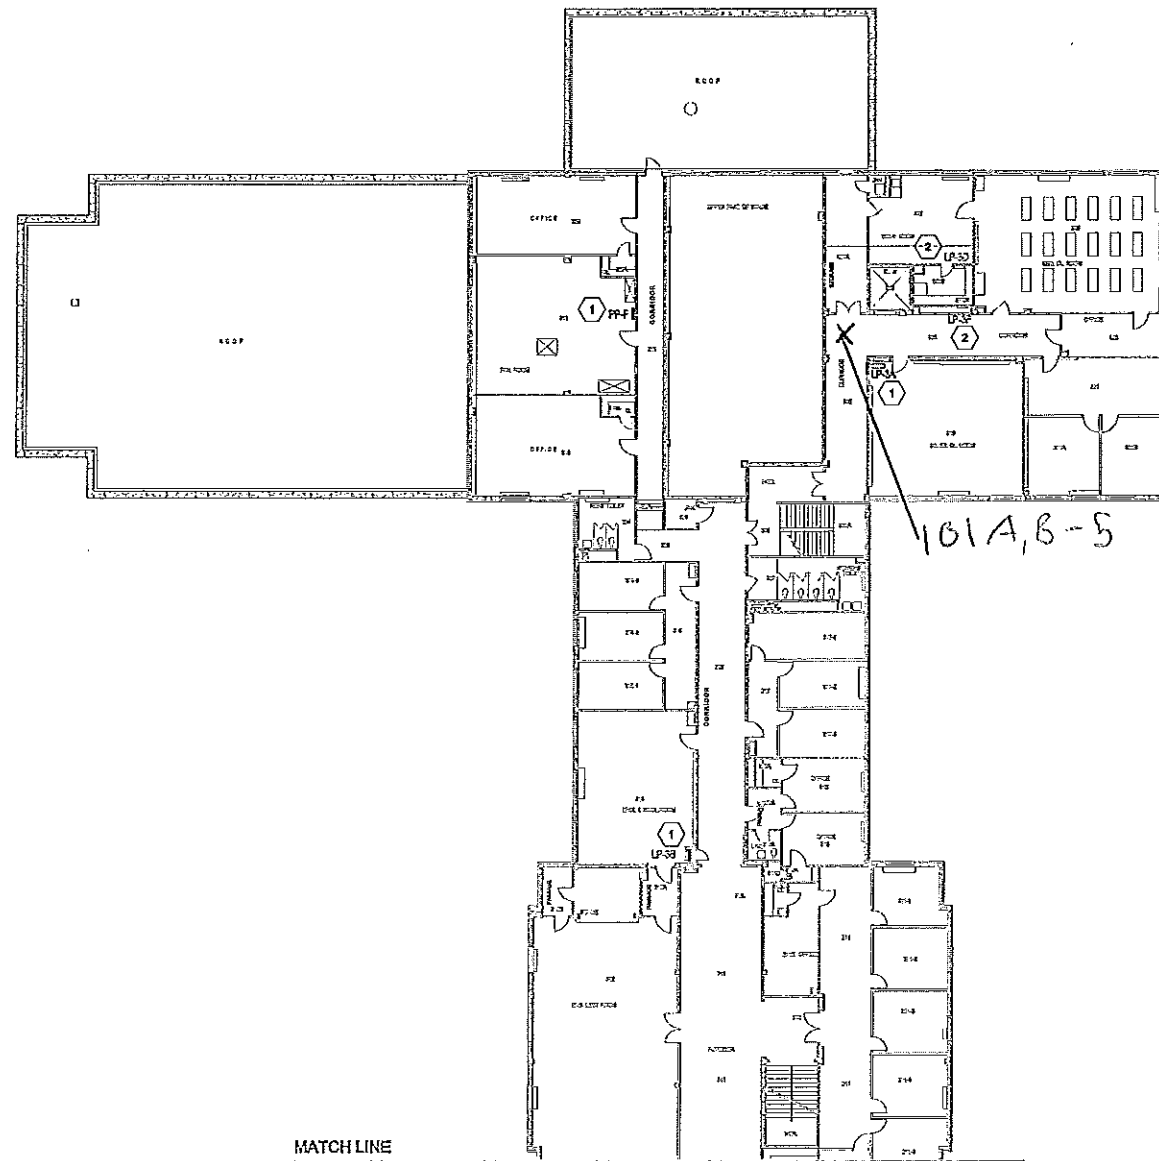

MATCH LINE
SEE DWG. RIGHT SIDE

MATCH LINE
SEE DWG. LEFT SIDE

- DRAWING SPECIFIC NOTES:
- 1 REMOVE EXISTING PANEL BOARD IN THIS LOCATION AND REPLACE WITH NEW PANEL BOARD AS SHOWN (NOT USED).
 - 2 REMAINS.
 - 3 LP 300 IS NOT BEING REPLACED, REMOVED ONLY.


A1 SATTERLEE - THIRD FLOOR PLAN
SCALE: 1/8" = 1'-0"





C&S Companies

C&S Engineers, Inc.
499 Col. Eileen Collins Blvd.
Syracuse, New York 13212
Phone: 315-455-2000
Fax: 315-455-9887
WWW.CSC08.COM

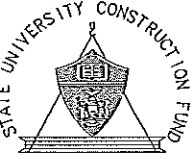

STATE UNIVERSITY CONSTRUCTION FUND
NEW YORK

STATE UNIVERSITY CONSTRUCTION FUND
SUCF PROJECT NO. 12290
STATE UNIVERSITY OF NEW YORK AT POTSDAM

PRE-BID SUBMISSION - NOT FOR CONSTRUCTION

UPGRADE ELECTRICAL DISTRIBUTION SYSTEMS

VARIOUS BUILDINGS

MARK	DATE	DESCRIPTION
REVISIONS		
		PROJECT NO: 192433.001
		DATE: DECEMBER 5, 2003
		SCALE: AS SHOWN
		DRAWN BY: P.R.U.U.
		DESIGNED BY: T.G. NIJMEYER
		CHECKED BY: J.L. ROSS, P.E.
NO ALTERATION PERMITTED HEREON EXCEPT AS PROVIDED UNDER SECTION 7-203 SUBDIVISION 2 OF THE NEW YORK EDUCATION LAW		

ELECTRICAL

SATTERLEE

THIRD FLOOR


PLANS

E-100-10d



C&S Engineers, Inc.
499 Col. Eileen Collins Blvd.
Syracuse, New York 13212
Phone: 315-455-2000
Fax: 315-455-9587
www.csoos.com

INSET C&S
PE SEAL HERE

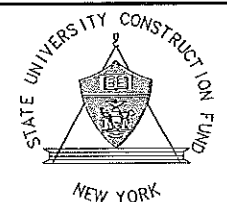


STATE UNIVERSITY CONSTRUCTION FUND
SUCF PROJECT NO. 12290
STATE UNIVERSITY OF NEW YORK AT POTSDAM
PRE-BID SUBMISSION - NOT FOR CONSTRUCTION
UPGRADE ELECTRICAL DISTRIBUTION SYSTEMS
VARIOUS BUILDINGS

MARK	DATE	DESCRIPTION
REVISIONS		
PROJECT NO.	190453.001	
DATE	DECEMBER 5, 2008	
SCALE	AS SHOWN	
DRAWN BY	P. H. LUN	
DESIGNED BY	T. G. MIKIEWICZ	
CHECKED BY	J. L. ROBBINS, P.E.	
NO ALTERATION PERMITTED HEREON EXCEPT AS PROVIDED UNDER SECTION 7209 SUBDIVISION 2 OF THE NEW YORK EDUCATION LAW		

ELECTRICAL

DUNN
BASEMENT & 1ST
FLOOR PLANS


E-100-11a

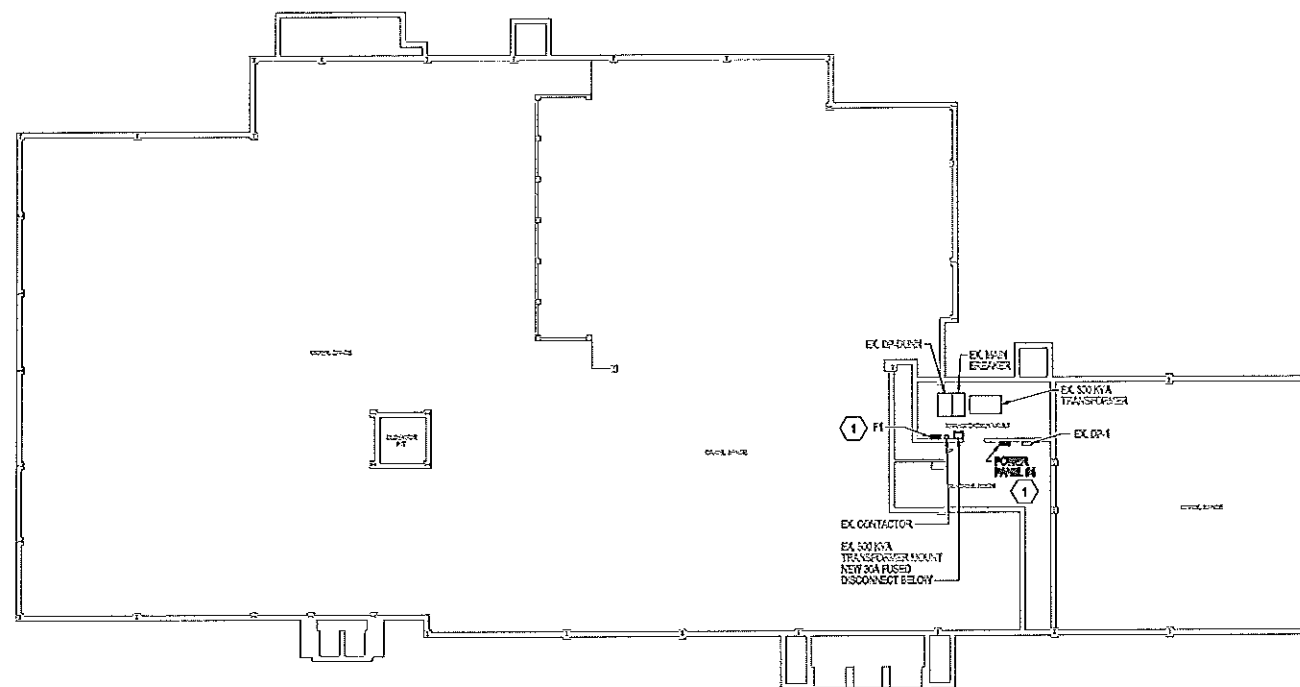

1 REMOVE EXISTING PANEL BOARD IN THIS LOCATION AND
REPLACE WITH NEW PANEL BOARD AS SHOWN.



C1 DUNN - BASEMENT PLAN
SCALE: 1/8" = 1'-0"

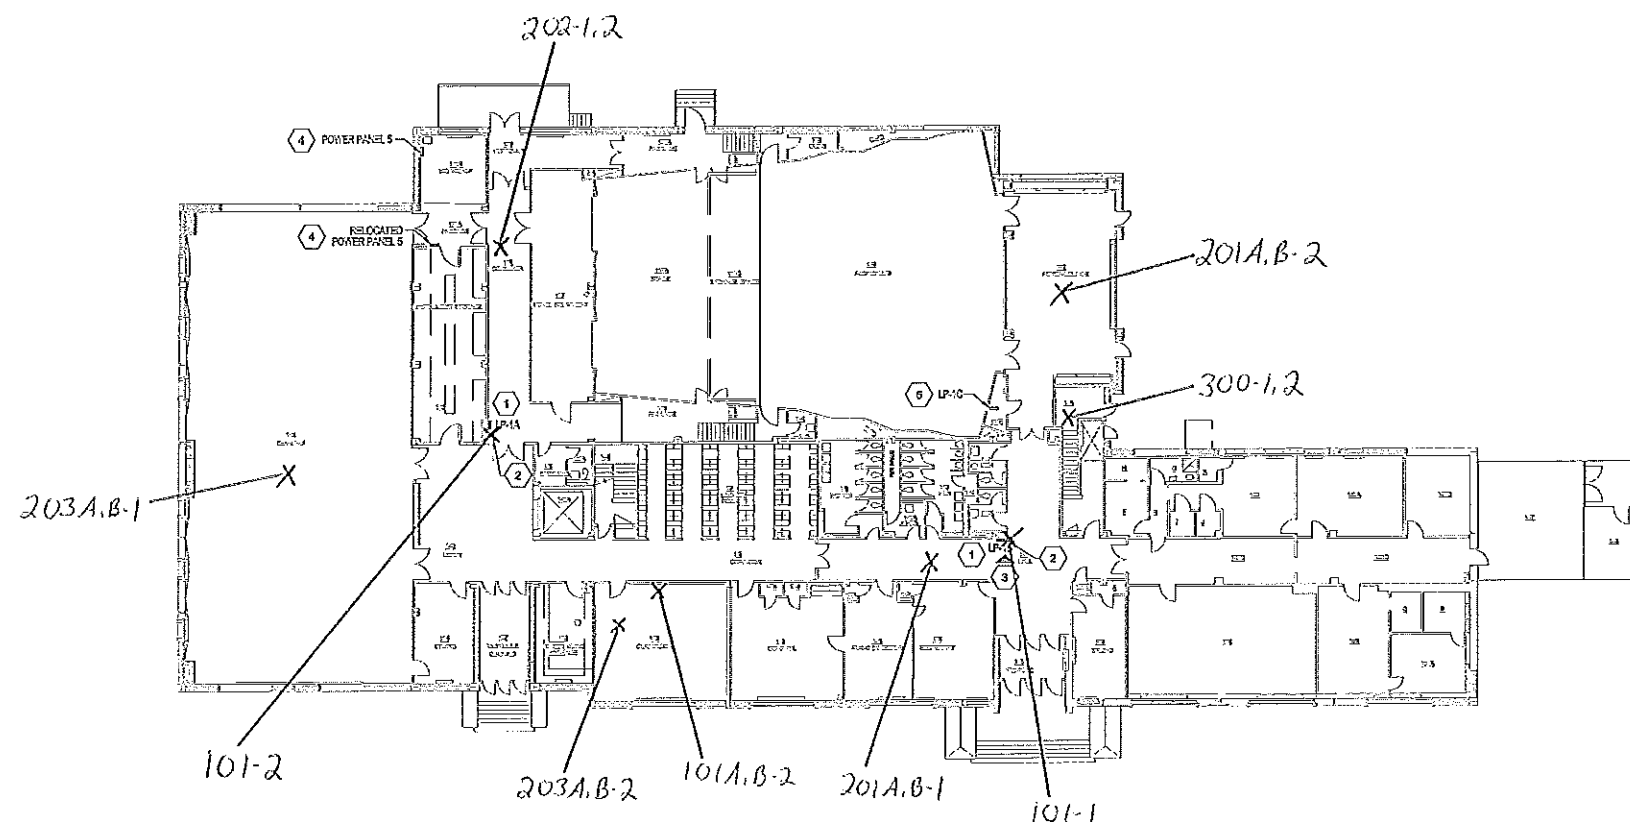

- 1 REMOVE EXISTING PANEL BOARD IN THIS LOCATION AND
REPLACE WITH NEW PANEL BOARD AS SHOWN.
- 2 SEE DETAIL AS SHOWN FOR ARCHITECTURAL WORK.
- 3 SEE PHOTO DUNN-1.
- 4 REMOVE EXISTING POWER PANEL 5, RELOCATE NEW PANEL
AS SHOWN, REMOVE INNER BUS AND BREAKERS AND REUSE
EXISTING PANEL BOX AS A 1/2" EXTEND MAIN POWER FEED
AND CIRCUIT AS SHOWN AND REQUIRED.
- 5 REMAINS.



A1 DUNN - FIRST FLOOR PLAN
SCALE: 1/8" = 1'-0"



C1	DUNN - SECOND FLOOR PLAN
	SCALE: 1/8" = 1'-0"



A1	DUNN - THIRD FLOOR PLAN SCALE: 1/8" = 1'-0"
----	--



C&S Engineers, Inc.
499 Col. Eileen Collins Blvd.
Syracuse, New York 13212
Phone: 315-455-2000
Fax: 315-455-9887
www.ccsos.com

~~INSERT CAS
FE SEAL HERE~~




STATE UNIVERSITY CONSTRUCTION FUND
SUCH PROJECT NO. 12290
STATE UNIVERSITY OF NEW YORK AT POTSDAM
PRE-BID SUBMISSION - NOT FOR CONSTRUCTION
UPGRADE ELECTRICAL DISTRIBUTION SYSTEMS
VARIOUS BUILDINGS

MASK	DATE	DESCRIPTION
REVISIONS		
PROJECT NO:	190-453-001	
DATE:	DECEMBER 5, 2003	
SCALE:	AS SHOWN	
DRAWN BY:	P.R.UWJ	
DESIGNED BY:	T.Q.KLUKIEWCZ	
CHECKED BY:	J.L.ROBBINS, P.E.	
NO ALTERATION PERMITTED HEREON EXCEPT AS PROVIDED UNDER SECTION 7209 SUBDIVISION 2 OF THE NEW YORK EDUCATION LAW		

ELECTRICAL

**DUNN
2ND & 3RD
FLOOR PLANS**


E-100-11b

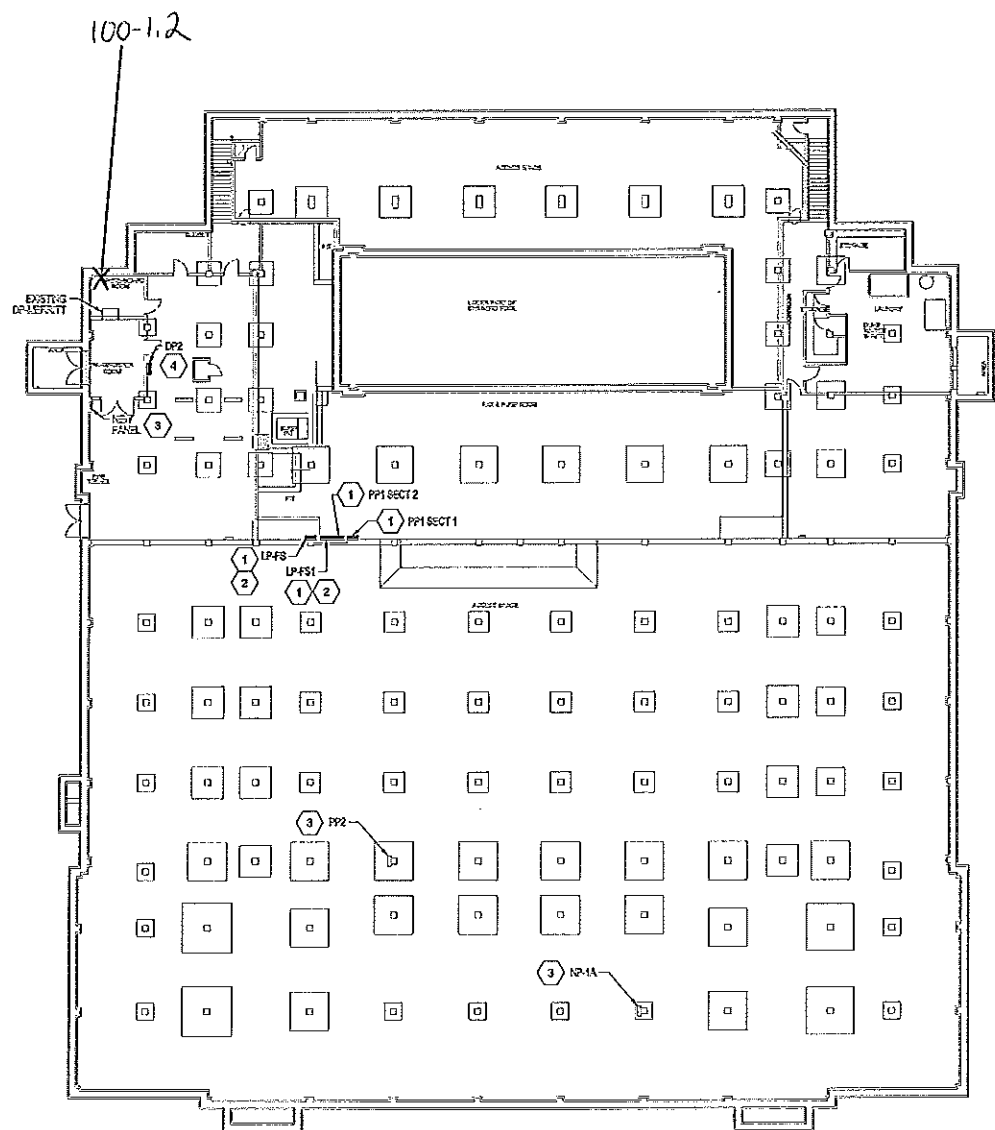

- DRAWING SPECIFIC NOTES:**
- 1 REMOVE EXISTING PANEL BOARD IN THIS LOCATION AND REPLACE WITH NEW PANEL BOARD AS SHOWN
 - 2 REMOVE ALL DAMAGED FEEDER CONDUIT WITH UPS BENEATH PANEL UP-1A AND UP-1B
 - 3 REMAINS
 - 4 NEW DISTRIBUTION PANEL DP-2



A1 MERRITT - BASEMENT PLAN
SCALE: 1/8" = 1'-0"

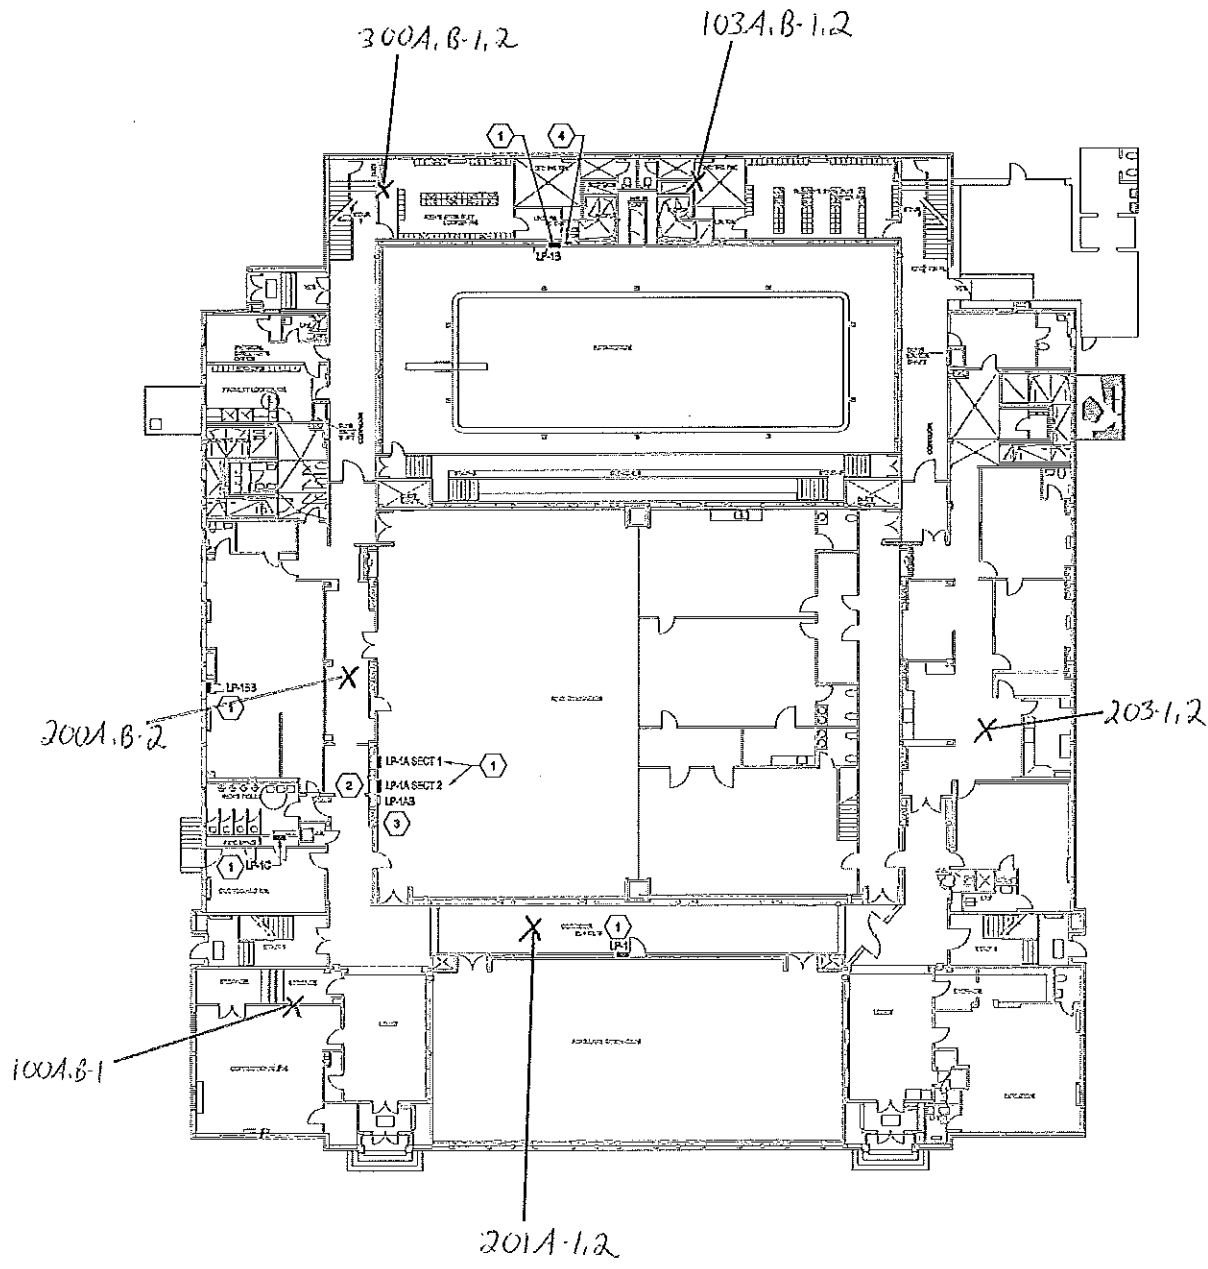

- DRAWING SPECIFIC NOTES:**
- 1 REMOVE EXISTING PANEL BOARD IN THIS LOCATION AND REPLACE WITH NEW PANEL BOARD AS SHOWN
 - 2 REMOVE EXISTING PANEL BOARDS AND RELOCATE CIRCUITS TO NEW UP-1A SECTION 1 AND SECTION 2 PANELS AS SCHEDULED
 - 3 REMOVE EXISTING PANEL BOARD IN THIS LOCATION AND REPLACE CIRCUITS TO UP-1A SECTION 1 & 2 PANELS AS SHOWN
 - 4 EXISTING LIGHTING CONTROL SWITCH TO BE REMOVED TO NEW CONTROLLER AS NOTED ON UP-1B SCHEDULE ON DRAWINGS E-101-12



A3 MERRITT - FIRST FLOOR PLAN
SCALE: 1/8" = 1'-0"



C&S ENGINEERS, INC.
499 Col. Elgin Collins Blvd.
Syracuse, New York 13212
Phone: 315-455-2000
Fax: 315-455-9667
www.cscos.com



STATE UNIVERSITY CONSTRUCTION FUND
NEW YORK

STATE UNIVERSITY CONSTRUCTION FUND
SUCK PROJECT NO. 12290
STATE UNIVERSITY OF NEW YORK AT POTSDAM
PRE-BID SUBMISSION - NOT FOR CONSTRUCTION
UPGRADE ELECTRICAL DISTRIBUTION SYSTEMS
VARIOUS BUILDINGS

MARK	DATE	DESCRIPTION

PROJECT NO: 191453.001
DATE: DECEMBER 5, 2003
SCALE: AS SHOWN
DRAWN BY: P.N.UJ
DESIGNED BY: T.G. KUREWICZ
CHECKED BY: J.L. ROSSINI, P.E.
NO ALTERATION PERMITTED HEREON EXCEPT AS PROVIDED UNDER SECTION 7203 SUBDIVISION 2 OF THE NEW YORK EDUCATION LAW

ELECTRICAL


**MERRITT
BASEMENT & 1ST
FLOOR PLANS**

E-100-12a



C&S Engineers, Inc.
499 Col. Eliseo Collina Blvd.
Syracuse, New York 13212
Phone: 315-455-2000
Fax: 315-455-9997
www.cscs.com

INSUL. GAS
FE. SEAL. NOTE

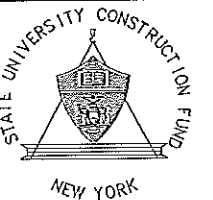


STATE UNIVERSITY CONSTRUCTION FUND
SUCF PROJECT NO. 12290
STATE UNIVERSITY OF NEW YORK AT POTSDAM
PRE-BID SUBMISSION - NOT FOR CONSTRUCTION
UPGRADE ELECTRICAL DISTRIBUTION SYSTEMS
VARIOUS BUILDINGS

MARK	DATE	DESCRIPTION			
REVISIONS					
PROJECT NO:		100.453.001			
DATE:		DECEMBER 5, 2008			
SCALE:		AS SHOWN			
DRAWN BY:		P.ILUW			
DESIGNED BY:		T.G. KUKIEWICZ			
CHECKED BY:		J.L. ROBERTS, P.E.			
NO ALTERATION PERMITTED HEREON EXCEPT AS PROVIDED UNDER SECTION 7209 SUBDIVISION 2 OF THE NEW YORK EDUCATION LAW					

ELECTRICAL

HEATING PLANT
FIRST & SECOND
FLOOR PLANS

E-101-13

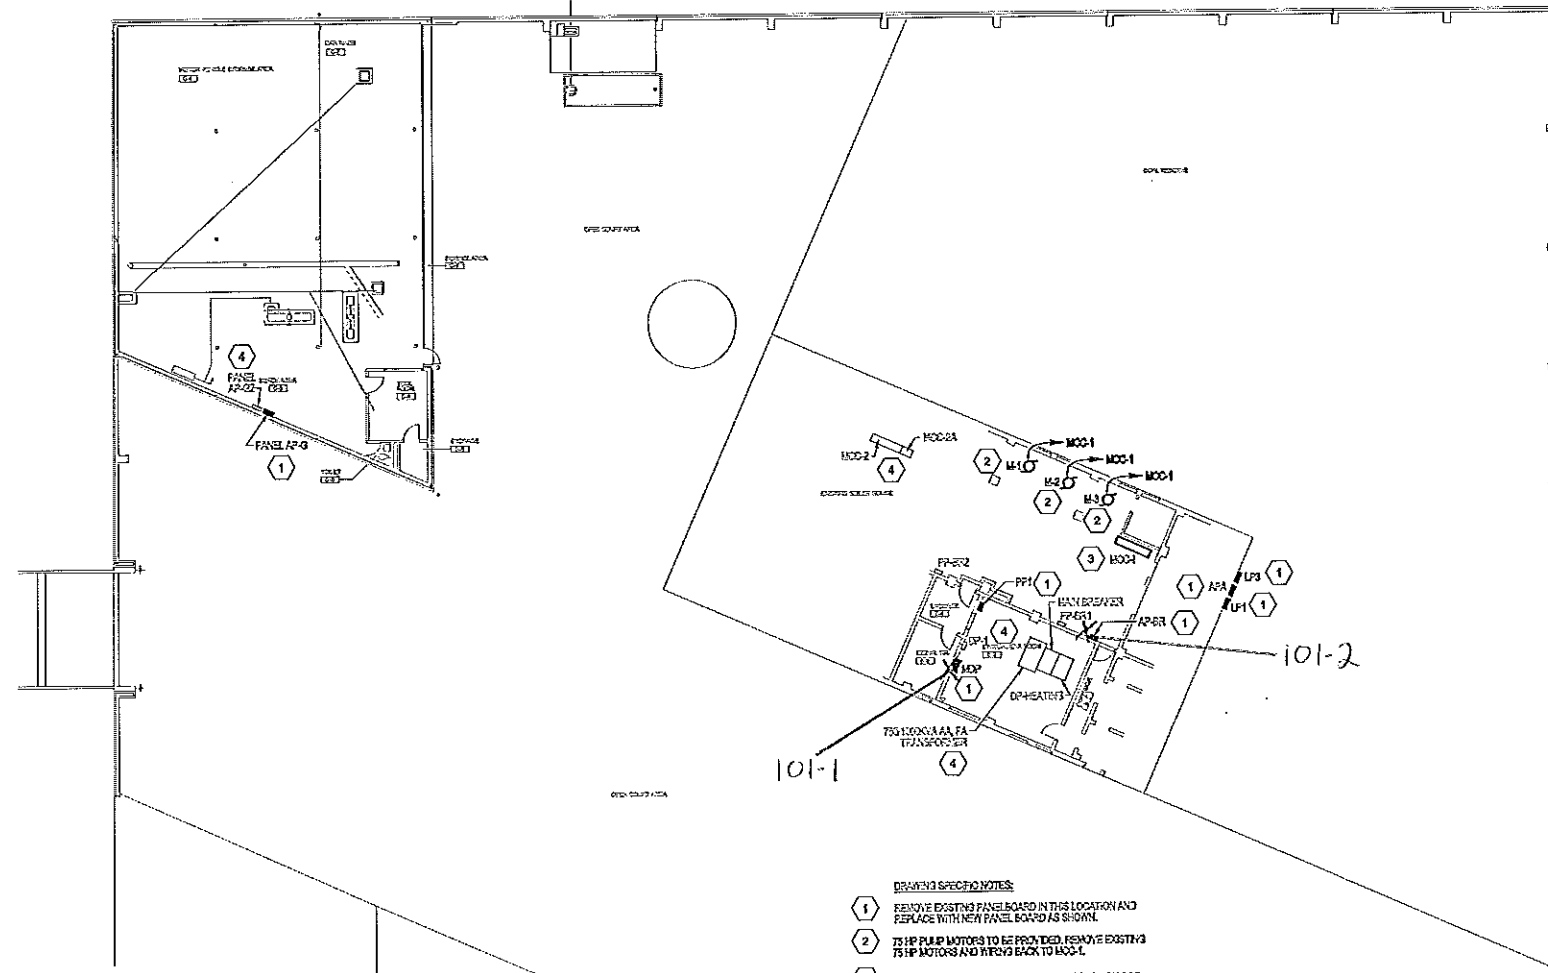

- DRAWING SPECIFIC NOTES:
- 1 REMOVE EXISTING PANELBOARDS IN THIS LOCATION AND REPLACE WITH NEW PANEL BOARD AS SHOWN.
 - 2 75 HP PUMP MOTORS TO BE PROVIDED. REMOVE EXISTING 75 HP MOTORS AND REWIND BACK TO 480V.
 - 3 REMOVE EXISTING MOD IN THIS LOCATION AND REPLACE WITH NEW MOD AS SHOWN.
 - 4 REMAINS.




0 5 10 15



0 5 10 15

B1 HEATING PLANT - FIRST FLOOR PLAN
SCALE: 1/8" = 1'-0"

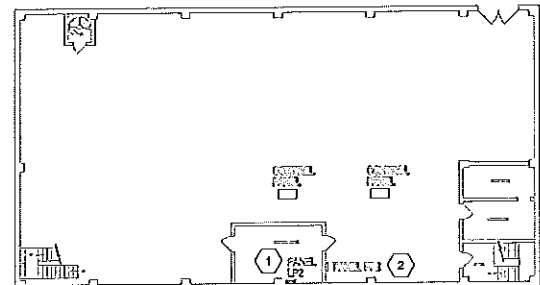


- DRAWING SPECIFIC NOTES:
- 1 REMOVE EXISTING PANELBOARDS IN THIS LOCATION AND REPLACE WITH NEW PANEL BOARD AS SHOWN.
 - 2 REMAINS.

A1 HEATING PLANT - SECOND FLOOR PLAN (BOILER HOUSE)
SCALE: 1/8" = 1'-0"



C&S Engineers, Inc.
499 Col. Elton Collins Blvd.
Syracuse, New York 13212
Phone: 315-455-2000
Fax: 315-455-9987
www.cscos.com

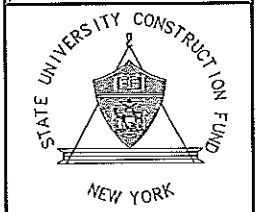


STATE UNIVERSITY CONSTRUCTION FUND
SUCF PROJECT NO. 12290
STATE UNIVERSITY OF NEW YORK AT POTSDAM
PRE-BID SUBMISSION - NOT FOR CONSTRUCTION
UPGRADE ELECTRICAL DISTRIBUTION SYSTEMS
VARIOUS BUILDINGS

MARK	DATE	DESCRIPTION
REVISIONS		
1	12/05/03	PROJECT NO. 12290.001
2	12/05/03	DATE: DECEMBER 5, 2003
3	12/05/03	SCALE: AS SHOWN
4	12/05/03	DRAWN BY: P.H. WU
5	12/05/03	DESIGNED BY: T.G. KUREWICZ
6	12/05/03	CHECKED BY: J.L. ROBBINS, P.E.
NO ALTERATION PERMITTED HEREON EXCEPT AS PROVIDED UNDER SECTION 7209 SUBDIVISION 2 OF THE NEW YORK EDUCATION LAW		


ELECTRICAL
MOREY
FIRST & SECOND
FLOOR PLANS

E-100-15A

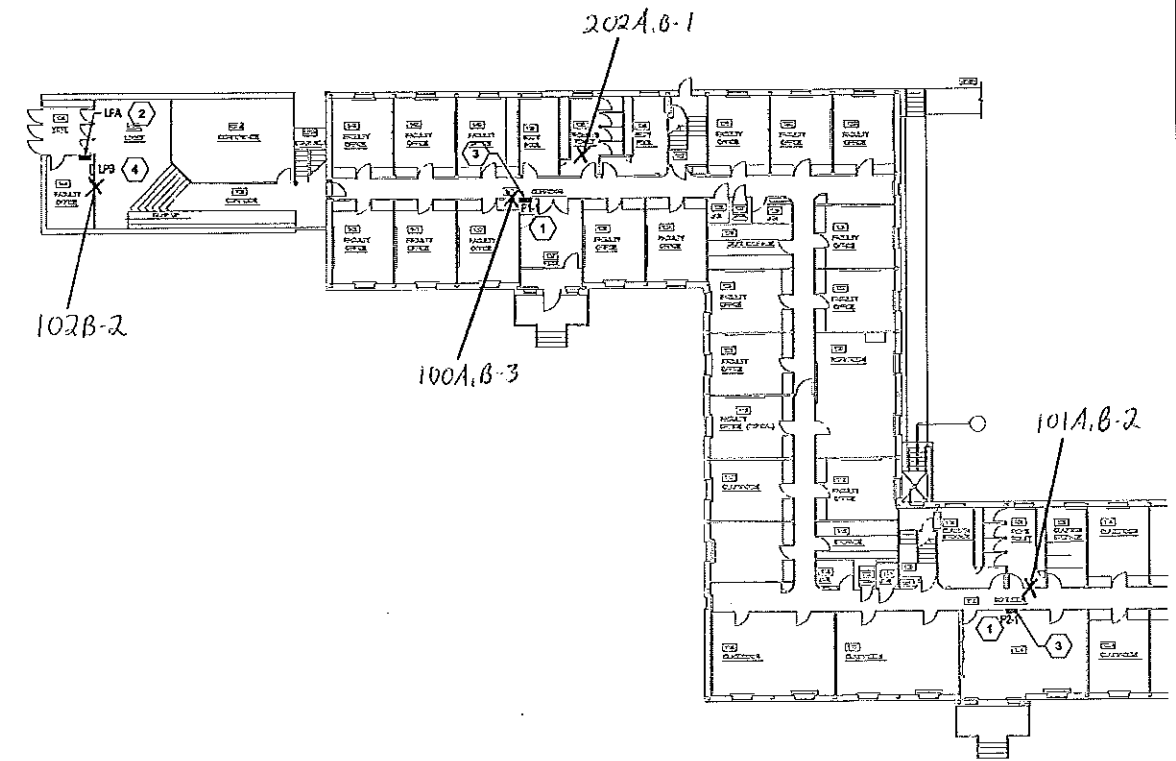

GENERAL NOTE:
1. SEE DRAWING E-601-150 FOR ONE LINE DIAGRAM.

- DRAWING SPECIFIC NOTES:
1. REMOVE EXISTING PANELBOARD IN THIS LOCATION AND REPLACE WITH NEW PANEL BOARD AS SHOWN.
 2. REMOVE PANELBOARD LPA AND LPA. RELOCATE BRANCH CIRCUITS FROM PANEL LPA INTO NEW PANEL LPA. DO NOT REPLACE LPA. REUSE EXISTING LPA POWER FEED CONDUITS AS SHOWN.
 3. SEE DETAIL A3-4-51 FOR ARCHITECTURAL WORK.
 4. REMAINS.


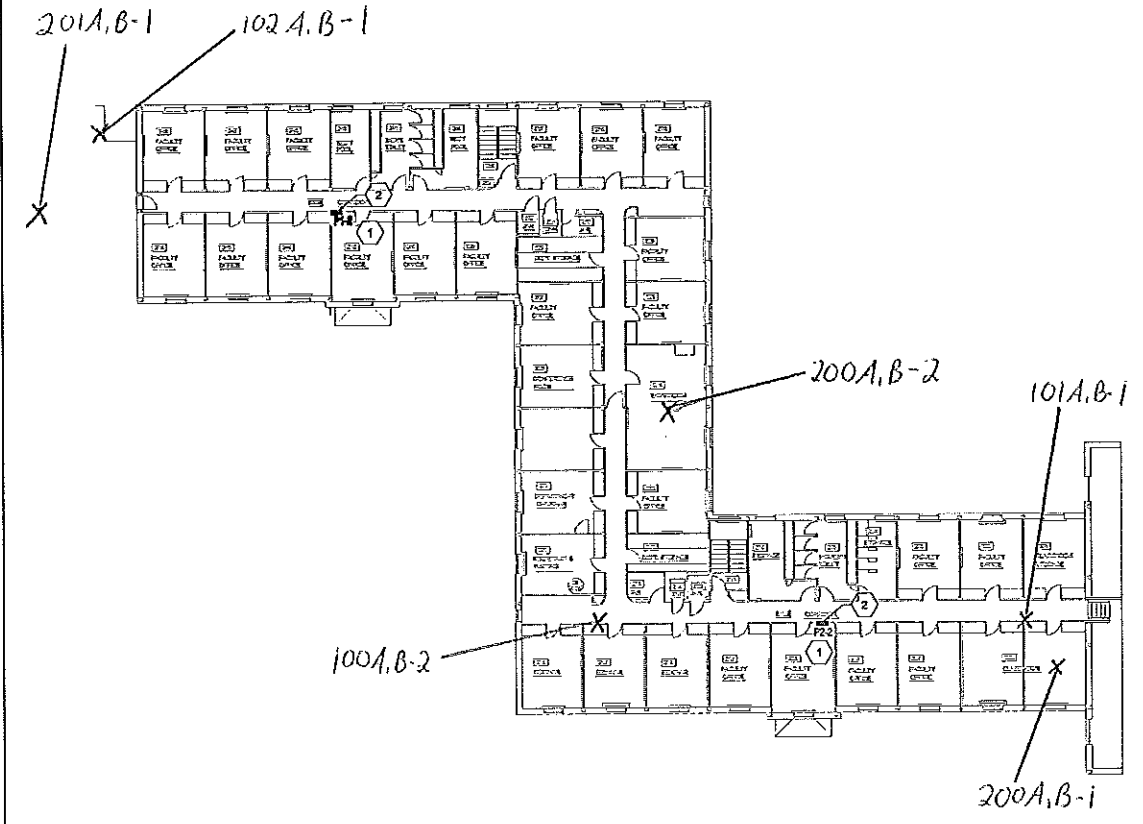


- DRAWING SPECIFIC NOTES:
1. REMOVE EXISTING PANELBOARD IN THIS LOCATION AND REPLACE WITH NEW PANEL BOARD AS SHOWN.
 2. SEE DETAIL A3-4-51 FOR ARCHITECTURAL WORK.

GENERAL NOTE:
1. SEE DRAWING E-601-150 FOR ONE LINE DIAGRAM.

A1 MOREY - FIRST FLOOR PLAN
SCALE: 1/8" = 1'-0"

A3 MOREY - SECOND FLOOR PLAN
SCALE: 1/8" = 1'-0"

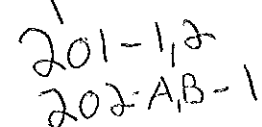
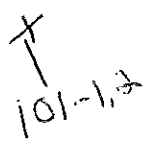


A horizontal scale bar with markings at 0, 2, 4, and 6 feet.



MARK	DATE	DESCRIPTION
PENSIONS		
PROJECT NO: 190453.001		
DATE: DECEMBER 5, 2008		
SCALE: AS SHOWN		
DRAWN BY: P.N.WUJ		
DESIGNED BY: T.G.KUKESWIZ		
CHECKED BY: J.L. ROSSIS, P.E.		

an 10, 2009 - 3:45p/e

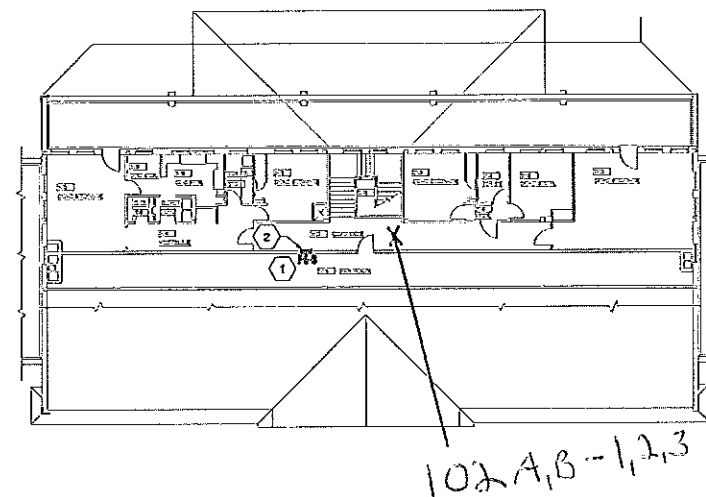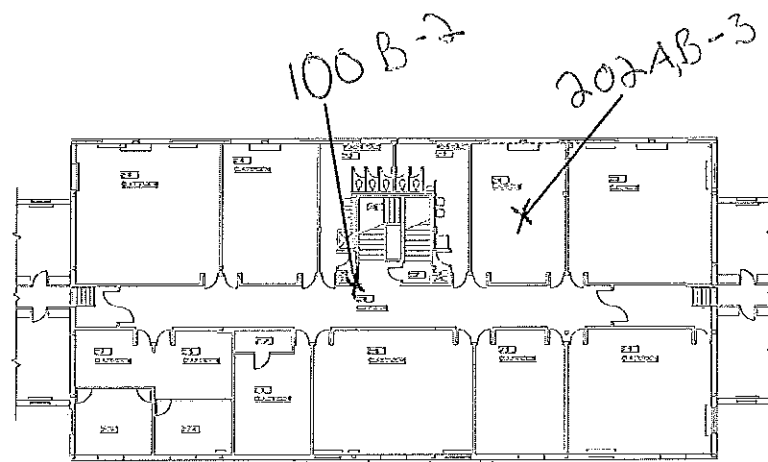



- DRAWING SPECIFIC NOTES**
- ① REMOVE EXISTING PANEL BOARD IN THIS LOCATION AND REPLACE WITH NEW PANEL BOARD AS SHOWN.
 - ② SEE DETAIL E2A-S1 FOR ARCHITECTURAL WORK.

A1 CARSON - SECOND FLOOR PLAN
SCALE: 1/8" = 1'-0"

A3 CARSON - THIRD FLOOR PLAN
SCALE: 1/8" = 1'-0"



C&S Engineers, Inc.
499 Col. Eileen Collins Blvd.
Syracuse, New York 13212
Phone: 315-455-2000
Fax: 315-455-6667
WWW.C&S.COM

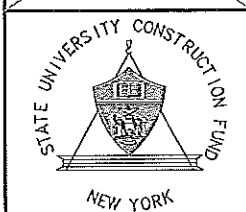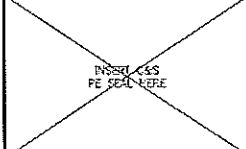


STATE UNIVERSITY CONSTRUCTION FUND
SUCF PROJECT NO. 12290
STATE UNIVERSITY OF NEW YORK AT POESDAM
PRE-BID SUBMISSION - NOT FOR CONSTRUCTION
UPGRADE ELECTRICAL DISTRIBUTION SYSTEMS
VARIOUS BUILDINGS

ELECTRICAL

CARSON
SECOND & THIRD
FLOOR PLANS

E-100-15Bb

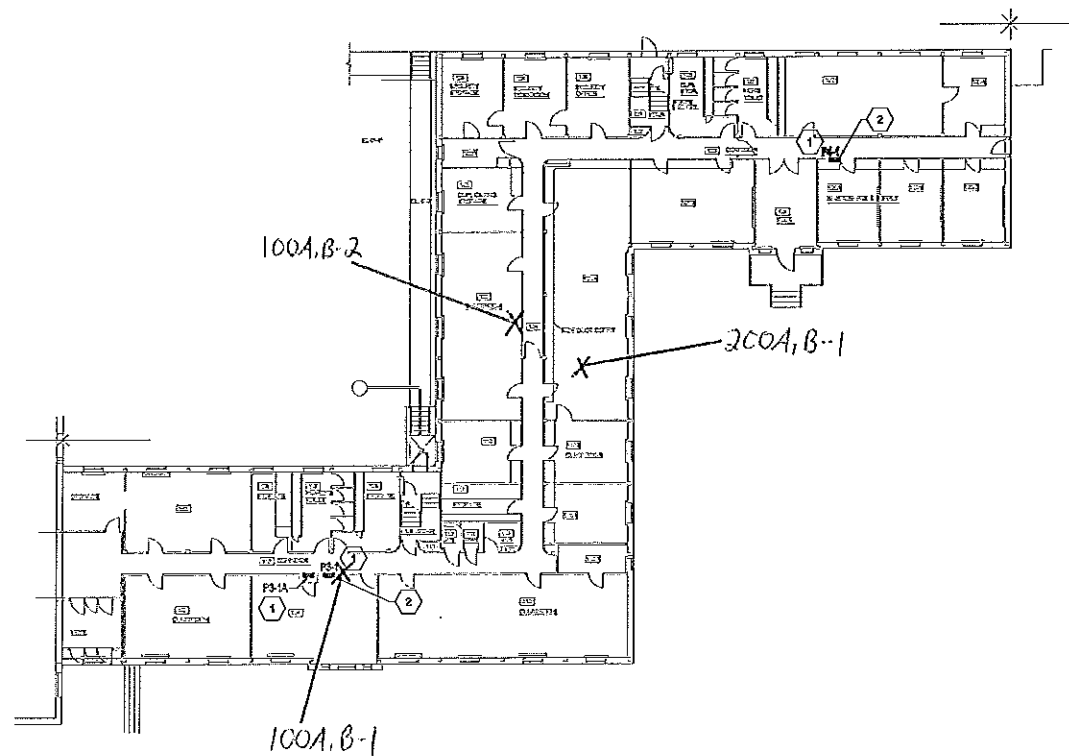


- DRAWING SPECIFIC NOTES:**
1. REMOVE EXISTING PANELBOARD IN THIS LOCATION AND REPLACE WITH NEW PANELBOARD AS SHOWN.
 2. SEE DETAIL A3-1 FOR ARCHITECTURAL WORK.

GENERAL NOTE:
1. SEE DRAWING E-100-153 FOR ONE LINE DIAGRAMS.



A1 MACVICAR - FIRST FLOOR PLAN
SCALE: 1/8" = 1'-0"

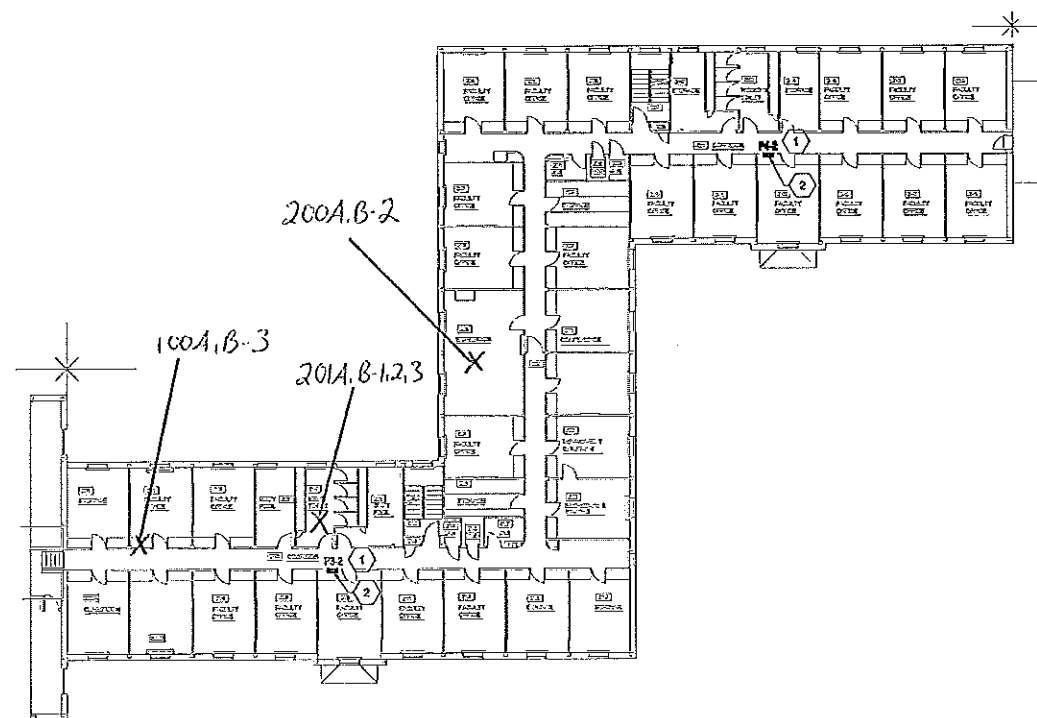

- DRAWING SPECIFIC NOTES:**
1. REMOVE EXISTING PANELBOARD IN THIS LOCATION AND REPLACE WITH NEW PANELBOARD AS SHOWN.
 2. SEE DETAIL A3-1 FOR ARCHITECTURAL WORK.

GENERAL NOTE:
1. SEE DRAWING E-100-153 FOR ONE LINE DIAGRAMS.




A3 MACVICAR - SECOND FLOOR PLAN
SCALE: 1/8" = 1'-0"



C&S Engineers, Inc.
499 Col. Eileen Collins Blvd.
Syracuse, New York 13212
Phone: 315-455-2000
Fax: 315-455-9687
www.cscos.com

REGISTERED
PE SE-100-153

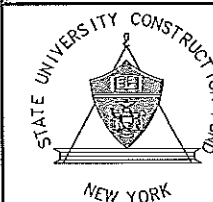

STATE UNIVERSITY CONSTRUCTION FUND
SUCF PROJECT NO. 12290
STATE UNIVERSITY OF NEW YORK AT POTSDAM
PRE-BID SUBMISSION - NOT FOR CONSTRUCTION
UPGRADE ELECTRICAL DISTRIBUTION SYSTEMS
VARIOUS BUILDINGS

MARK	DATE	DESCRIPTION
REVISIONS		
PROJECT NO:	190453.001	
DATE:	DECEMBER 5, 2009	
SCALE:	AS SHOWN	
DRAWN BY:	P.N. LUJ	
DESIGNED BY:	T.G. KUKIEWICZ	
CHECKED BY:	J.L. ROBERTS, P.E.	
NO ALTERATION PERMITTED HEREON EXCEPT AS PROVIDED UNDER SECTION 7209 SUBDIVISION 2 OF THE NEW YORK EDUCATION LAW		

ELECTRICAL


MACVICAR
FIRST & SECOND
FLOOR PLANS

E-100-15C



C&S Engineers, Inc.
499 Col. Eileen Collins Blvd.
Syracuse, New York 13212
Phone: 315-455-2000
Fax: 315-455-9687
www.cscos.com

INSERT C&S
FE SEAL HERE

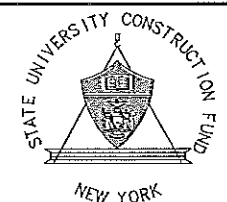


STATE UNIVERSITY CONSTRUCTION FUND
SUCF PROJECT NO. 12290
STATE UNIVERSITY OF NEW YORK AT POTSDAM
PRE-BID SUBMISSION - NOT FOR CONSTRUCTION
UPGRADE ELECTRICAL DISTRIBUTION SYSTEMS
VARIOUS BUILDINGS

MARK	DATE	DESCRIPTION
REVISIONS		
PROJECT NO: 191453.001		
DATE: DECEMBER 5, 2003		
SCALE: AS SHOWN		
DRAWN BY: P.N.WU		
DESIGNED BY: T.G.KILKREAVICH		
CHECKED BY: J.L.ROSSINI,P.E.		
NO ALTERATION PERMITTED HEREON EXCEPT AS PROVIDED UNDER SECTION 2203 SUBDIVISION 2 OF THE NEW YORK EDUCATION LAW		

ELECTRICAL


STILLMAN
FIRST & SECOND
FLOOR PLANS

E-100-15D

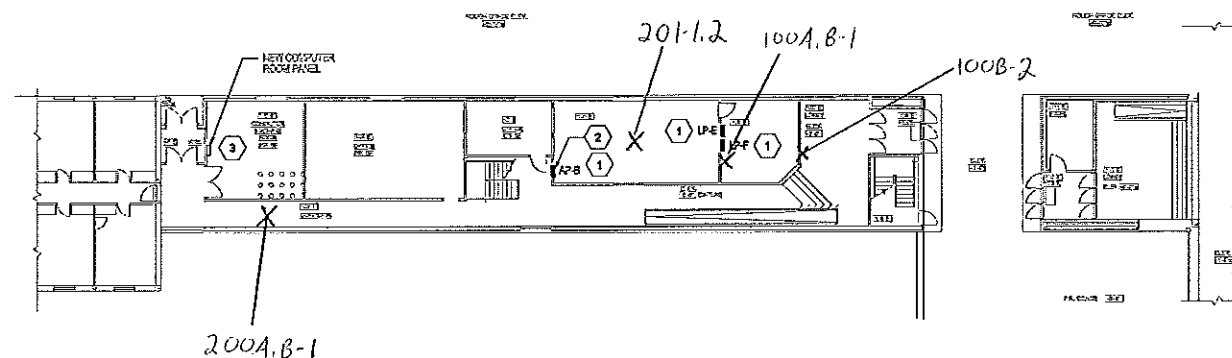


- DRAWING SPECIFIC NOTES:
- 1 REMOVE EXISTING PANELBOARD IN THIS LOCATION AND REPLACE WITH NEW PANEL BOARD AS SHOWN.
 - 2 SEE DETAIL A2A-501 FOR ARCHITECTURAL WORK.
 - 3 REMAINS.

C1 STILLMAN - FIRST FLOOR PLAN
SCALE: 1/8" = 1'-0"

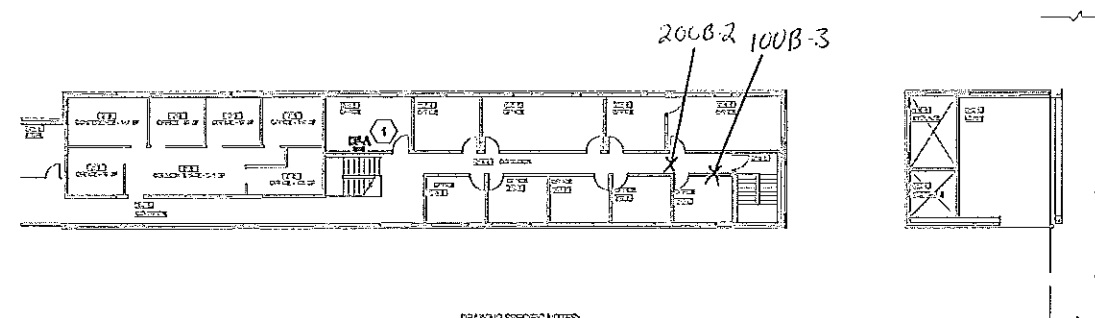


- DRAWING SPECIFIC NOTES:
- 1 REMOVE EXISTING PANELBOARD IN THIS LOCATION AND REPLACE WITH NEW PANEL BOARD AS SHOWN.


A1 STILLMAN - SECOND FLOOR PLAN
SCALE: 1/8" = 1'-0"

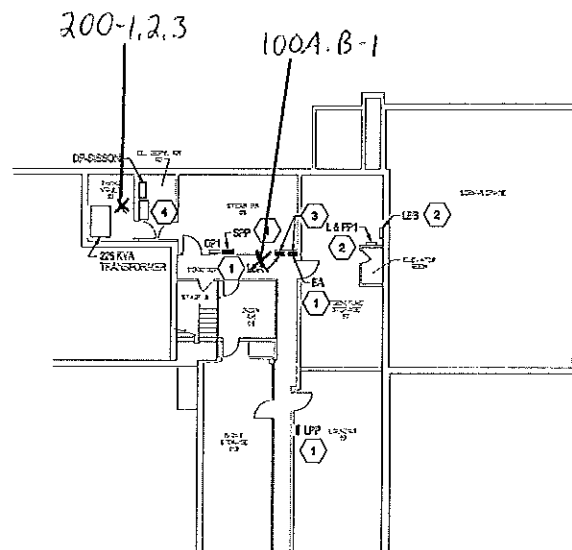

- DRAWING SPECIFIC NOTES**
- 1 REMOVE EXISTING PANELBOARD IN THIS LOCATION AND REPLACE WITH NEW PANEL BOARD AS SHOWN.
 - 2 REMAINS.
 - 3 SEE DETAIL A5A-511 FOR ARCHITECTURAL WORK.
 - 4 OLD PANEL ENCLOSURE UTILIZED AS JUNCTION BOX.

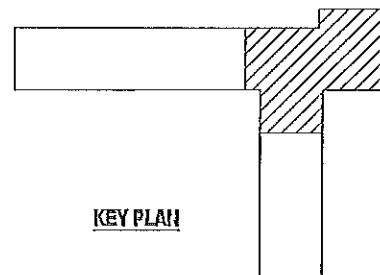


KEY PLAN

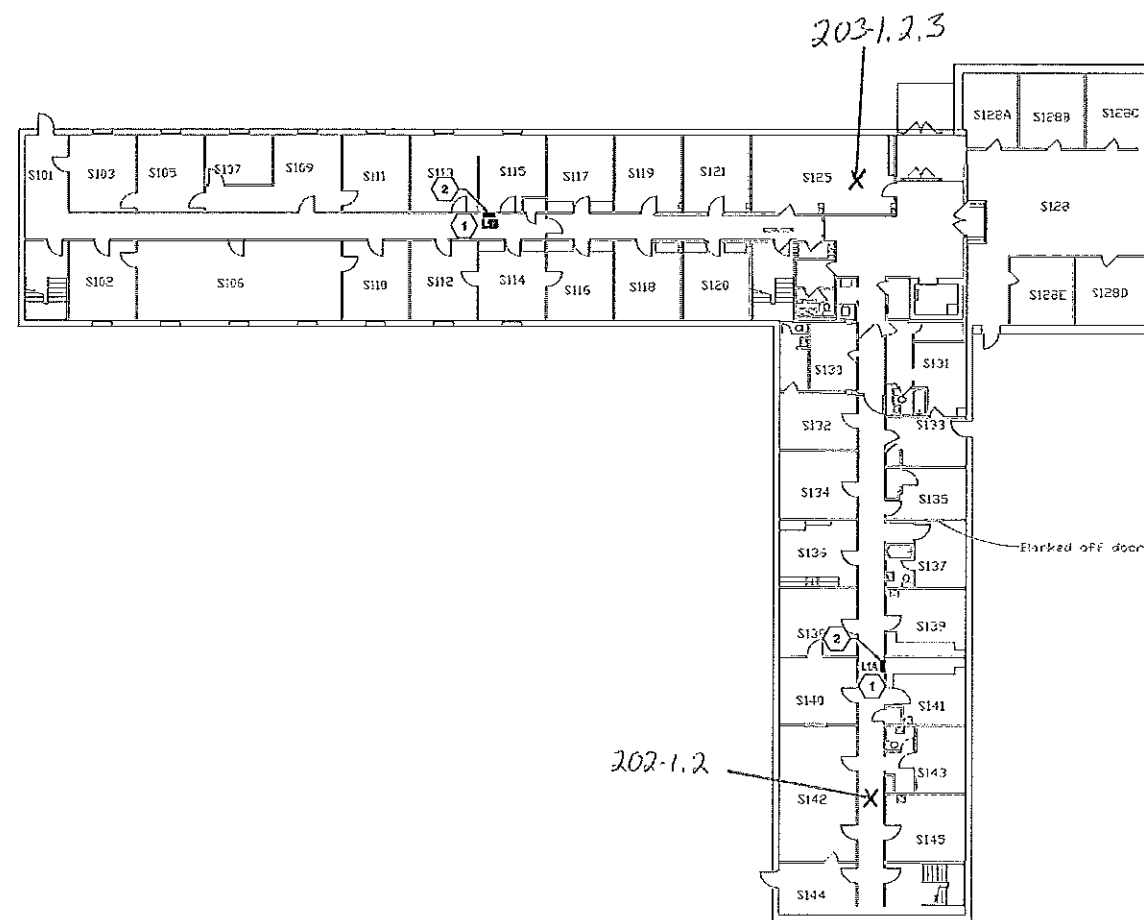

- DRAWING SPECIFIC NOTES**
- 1 REMOVE EXISTING PANELBOARD IN THIS LOCATION AND REPLACE WITH NEW PANEL BOARD AS SHOWN.
 - 2 SEE DETAIL A5A-511 FOR ARCHITECTURAL WORK.



C&S Engineers, Inc.
 499 Col. Elson Collins Blvd.
 Syracuse, New York 13212
 Phone: 315-455-2000
 Fax: 315-455-9687
 www.cscos.com

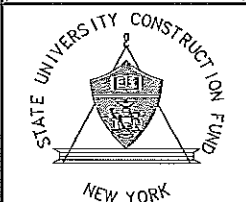

STATE UNIVERSITY CONSTRUCTION FUND
 SUCF PROJECT NO. 12290
 STATE UNIVERSITY OF NEW YORK AT POITSDAM
 PRE-BID SUBMISSION - NOT FOR CONSTRUCTION
 UPGRADE ELECTRICAL DISTRIBUTION SYSTEMS
 VARIOUS BUILDINGS

MARK	DATE	DESCRIPTION
REVISIONS		
PROJECT NO:	190453.001	
DATE:	DECEMBER 5, 2003	
SCALE:	AS SHOWN	
DRAWN BY:	P.N. LUJ	
DESIGNED BY:	T.G. KUNIEWICZ	
CHECKED BY:	J.L. ROBBINS, P.E.	
NO ALTERATION PERMITTED HEREON EXCEPT AS PROVIDED UNDER SECTION 7209 SUBDIVISION 2 OF THE NEW YORK EDUCATION LAW		

ELECTRICAL

**SISSON
 BASEMENT & FIRST
 FLOOR PLANS**

E-100-17a

A1 SISSON - PARTIAL BASEMENT PLAN
 SCALE 1/8" = 1'-0"

A3 SISSON - FIRST FLOOR PLAN
 SCALE 1/8" = 1'-0"



C&S Engineers, Inc.
499 Col. Eileen Collins Blvd.
Syracuse, New York 13212
Phone: 315-455-2000
Fax: 315-455-6687
www.csc008.com

INSER C&S
PE SEAL HERE



STATE UNIVERSITY CONSTRUCTION FUND
SUCF PROJECT NO. 12290
STATE UNIVERSITY OF NEW YORK AT POISSDAM
PRE-BID SUBMISSION - NOT FOR CONSTRUCTION
UPGRADE ELECTRICAL DISTRIBUTION SYSTEMS
VARIOUS BUILDINGS


MARK	DATE	DESCRIPTION
REVISIONS		
PROJECT NO: 190.433.001		
DATE: DECEMBER 5, 2003		
SCALE: AS SHOWN		
DRAWN BY: P.H.UU		
DESIGNED BY: T.G. KUNIEWICZ		
CHECKED BY: J.L. ROSS, P.E.		
NO ALTERATION PERMITTED HEREON EXCEPT AS PROVIDED UNDER SECTION 2209 SUBDIVISION 2 OF THE NEW YORK EDUCATION LAW		

ELECTRICAL


SISSON
SECOND & THIRD
FLOOR PLANS

E-100-17b

DATE: 12/5/03
DRAWN BY: P.H.UU
DESIGNED BY: T.G. KUNIEWICZ
CHECKED BY: J.L. ROSS, P.E.

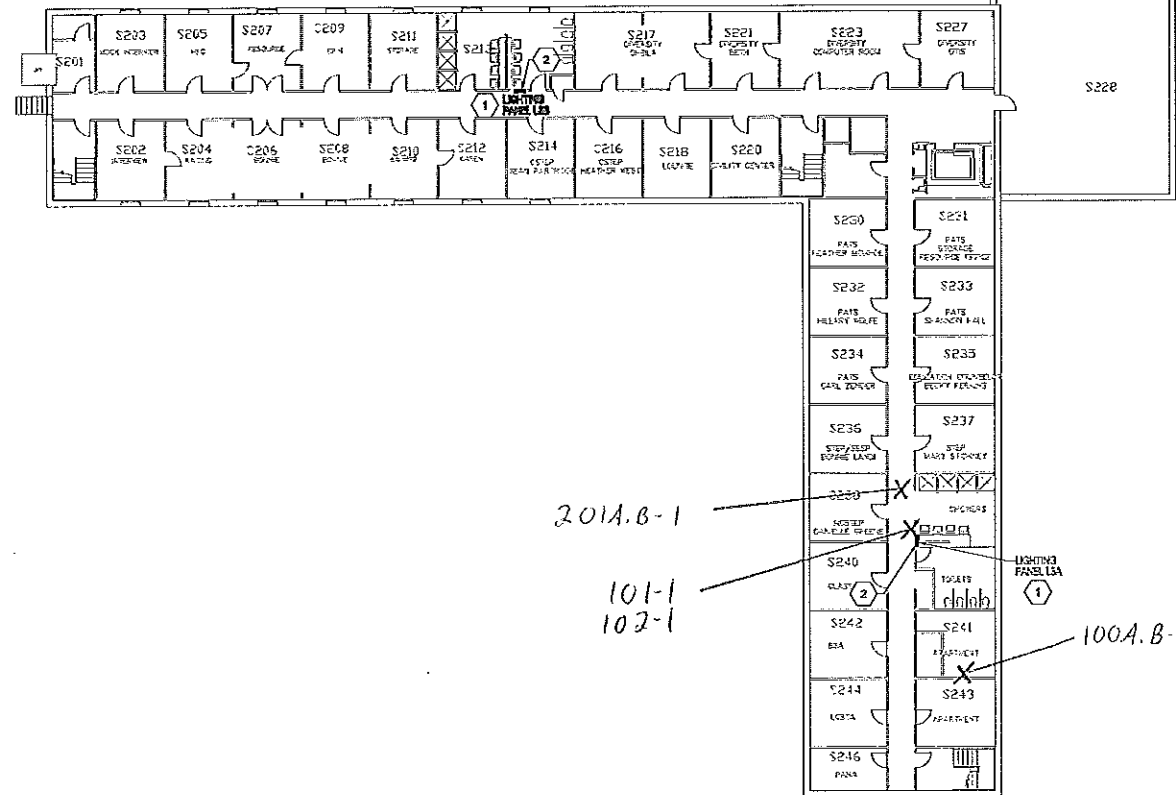

A3 SISSON - THIRD FLOOR PLAN
SCALE: 1/8" = 1'-0"

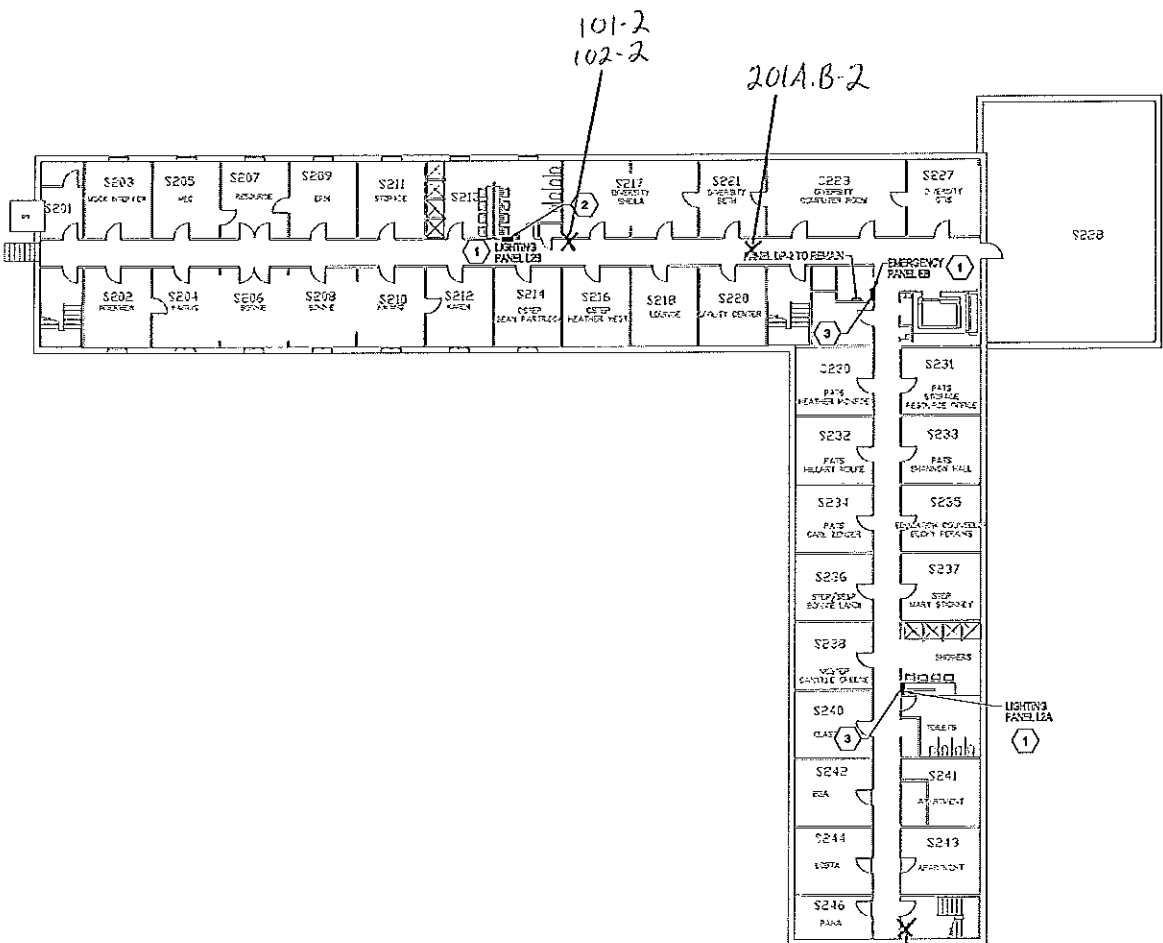

A1 SISSON - SECOND FLOOR PLAN
SCALE: 1/8" = 1'-0"



C&S Engineers, Inc.
499 Col. Elson Collins Blvd.
Syosset, New York 11791
Phone: 516-455-2000
Fax: 516-455-9887
www.cscos.com




STATE UNIVERSITY CONSTRUCTION FUND
NEW YORK

STATE UNIVERSITY CONSTRUCTION FUND
SUCF PROJECT NO. 12290
STATE UNIVERSITY OF NEW YORK AT POTSDAM
PRE-BID SUBMISSION - NOT FOR CONSTRUCTION
UPGRADE ELECTRICAL DISTRIBUTION SYSTEMS
VARIOUS BUILDINGS


MARK	DATE	DESCRIPTION
REVISIONS		
1	10/14/03	PROJECT NO. 191.453.001
2	10/14/03	DATE: DECEMBER 8, 2003
3	10/14/03	SCALE: AS SHOWN
4	10/14/03	DRAWN BY: P.N.W.
5	10/14/03	DESIGNED BY: T.D. MIKHEVICH
6	10/14/03	CHECKED BY: J.L. ROSS, P.E.
NO ALTERATION PERMITTED HEREON EXCEPT AS PROVIDED UNDER SECTION 7209 SUBDIVISION 2 OF THE NEW YORK EDUCATION LAW		

ELECTRICAL
THATCHER
FIRST & SECOND
FLOOR PLANS

E-100-19

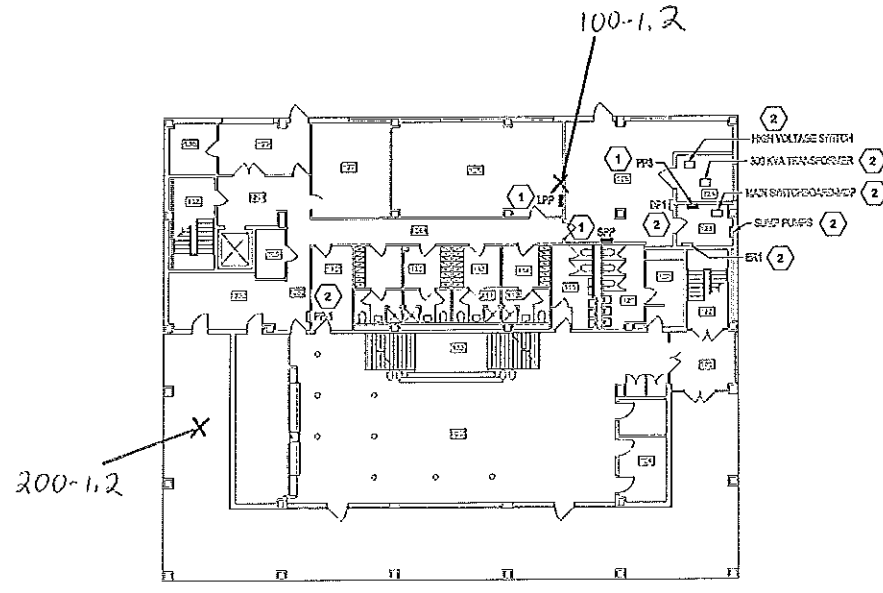


- DRAWING SPECIFIC NOTES:
- 1 REMOVE EXISTING PANEL BOARDS IN THIS LOCATION AND REPLACE WITH NEW PANEL BOARD AS SHOWN.
 - 2 REMAINS.

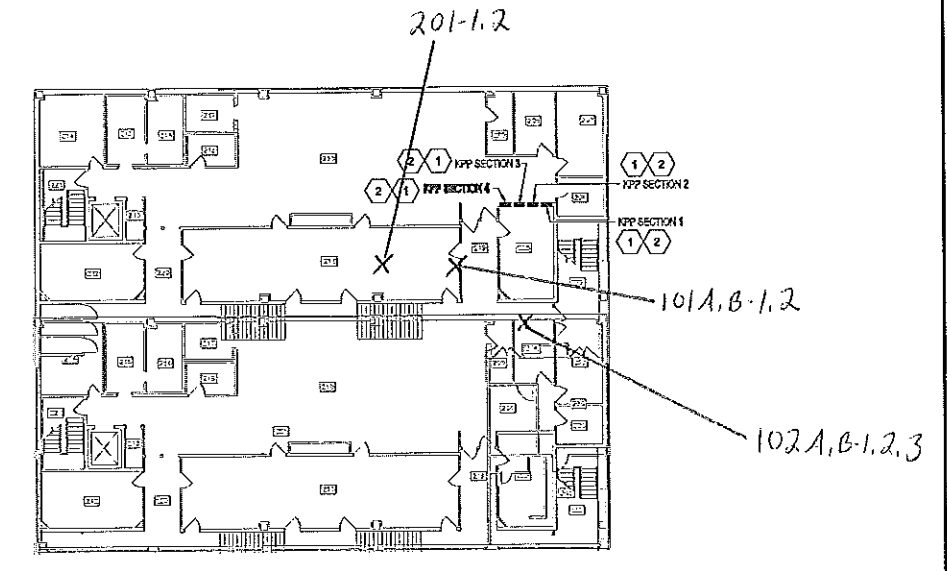

- DRAWING SPECIFIC NOTES:
- 1 REMOVE EXISTING PANEL BOARD IN THIS LOCATION AND REPLACE WITH NEW PANEL BOARD AS SHOWN.
 - 2 SEE DETAIL 02A-5/1 FOR ARCHITECTURAL WORK.

A1 THATCHER - FIRST FLOOR PLAN
SCALE: 1/8" = 1'-0"

A3 THATCHER - SECOND FLOOR PLAN
SCALE: 1/8" = 1'-0"

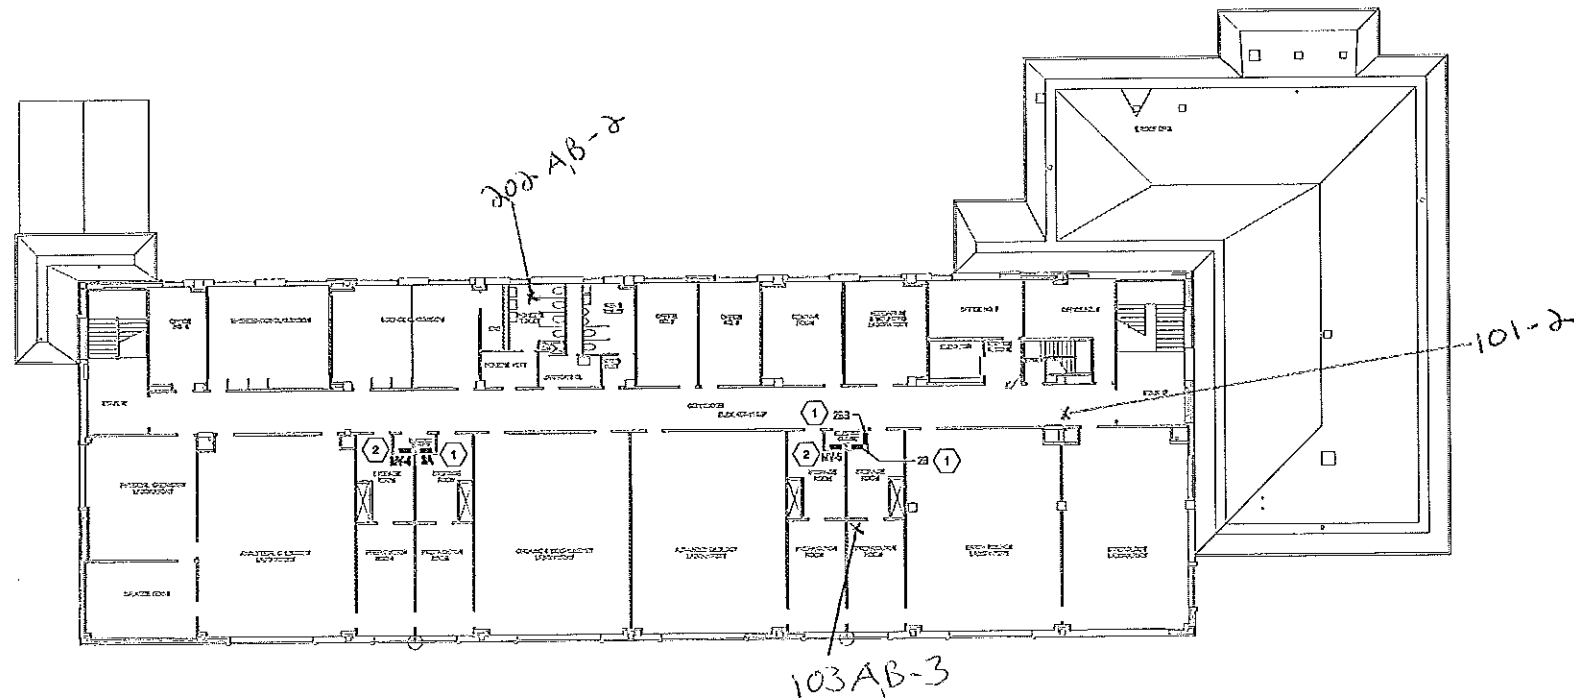


- DRAWING SPECIFIC NOTES:**
- 1 REMOVE EXISTING PANELBOARD IN THIS LOCATION AND REPLACE WITH NEW PANEL BOARD AS SHOWN.
 - 2 REMOVE EXISTING PANELBOARD AND DO SECTION 2 AND REPLACE WITH PANELBOARD AS SHOWN.



A1 STOWELL - SECOND FLOOR PLAN
SCALE: 1/8" = 1'-0"



C&S Engineers, Inc.
499 Col. Eileen Collins Blvd.
Syracuse, New York 13212
Phone: 315-455-2000
Fax: 315-455-9887
www.cscos.com

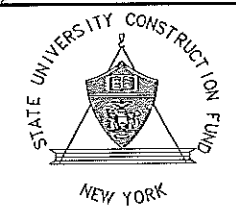

STATE UNIVERSITY CONSTRUCTION FUND
SUCF PROJECT NO. 12290
STATE UNIVERSITY OF NEW YORK AT POTSDAM
PRE-BID SUBMISSION - NOT FOR CONSTRUCTION
UPGRADE ELECTRICAL DISTRIBUTION SYSTEMS
VARIOUS BUILDINGS

MARK	DATE	DESCRIPTION
REVISIONS		
PROJECT NO:	199-453-001	
DATE:	DECEMBER 5, 2003	
SCALE:	AS SHOWN	
DRAWN BY:	P.H. LUJ	
DESIGNED BY:	T.B. MURKOWSKI	
CHECKED BY:	J.L. ROSSINI, P.E.	
NO ALTERATION PERMITTED HEREON EXCEPT AS PROVIDED UNDER SECTION 2203 SUBDIVISION 2 OF THE NEW YORK EDUCATION LAW		



ELECTRICAL
STOWELL
SECOND FLOOR
PLAN

E-100-21b

APR 15, 2004 - 02740P - SUPPLEMENTAL TO E-100-211-001



C&S Engineers, Inc.
499 Col. Elson Colina Blvd.
Syosset, New York 11791
Phone: 516-455-2000
Fax: 516-455-9687
www.cscos.com

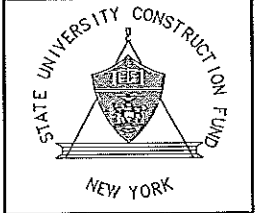
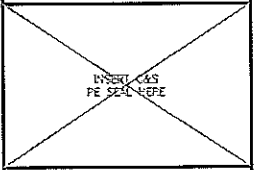


STATE UNIVERSITY CONSTRUCTION FUND
SUCF PROJECT NO. 12290
STATE UNIVERSITY OF NEW YORK AT POTSDAM
PRE-BID SUBMISSION - NOT FOR CONSTRUCTION
UPGRADE ELECTRICAL DISTRIBUTION SYSTEMS
VARIOUS BUILDINGS



MARK	DATE	DESCRIPTION
REVISIONS		
1		PROJECT NO: 190453.001
2		DATE: DECEMBER 5, 2003
3		SCALE: AS SHOWN
4		DRAWN BY: P.N. LIN
5		DESIGNED BY: T.G. KUKIEWICZ
6		CHECKED BY: J.L. ROSSINI, P.E.
NO ALTERATION PERMITTED HEREON EXCEPT AS PROVIDED UNDER SECTION 2209 SUBDIVISION 2 OF THE NEW YORK EDUCATION LAW		

ELECTRICAL
KNOWLES DINING
BASEMENT &
SECOND FLOOR
PLANS

E-100-22

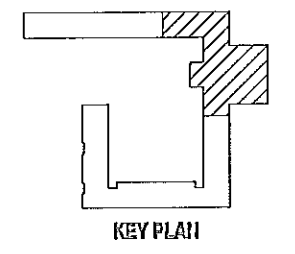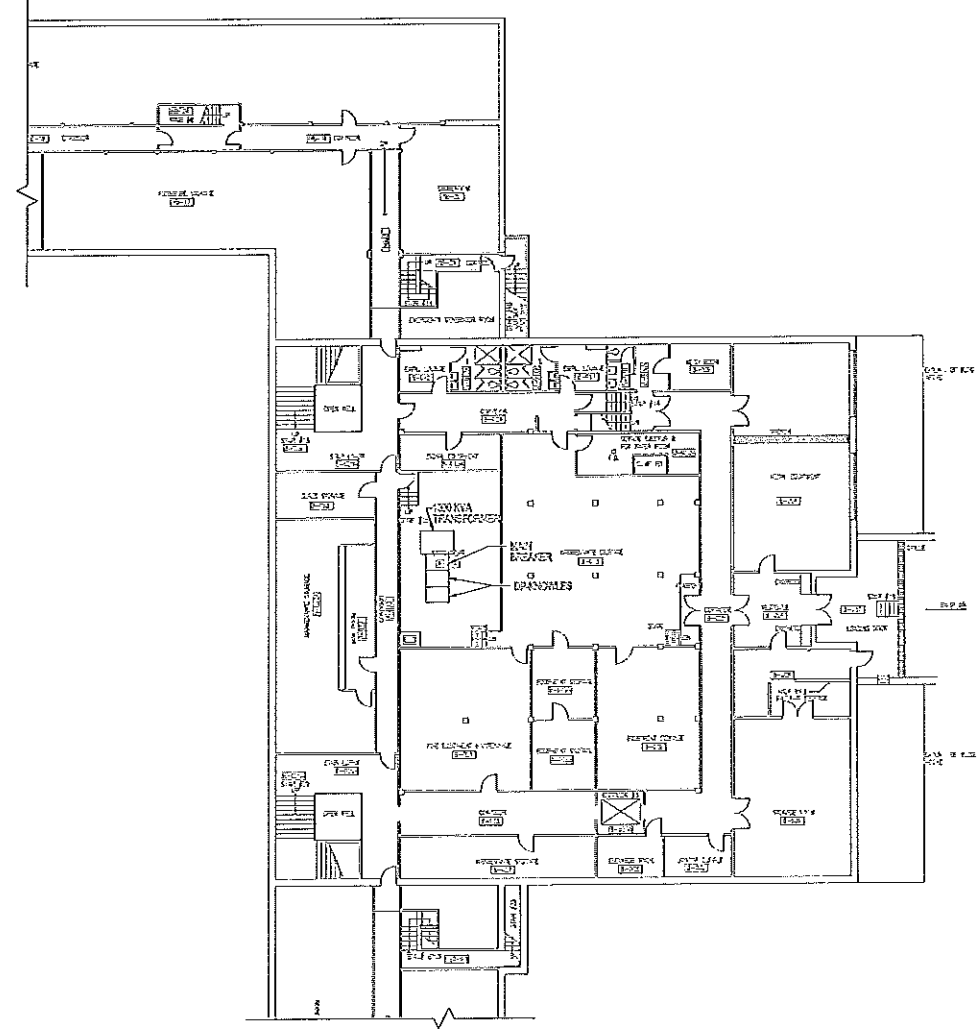

A1 KNOWLES DINING - BASEMENT PLAN
SCALE: 1/8" = 1'-0"

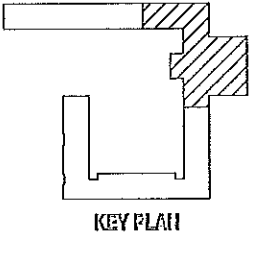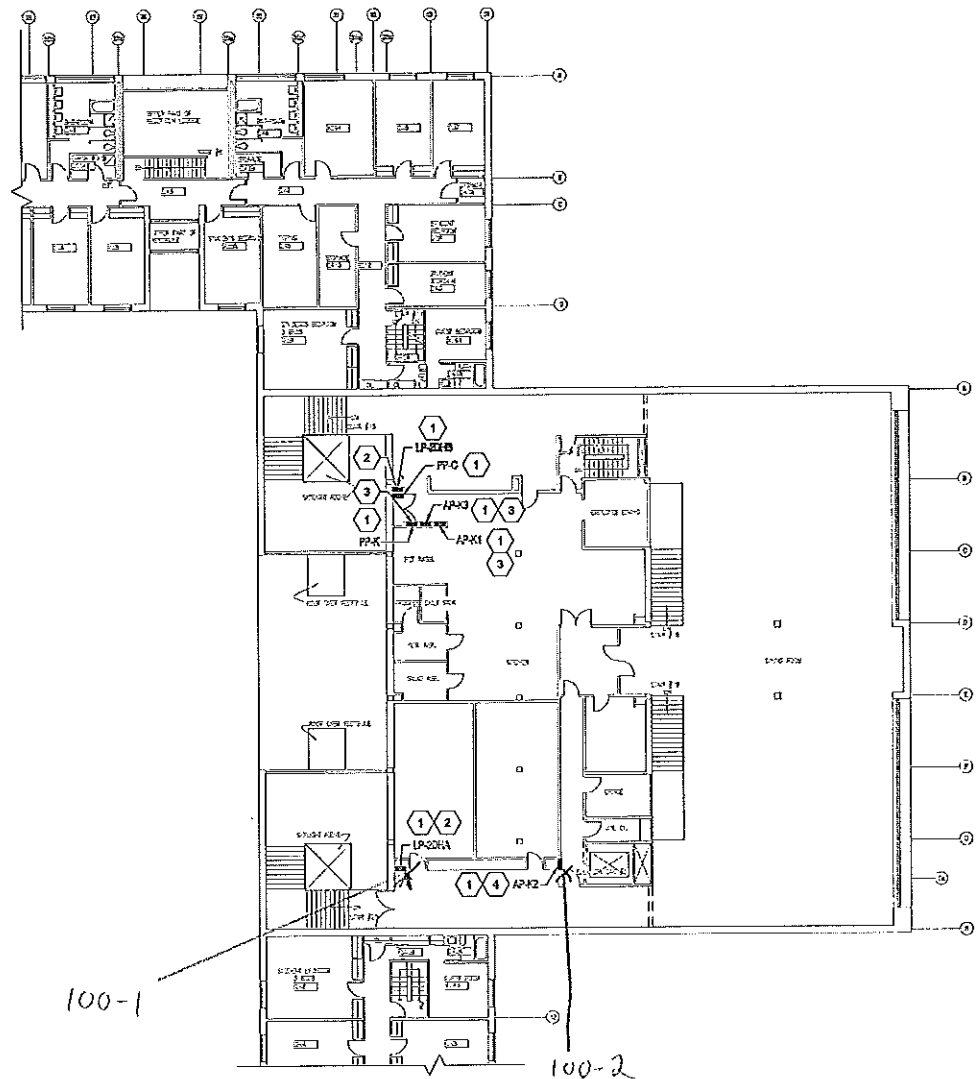


A3 KNOWLES DINING - SECOND FLOOR PLAN
SCALE: 1/8" = 1'-0"

- DRAWING SPECIFIC NOTES:
- 1 REMOVE EXISTING PANEL BOARD IN THIS LOCATION AND REPLACE WITH NEW PANEL BOARD AS SHOWN.
 - 2 SEE DETAIL C24001 FOR ARCHITECTURAL WORK.
 - 3 SEE DETAIL D24001 FOR ARCHITECTURAL WORK.
 - 4 SEE DETAIL A24001 FOR ARCHITECTURAL WORK.



C&S Engineers, Inc.
499 Col. Eileen Collins Blvd.
Syracuse, New York 13212
Phone: 315-455-2000
Fax: 315-455-9607
www.cscs.com

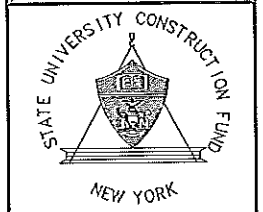


STATE UNIVERSITY CONSTRUCTION FUND
SUCF PROJECT NO. 12290
STATE UNIVERSITY OF NEW YORK AT POTSDAM
PRE-BID SUBMISSION - NOT FOR CONSTRUCTION
UPGRADE ELECTRICAL DISTRIBUTION SYSTEMS
VARIOUS BUILDINGS

MARK	DATE	DESCRIPTION
REVISIONS		
PROJECT NO:	190433.001	
DATE:	DECEMBER 5, 2009	
SCALE:	AS SHOWN	
DRAWN BY:	P.N.W.	
DESIGNED BY:	T.G. RUZICKI	
CHECKED BY:	J.L. ROSEN, P.E.	
NO ALTERATION PERMITTED HEREON EXCEPT AS PROVIDED UNDER SECTION 7209, SUBDIVISION 2 OF THE NEW YORK EDUCATION LAW		

ELECTRICAL
MAINTENANCE
CENTER
FIRST FLOOR
PLAN

E-100-24

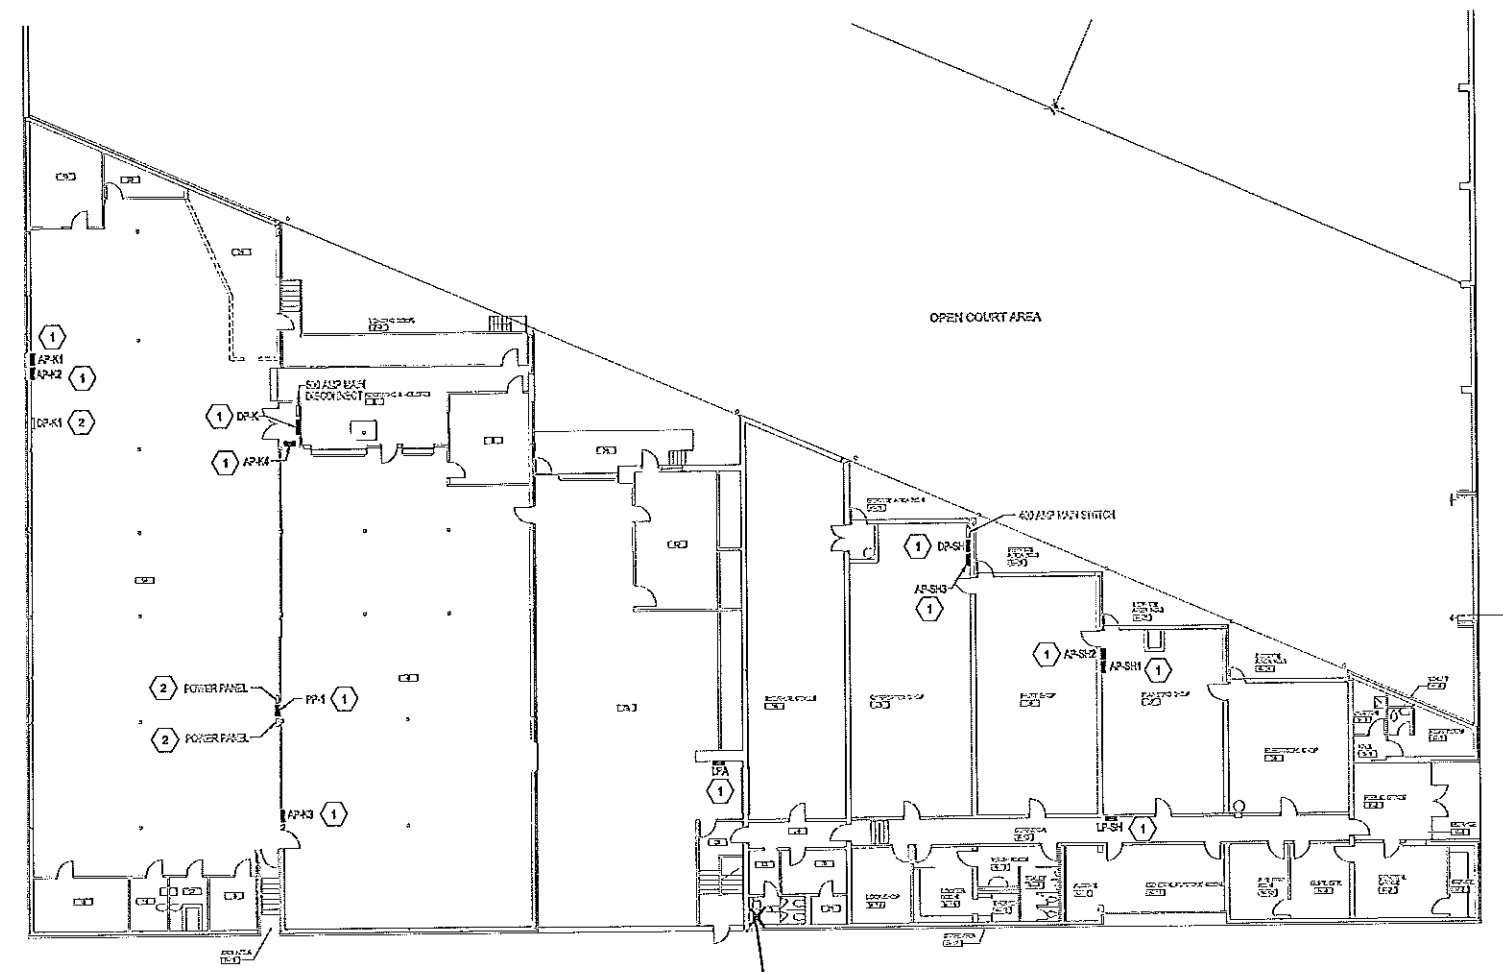

- DRAWING SPECIFIC NOTES:
- 1 REMOVE EXISTING PANELS AS SHOWN IN THIS LOCATION AND
REPLACE WITH NEW PANEL BOARD AS SHOWN.
 - 2 REMAINS.



A1 MAINTENANCE PLANT - FIRST FLOOR PLAN
SCALE: 1/8" = 1'-0"

**UPGRADE ENERGY
MANAGEMENT SYSTEMS -
VARIOUS BUILDINGS**

**STATE UNIVERSITY
CONSTRUCTION
FUND**



Bergmann
associates


Engineers / Architects /Planners/ Surveyors

**PRE-BID
SUBMISSION**

**BRAINERD
FIRST FLOOR PLAN**


Project Number	File Name
7771.00	W:\PROJECTS\98\980601\980601.DWG

Drawing Number:
ATC100-26

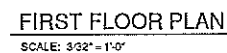

1. EXISTING SENSORS ARE NOT COMPARABLE WITH NEW DOG, REPLACE ALL SENSORS WITH NEW, REUSE W/NO UNLESS OTHERWISE INDICATED. VERIFY INTEGRITY OF W/NO BEFORE REUSE. SENSOR LOCATIONS SHOWN BASED ON AS-BUILT DRAWINGS, ACTUAL LOCATION MAY VARY SLIGHTLY.
2. EXISTING POINT UPW POINT ID'S ARE BASED ON AS BUILT DRAWINGS. FIELD VERIFICATION HAS SHOWN MOST TO BE ACCURATE HOWEVER APPROXIMATELY 10% WERE FOUND TO BE TENETIVE LOCATIONS. EACH POINT WILL REQUIRE VERIFICATION PRIOR TO REUSE. ADVISE IF DEVICE IS IMPERFABLE OR W/NO CANNOT BE REUSED.

1. DESTROY S-5 TRINE UPLC, REMOVE AND INSTALL NEW DOG PANEL. PROVIDE H-0-A SELECTOR SWITCH IN SEPARATE ENCLOSURE FOR SUPPLY AND RETURN FAN. PROVIDE CURRENT SWITCHES AND STATUS POINTS. TRANSFER 110V POWER.
2. UH-2, PROVIDE NEW THERMOSTAT, DOG CONTROLLER, REUSE WIRING, VALVE AND ACTUATOR.
3. DESTROY S-6 TRINE UPLC, REMOVE AND INSTALL NEW DOG PANEL. PROVIDE H-0-A SELECTOR SWITCH IN SEPARATE ENCLOSURE FOR SUPPLY FAN. PROVIDE CURRENT SWITCH AND STATUS POINT. TRANSFER 110V POWER.
4. DETCON U48 ENFORCER OUTSIDE AIRFLOW METER TO RETURN.
5. DESTROY DAW PUMP STARTER PROVIDE COLLECTION METER STARTER WITH H-0-A SELECTOR SWITCH. PROVIDE CURRENT SWITCH, STATUS POINTS AND RESET START/STOP CAPABILITIES. REPLACE TEMP SENSOR.
6. UPW PANEL AND AIRFLOW METER RACK, REFER TO DECAL DWG.
7. WSG LOCATION.
8. DESTROY AHU-1 TRINE UPLC, REMOVE AND INSTALL NEW DOG PANEL. REUSE DEVICES AND WIRING AS PER POINTS LIST. PROVIDE H-0-A SELECTOR SWITCHES IN SEPARATE ENCLOSURE FOR SUPPLY AND RETURN FAN. PROVIDE CURRENT SWITCHES AND STATUS POINTS. TRANSFER 110V POWER.
9. DESTROY AHU-3 TRINE UPLC, REMOVE AND INSTALL NEW DOG PANEL. REUSE DEVICES AND WIRING AS PER POINTS LIST. PROVIDE H-0-A SELECTOR SWITCHES IN SEPARATE ENCLOSURE FOR SUPPLY AND RETURN FAN. PROVIDE CURRENT SWITCHES AND STATUS POINTS. TRANSFER 110V POWER.
10. DESTROY AHU-2 TRINE UPLC, REMOVE AND INSTALL NEW DOG PANEL. REUSE DEVICES AND WIRING AS PER POINTS LIST. PROVIDE H-0-A SELECTOR SWITCH IN SEPARATE ENCLOSURE FOR SUPPLY FAN. PROVIDE CURRENT SWITCH AND STATUS POINT. TRANSFER 110V POWER.
11. DESTROY DELTA PANEL #3 EXCEL, EXCEL INCLUDES, BOLD SM PRESSURE, BOLD AIR ALARM, ELEVATOR RM H WATER ALARM, FIRE ALARM, FIRE ALARM TROUBLE, LAB AIR ALARM, PHASE CELL STATUS, ROADWAY LIGHT STATUS, ROADWAY LIGHTS, - ALL TO RETURN. PROVIDE 3/4" BUT CONSULT WITH 2-MULTITUDE FIBER OPTIC CABLES TO FIBER PATCH PANEL.
12. REPLACE TEMP SENSOR WITH NEW, REUSE VALVE ACTUATOR, ACTUATOR.
13. DESTROY POWER QUALITY METER. PROVIDE TE-NS TO DOG PANEL. REFER TO WIRING DIAGRAM #20 ON DRAWING ADO-054.
14. LOCATION OF NEW STATE SENSOR FUSERS. PROVIDE 3/4" BUT CONSULT WITH 2-#12 AND 1-#12 GROUND FROM 110V POWER SUPPLY IN KENDATE #11.
15. PROVIDE CURRENT SWITCH AND START/STOP DELAY FOR SOILER B-1. PROVIDE ALARM WIRING TO DOG PANEL AND CONNECT TO ALARM CONTACT IN SAKER CONTROL BOARD.
16. CW METER, REPLACE RESISTOR WITH NEW PURGE TYPE, REFER TO METER SCHEDULE.
17. PROVIDE CURRENT SWITCHES AND STATUS POINTS FOR P-14, P-18, P-2A AND P-20. PROVIDE H-0-A SELECTOR SWITCHES IN DESTROY VESSEL LOCATED IN WSG. REFER TO POINTS LIST FOR QUANTITIES.
18. RECONNECT WIRING FOR EXHAUST FANS LOCATED IN WSG. REFER TO POINTS LIST FOR QUANTITIES.
19. RECONNECT 3/4" BUT CONSULT WITH 1-#22 UPTO INDIVIDUAL CONTROL PANELS.
20. FIELD VERIFY LOCATION OF SUPPLY FAN S-8. PROVIDE H-0-A SELECTOR SWITCH IN SEPARATE ENCLOSURE PROVIDE CURRENT SWITCH AND STATUS POINTS. REFER TO POINTS LIST FOR QUANTITIES.
21. FIELD VERIFY THE LOCATION OF THE FOLLOWING EQUIPMENT: AC-1, AC-2, CORRIDOR GUN, UH-101A, FAN COIL 1, UH-123, UH-131, UH-132 AND SUPPLY FAN SET. REPLACE DEVICES ON POINTS LIST. TRANSFER WIRING.

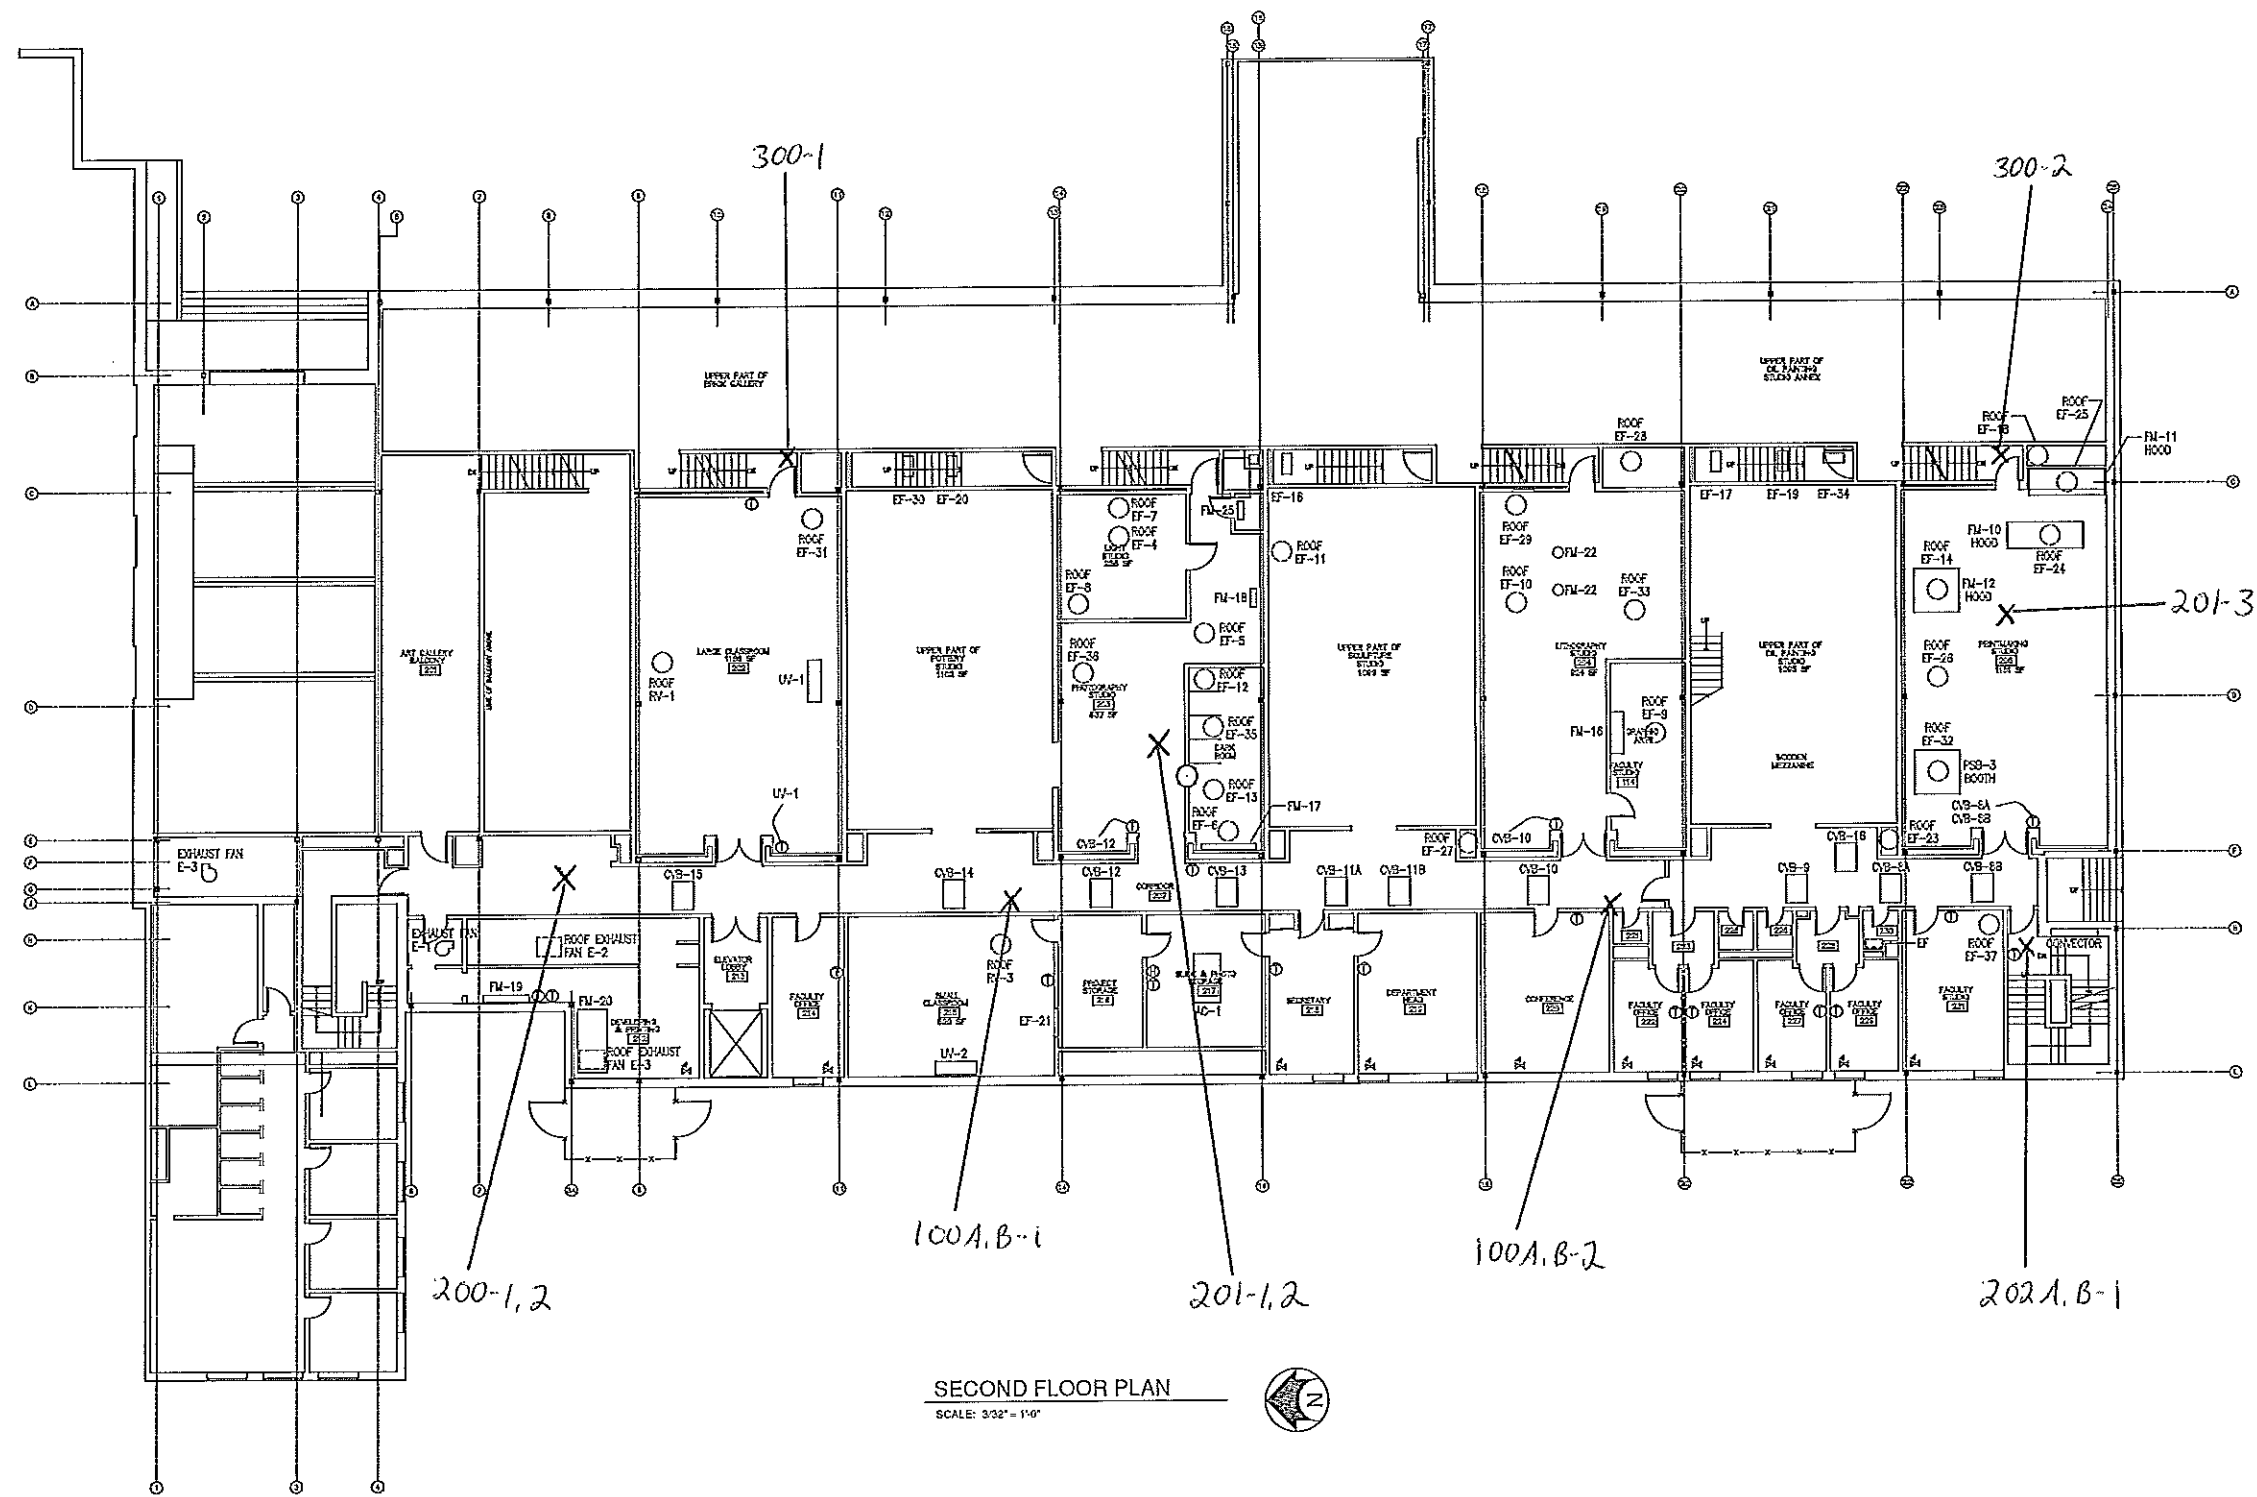

GENERAL NOTES:

- EXISTING SENSORS ARE NOT COMPARABLE WITH NEW DOCS. REPLACE ALL SENSORS WITH NEW. REUSE WIRELESS SENSORS UNLESS OTHERWISE INDICATED. VERIFY INTEGRITY OF WIRELESS SENSORS. SENSOR LOCATIONS SHOWN BASED ON AS-BUILT DRAWINGS. ACTUAL LOCATION MAY VARY SLIGHTLY.
- EXISTING POINT UPW POINT D/S ARE BASED ON AS-BUILT DRAWINGS. FIELD VERIFICATION HAS SHOWN MOST TO BE ACCURATE HOWEVER APPROXIMATELY 10% WERE FOUND TO BE IMPRECISE LOCATIONS. EACH POINT WILL REQUIRE VERIFICATION PRIOR TO REUSE. ADVISE IF DEVICE IS REPAIRABLE OR WIRELESS CANNOT BE REUSED.

RENOVATION KEYNOTES:

- PROVIDE

S.U.C.F. PROJECT
NO. 12294

UPGRADE ENERGY
MANAGEMENT SYSTEMS -
VARIOUS BUILDINGS

The State University
of New York at Potsdam
Potsdam, New York

STATE UNIVERSITY
CONSTRUCTION
FUND

STATE UNIVERSITY PLAZA
353 BROADWAY
ALBANY, NY 12246



www.bergmannpo.com

28 East Main Street
200 First Federal Plaza
Rochester, New York 14614
585.232.5135 / 585.232.4652 fax

Engineers / Architects / Planners / Surveyors

REVISIONS				
NO.	DATE	DESCRIPTION	REV.	CHKD.

PRE-BID
SUBMISSION


NOTE:
Unauthorized alteration or addition to this drawing is a
violation of the New York State Education Law Article
145, Section 7209.

BRAINERD
SECOND FLOOR PLAN


Project Manager	D. PORTER
Designer	D. PORTER
Checker	M. ELIASZ
Engineer	
Architect	
Surveyor	
AS NOTED	

Project Number: 7771.00
Drawing Number: 100A,B-1

ATC101-26

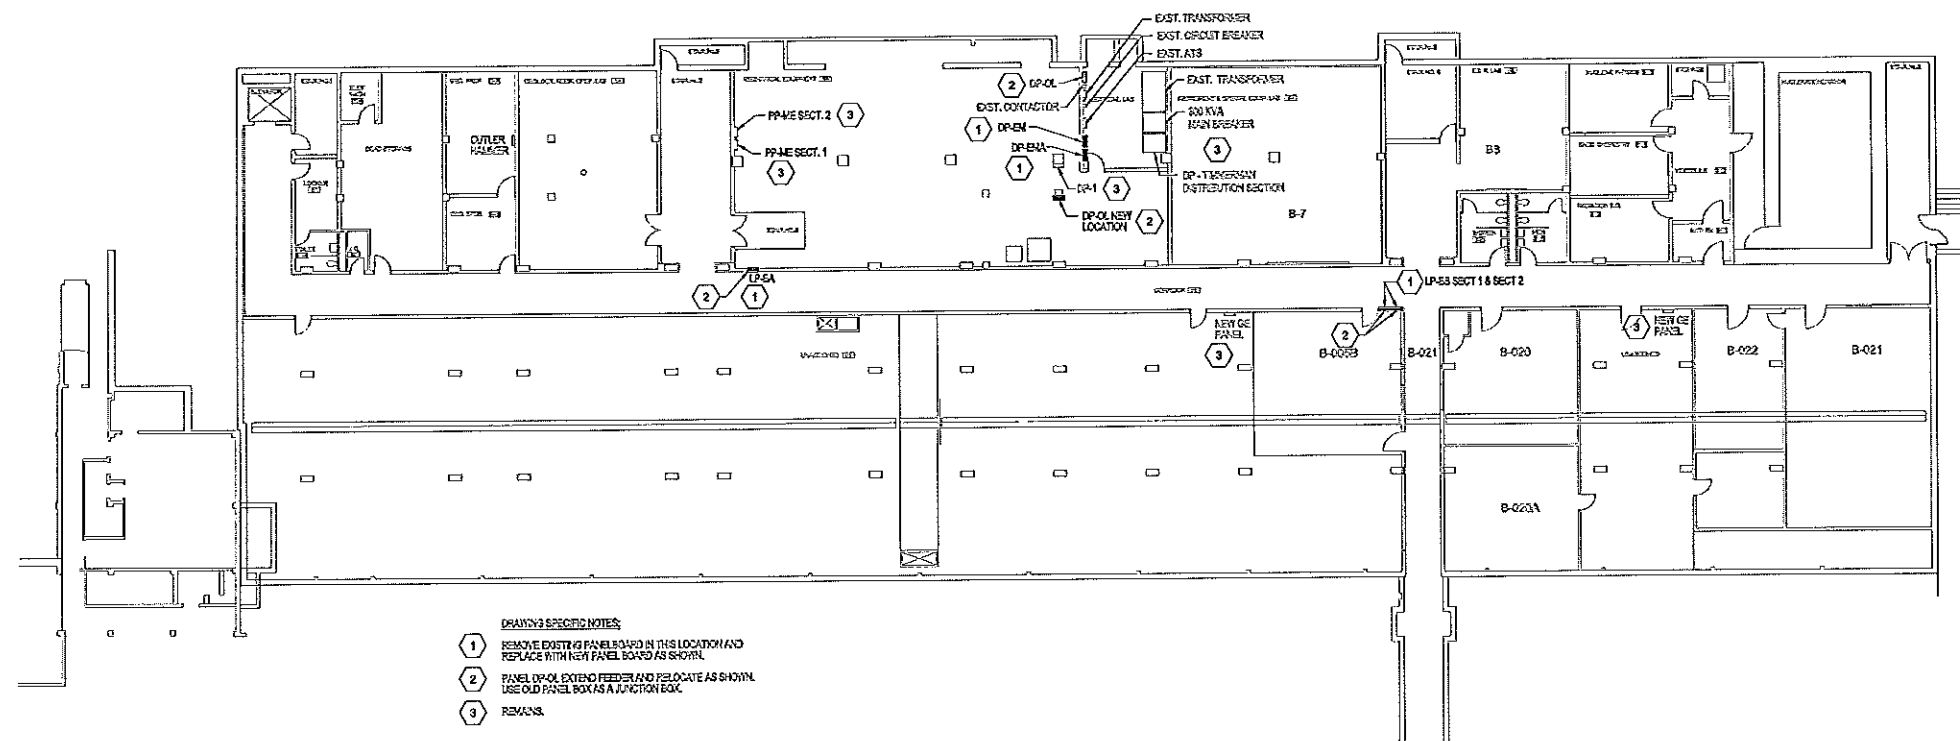

C1 TIMMERMAN - BASEMENT PLAN
SCALE: 1/16" = 1'-0"

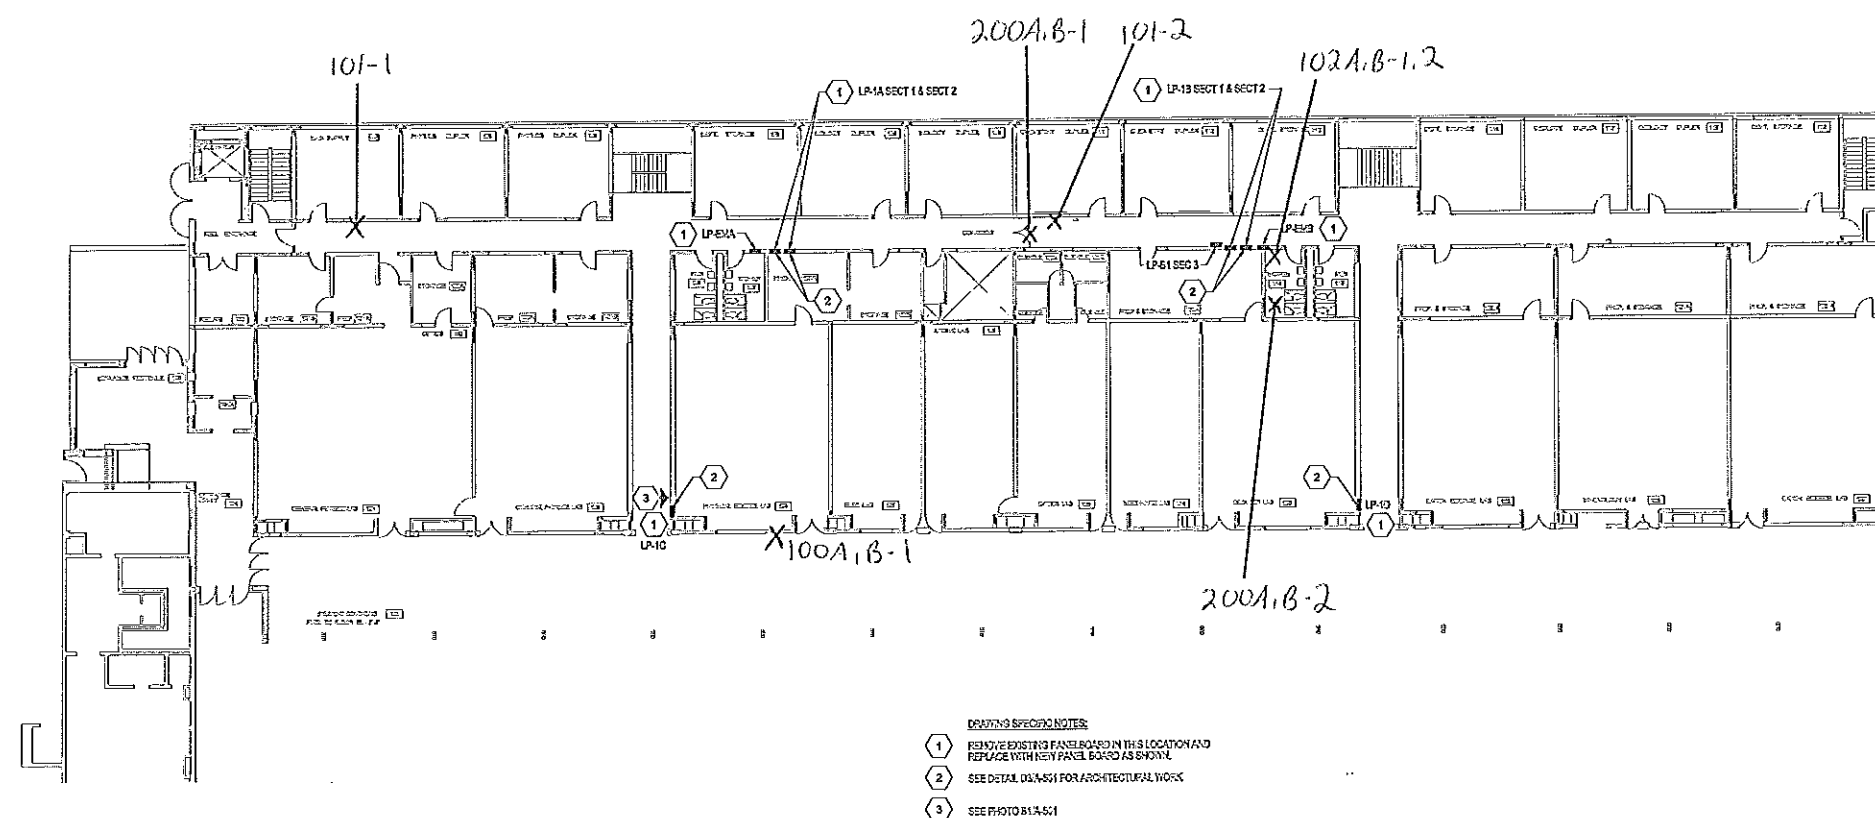


A1 TIMMERMAN - FIRST FLOOR PLAN
SCALE: 1/16" = 1'-0"



C&S Engineers, Inc.
499 Col. Eileen Collins Blvd.
Syosset, New York 11791
Phone: 315-455-2000
Fax: 315-455-9687
www.cscs.com

INSERT C&S
PE SEAL HERE

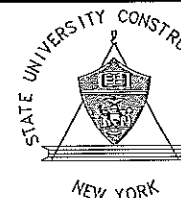


STATE UNIVERSITY CONSTRUCTION FUND
SUCF PROJECT NO. 12290
STATE UNIVERSITY OF NEW YORK AT POTSDAM
PRE-BID SUBMISSION - NOT FOR CONSTRUCTION
UPGRADE ELECTRICAL DISTRIBUTION SYSTEMS
VARIOUS BUILDINGS

MARK	DATE	DESCRIPTION
REVISIONS		
PROJECT NO:	100-433-001	
DATE:	DECEMBER 5, 2009	
SCALE:	AS SHOWN	
DRAWN BY:	P.N. LIU	
DESIGNED BY:	T.G. KUKIEWICZ	
CHECKED BY:	J.L. ROSS, P.E.	
NO ALTERATION PERMITTED HEREON EXCEPT AS PROVIDED UNDER SECTION 7209 SUBDIVISION 2 OF THE NEW YORK EDUCATION LAW		

ELECTRICAL
TIMMERMAN
BASEMENT & FIRST
FLOOR PLANS

E-100-27a

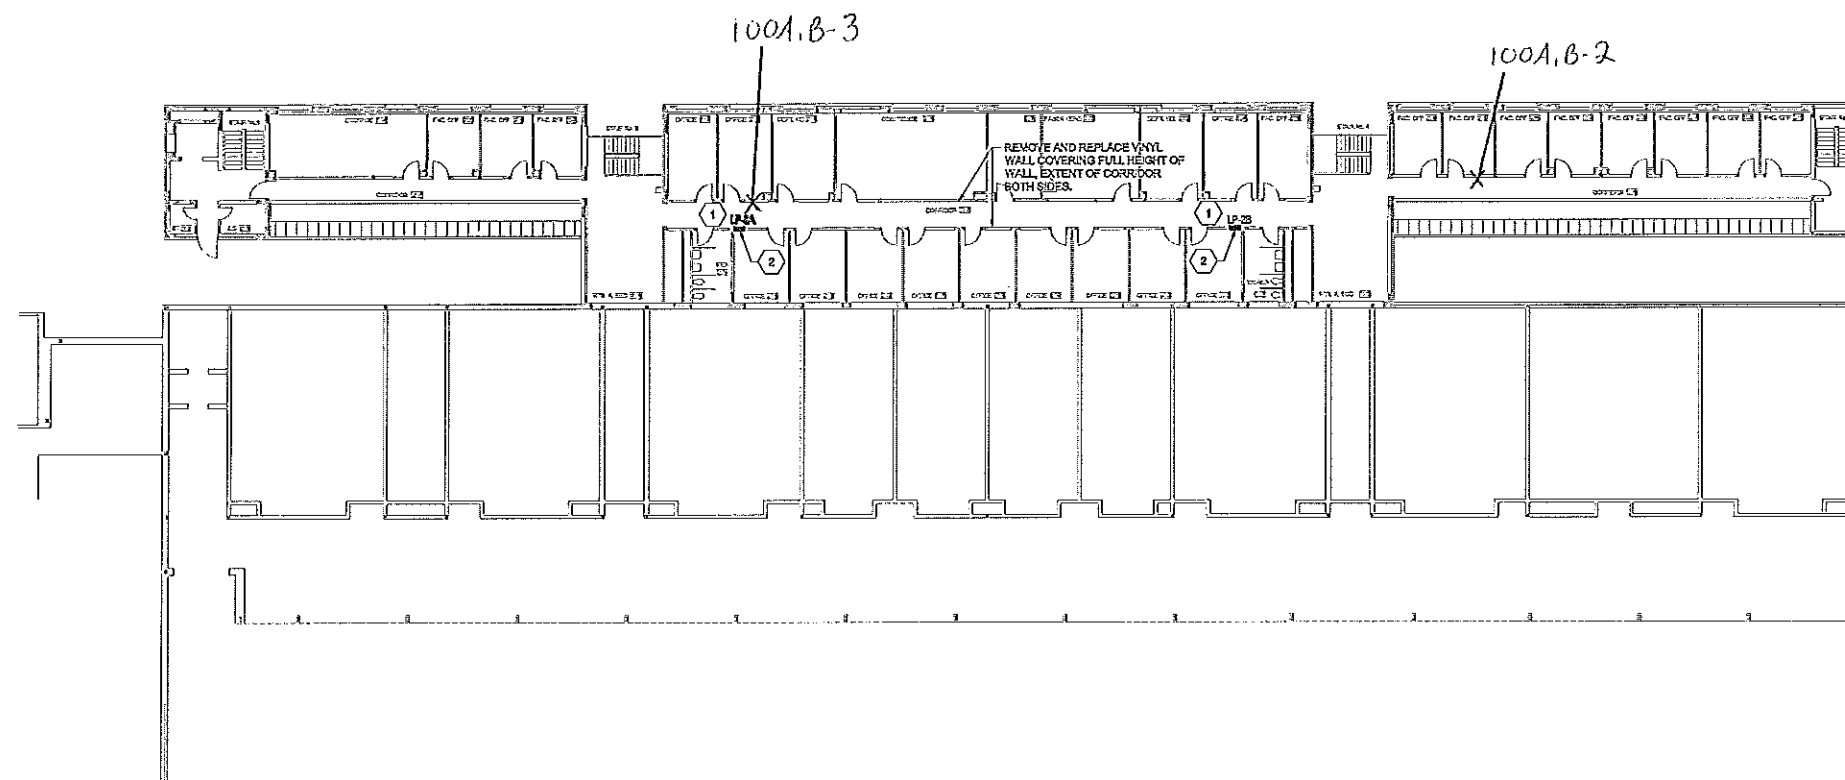

- DRAWING SPECIFIC NOTES**
- 1 REMOVE EXISTING PANELBOARD IN THIS LOCATION AND REPLACE WITH NEW PANEL BOARD AS SHOWN.
 - 2 SEE DETAIL E2-A-511 FOR ARCHITECTURAL WORK

A1 **TIMMERMAN - SECOND FLOOR PLAN**
SCALE: 1/8" = 1'-0"



0 8 16 32



C&S Engineers, Inc.
499 Col. Eileen Collins Blvd.
Syracuse, New York 13212
Phone: 315-455-2000
Fax: 315-455-9687
www.ccsos.com



STATE UNIVERSITY CONSTRUCTION FUND
NEW YORK

STATE UNIVERSITY CONSTRUCTION FUND
SUCF PROJECT NO. 12290
STATE UNIVERSITY OF NEW YORK AT POTSDAM
PRE-BID SUBMISSION - NOT FOR CONSTRUCTION
UPGRADE ELECTRICAL DISTRIBUTION SYSTEMS
VARIOUS BUILDINGS

MARK	DATE	DESCRIPTION
REVISIONS		
PROJECT NO.	190453001	
DATE:	DECEMBER 5, 2003	
SCALE:	AS SHOWN	
DRAWN BY:	P.N.L.W.J.	
DESIGNED BY:	T.A.K.I.R.E.A.N.Z.	
CHECKED BY:	J.L.ROSSINI, P.E.	
NO ALTERATION PERMITTED HEREON EXCEPT AS PROVIDED UNDER SECTION 7209 SUBDIVISION 2 OF THE NEW YORK EDUCATION LAW		

ELECTRICAL
TIMMERMAN
SECOND FLOOR
PLAN

E-100-27b

**S.U.C.F. PROJECT
NO. 12294**

**UPGRADE ENERGY
MANAGEMENT SYSTEMS -
VARIOUS BUILDINGS**

The State University
of New York at Potsdam
Potsdam, New York

**STATE UNIVERSITY
CONSTRUCTION
FUND**

STATE UNIVERSITY PLAZA
353 BROADWAY
ALBANY, NY 12246



www.bergmannpc.com

28 East Main Street
200 First Federal Plaza
Rochester, New York 14614
585.232.5135 / 585.232.4652 fax

Engineers / Architects / Planners / Surveyors

REVISIONS				
NO.	DATE	DESCRIPTION	REV.	CKD

PRE-BID SUBMISSION


NOTE:
Unauthorized alteration or addition to this drawing is a
violation of the New York State Education Law Article
145, Section 7609.

BARRINGTON BASEMENT PLAN

Project Manager
B. PORTER
Designer
M. SOMMERMAN
Checker
G. PARKER
Date
JANUARY 18, 2010
Scale
AS NOTED

Project Number: 7771.00
Drawing Number: ATC100-29

ATC100-29

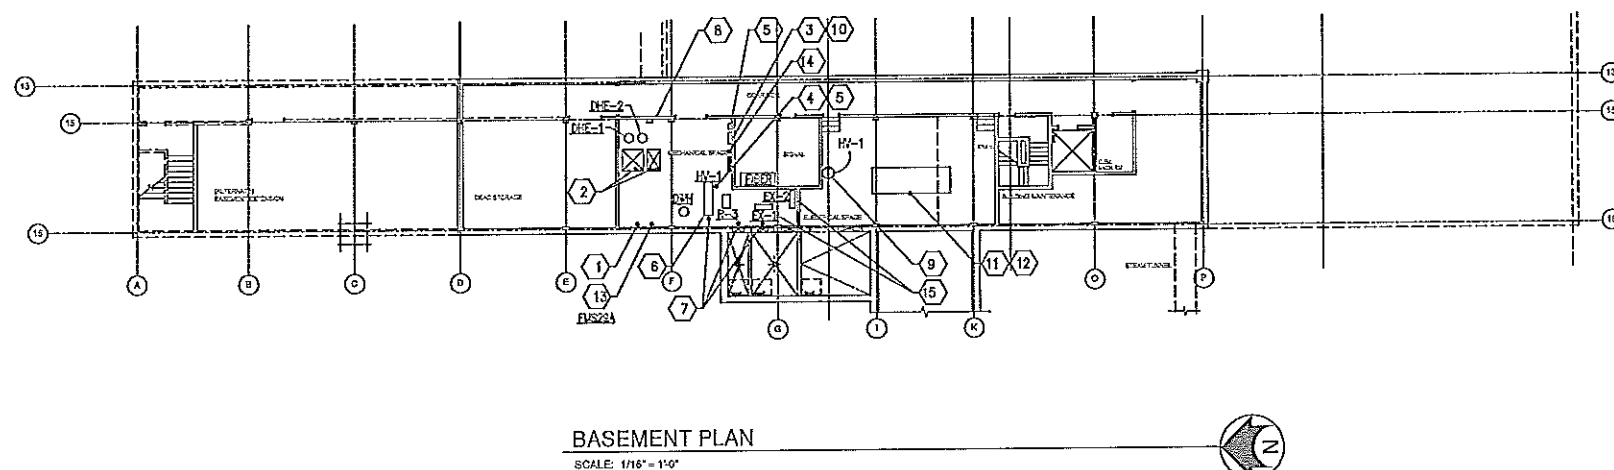

1 RENOVATION KEYNOTES:

- EXISTING WATER METER.
- EXISTING SLUMP PITS.
- HONEYWELL CONTROL PANEL TO BE REMOVED. TRANSFER 110V POWER TO NEW PANEL IN SAME LOCATION. PROVIDE 3/4" EMT CONDUIT WITH (2) MULTI-WIRE PEXOR OPTIC CABLES FROM FLOOR PATCH PANEL TO NEW CONTROL PANEL.
- HY-1 HEATING COIL CONTROL VALVES. REUSE VALVE ACTUATORS. INSTALL EP TRANSDUCERS AND LOCATE IN NEW CONTROL PANEL.
- RECIRCULATION PUMP P-PH FOR PREHEAT COIL. PROVIDE CONVENTION MOTOR STARTER WITH H-O-A SELECTOR SWITCH. PROVIDE STATUS POINTS AND DOO START/STOP CAPABILITIES. SEE FLOW DIAGRAM.
- REMOVE EXISTING SENSORS AND INSTALL NEW TEMPERATURE, HUMIDITY AND LOW LIMIT SENSORS FOR HY-1. REFER TO FLOW DIAGRAM AND POINTS LIST. CONNECT TO NEW CONTROL PANEL IN THIS ROOM. PATCH HOLES IN DUCTWORK FROM SENSOR REMOVALS.
- EXISTING VALVES FOR HY-1 SYSTEM. REUSE ACTUATORS. INSTALL TRANSDUCERS AS REQUIRED BY POINTS LIST AND LOCATE IN NEW CONTROL PANEL IN THIS ROOM.
- DOMESTIC HOT WATER SYSTEM. REFER TO FLOW DIAGRAM AND POINTS LIST FOR DETAILS. PROVIDE CONVENTION MOTOR STARTER WITH H-O-A SELECTOR SWITCH FOR P-PH. PROVIDE STATUS POINTS AND DOO START/STOP CAPABILITIES. SEE FLOW DIAGRAM.
- EXISTING TEMPERATURE SENSOR ON WALL. REMOVE AND REPLACE WITH NEW SENSOR AND REUSE TO NEW CONTROL PANEL.
- SUGGESTED LOCATION FOR NEW CONTROL PANEL.
- EXISTING 3 PHASE TEMPERATURE MONITOR. PROVIDE TIE-INS TO DOO PANEL.
- PROVIDE OUTLET HUMIDITY POWER QUALITY METER. PROVIDE TIE-INS TO DOO PANEL. SEE WIRING DIAGRAM #19 ON DRAWING AIG-06A.
- EXISTING STEAM ENTRY. PROVIDE NEW FLOW METER FMS-22A. PROVIDE 3/4" EMT CONDUIT WITH 2-#12 AND 1-#12 GROUND FROM 110V POWER SUPPLY IN KEYNOTE #3.
- PROPOSED LOCATION OF REMOTE STEAM METER DISPLAY AND FLOW PROCESSOR. PROVIDE 3/4" EMT CONDUIT BETWEEN REMOTE METER AND STEAM ENTRY IN KEYNOTE #13. INSTALL FACTORY SUPPLIED CABLEING.
- PROVIDE CONVENTION MOTOR STARTERS WITH H-O-A SELECTOR SWITCH FOR EXHAUST FANS EX-1 AND EX-2. PROVIDE STATUS POINTS AND DOO START/STOP CAPABILITIES. REFER TO FLOW DIAGRAM AND POINTS LIST FOR DETAILS.

**S.U.C.F. PROJECT
NO. 12294**
**UPGRADE ENERGY
MANAGEMENT SYSTEMS -
VARIOUS BUILDINGS**
The State University
of New York at Potsdam
Potsdam, New York

**STATE UNIVERSITY
CONSTRUCTION
FUND**
STATE UNIVERSITY PLAZA
353 BROADWAY
ALBANY, NY 12246



www.bergmannpc.com

28 East Main Street
200 First Federal Plaza
Rochester, New York 14614
585.232.5135 / 585.232.4652 fax


Engineers / Architects / Planners / Surveyors

REVISIONS			
NO.	DATE	DESCRIPTION	REV. CSD

**PRE-BID
SUBMISSION**

NOTE:
Unauthorized alteration or addition to this drawing is a
violation of the New York State Education Law Article
145, Section 7209.

**BARRINGTON
FIRST FLOOR PLAN**

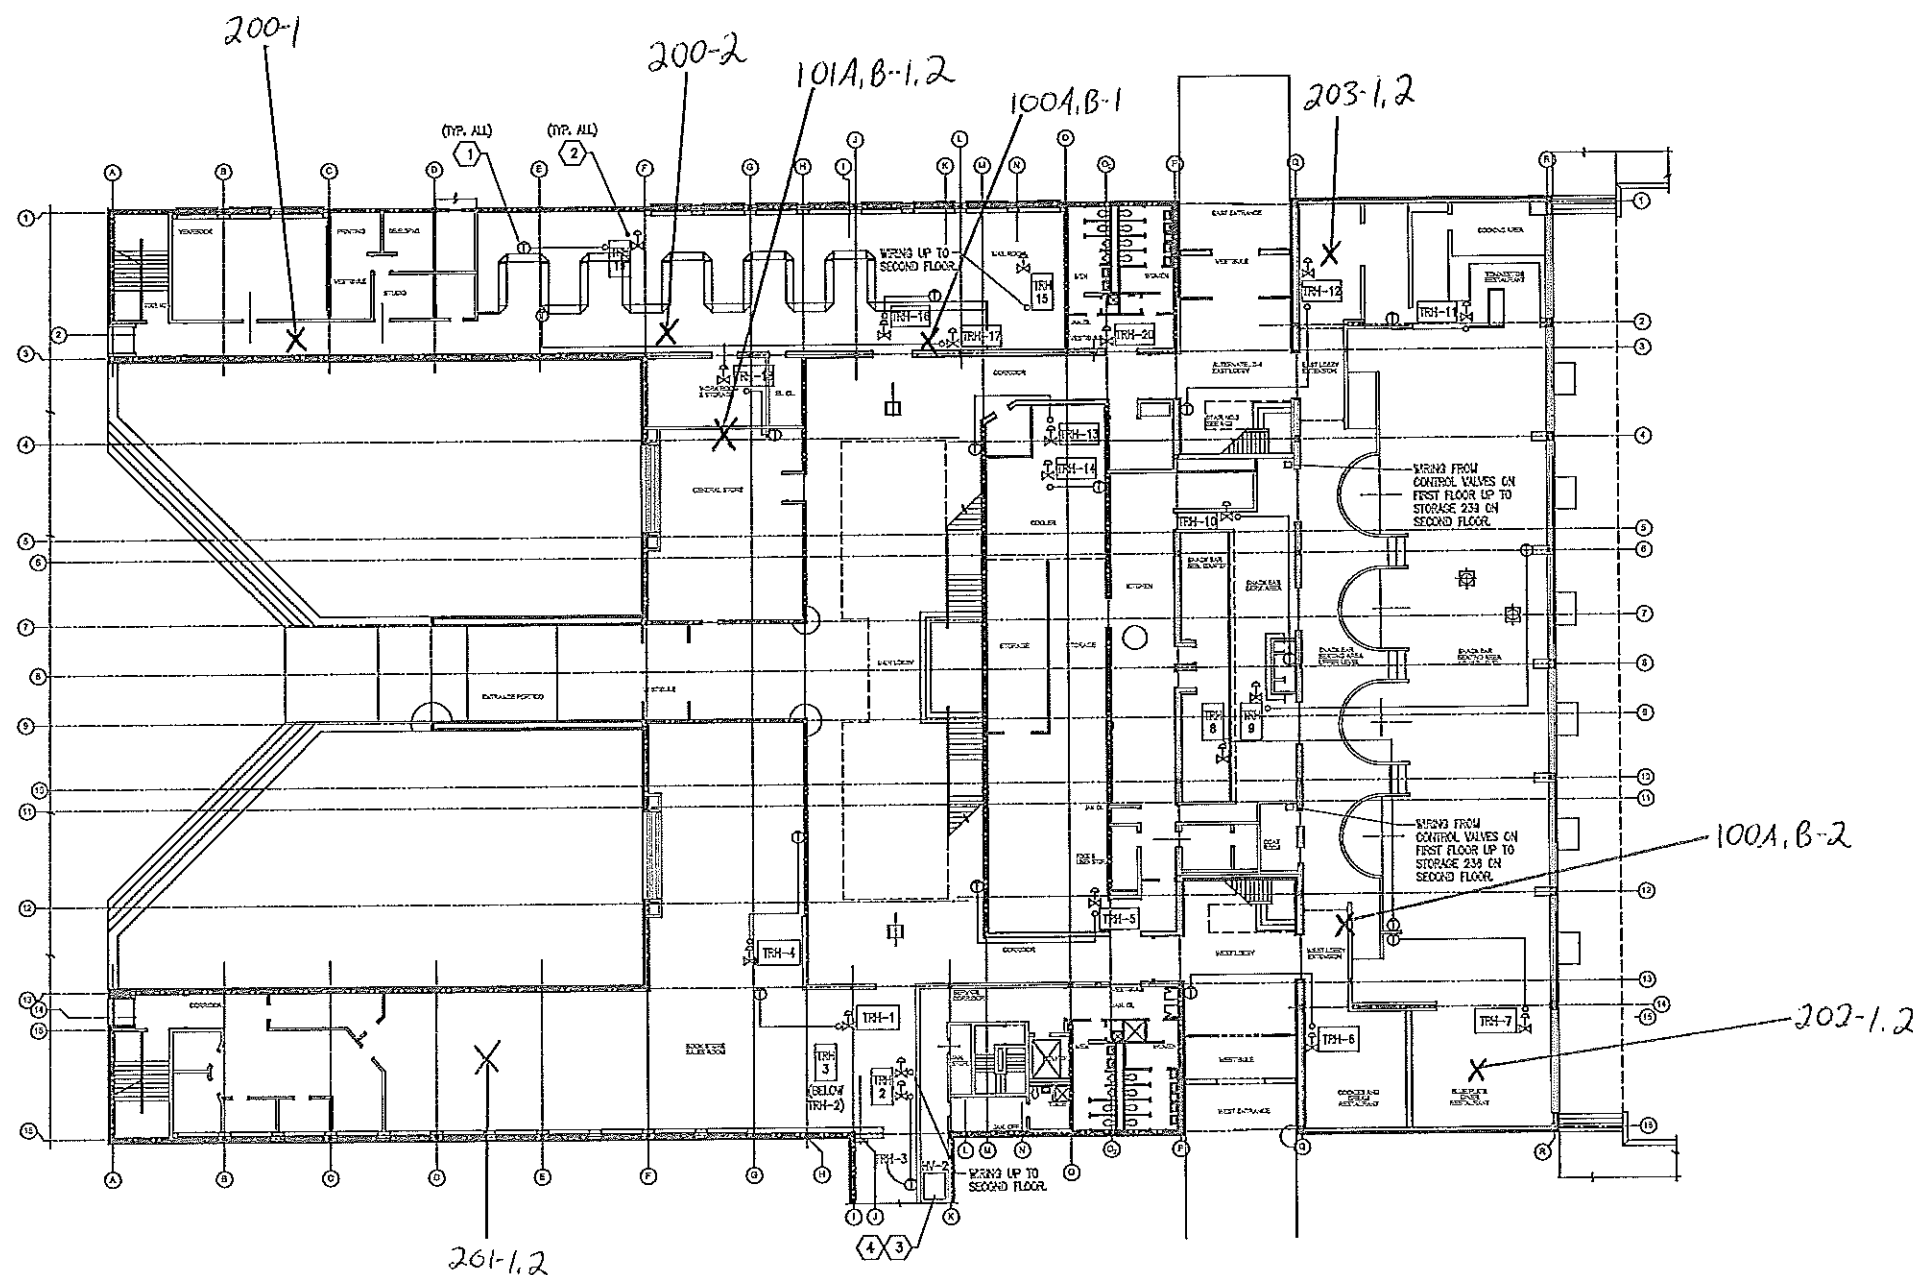

FIRST FLOOR PLAN
SCALE: 1/16" = 1'-0"

GENERAL NOTES:

1. TYPICALLY RUN NEW WIRELOID FROM NEW SENSORS UP ALONG WALL AND ACROSS CEILING TO REHEAT COIL CONTROL VALVE ABOVE CEILING. FIELD VERIFY EXACT LOCATION OF CONTROL VALVE BEFORE START OF WORK.
2. RUN WIRELOID IN CORRIDOR CLOSE TO WALL, NOT DOWN MIDDLE OF CORRIDOR.

① RENOVATION KEYNOTES:

1. EXISTING TEMPERATURE SENSOR FOR SPACE. REMOVE AND REPLACE WITH NEW SENSOR. RUN WIRELOID IN NEW WIRELOID IN FINISHED SPACES. CONNECT TO NEW EP TRANSDUCER AT CONTROL VALVE AND NEW CONTROL PANEL IN MECHANICAL ROOM IN ATTIC.
2. EXISTING REHEAT VALVE ABOVE CEILING. REUSE EXISTING ACTUATOR. INSTALL EP TRANSDUCER AND CONNECT TO NEW CONTROL PANEL IN MECHANICAL ROOM IN ATTIC.
3. PROVIDE H-O-A SELECTOR SWITCH IN EXISTING OILBURNER MOTOR STARTER FOR H-2. PROVIDE STATUS POINTS AND REMOTE START/STOP CAPABILITIES. SEE FLOW DIAGRAM.
4. PROVIDE TEMPERATURE SENSORS AND EP TRANSDUCER FOR H-2. REUSE EXISTING PNEUMATIC VALVE ACTUATOR. REFER TO FLOW DIAGRAM AND POINTS LIST FOR DETAILS.

Project Manager:
D. PORTER
Designer:
M. SCHWARTZMAN
Draftsman:
G. PARKER
Check by:
JANUARY 18, 2002
Scale:
AS NOTED

Project Number: 7771.00 File Name: 10101-29.dwg
Drawing Number: 10101-29.dwg

ATC101-29

**S.U.C.F. PROJECT
NO. 12294**
**UPGRADE ENERGY
MANAGEMENT SYSTEMS -
VARIOUS BUILDINGS**
The State University
of New York at Potsdam
Potsdam, New York

**STATE UNIVERSITY
CONSTRUCTION
FUND**
STATE UNIVERSITY PLAZA
353 BROADWAY
ALBANY, NY 12246



www.bergmannpo.com

28 East Main Street
200 First Federal Plaza
Rochester, New York 14614
585.232.6135 / 585.232.4652 fax


Engineers / Architects / Planners / Surveyors

REVISIONS				
NO.	DATE	DESCRIPTION	REV.	CKD.

**PRE-BID
SUBMISSION**

NOTE:
Unauthorized alteration or addition to this drawing is a
violation of the New York State Education Law Article
145, Section 7209.

**BARRINGTON
SECOND FLOOR PLAN**

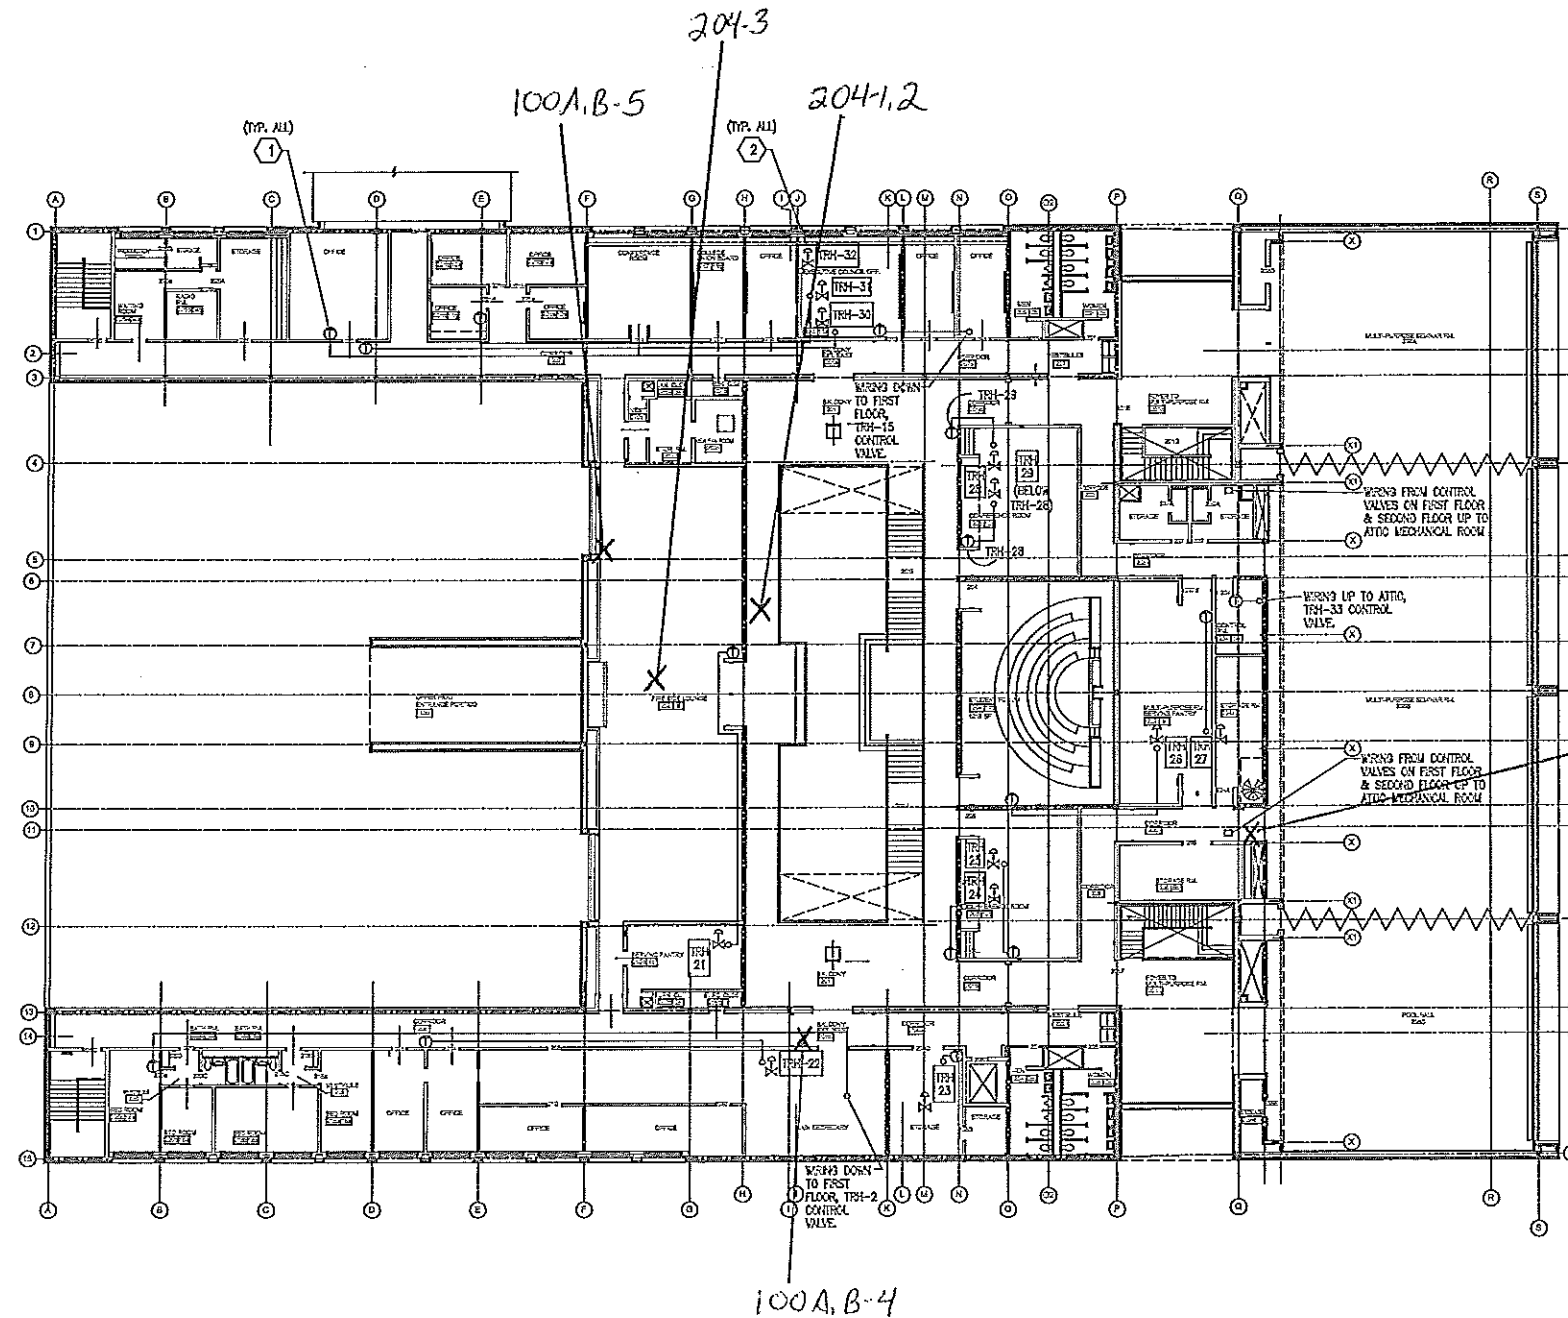

SECOND FLOOR PLAN
SCALE: 1/16" = 1'-0"

GENERAL NOTES:

1. TYPICALLY RUN NEW WIREMOLD FROM NEW SENSORS UP ALONG WALL AND ACROSS CEILING TO REHEAT COIL CONTROL VALVE ABOVE CEILING. FIELD VERIFY EXACT LOCATION OF CONTROL VALVE BEFORE START OF WORK.
2. RUN WIREMOLD IN CORRIDOR CLOSE TO WALL, NOT DOWN MIDDLE OF CORRIDOR.

RENOVATION KEYNOTES:

1. EXISTING TEMPERATURE SENSOR FOR SPACE, REMOVE AND REPLACE WITH NEW SENSOR. RUN WIRING IN NEW WIREMOLD IN FINISHED SPACES. CONNECT TO NEW EP TRANSDUCER AT CONTROL VALVE AND NEW CONTROL PANEL IN MECHANICAL ROOM IN ATTIC.
2. EXISTING REHEAT VALVE ABOVE CEILING. REMOVE EXISTING ACTUATOR. INSTALL EP TRANSDUCER AND CONNECT TO NEW CONTROL PANEL IN MECHANICAL ROOM IN ATTIC.

Project Manager:	D. PORTER
Designer:	M. SCHWARTZ
Drawn by:	G. PARKER
Checked by:	
Date:	JANUARY 18, 2009
Scale:	AS NOTED

Project Number: 7711.00 File Name: BARRINGTON SECOND FLOOR PLAN.dwg

Drawing Number: 100A.B-5

ATC102-29



C&S Engineers, Inc.
499 Col. Eileen Collins Blvd.
Syracuse, New York 13212
Phone: 315-455-2000
Fax: 315-455-9667
www.ccsny.com




STATE UNIVERSITY CONSTRUCTION FUND
NEW YORK

STATE UNIVERSITY CONSTRUCTION FUND
SUCF PROJECT NO. 12290
STATE UNIVERSITY OF NEW YORK AT POTSDAM
PRE-BID SUBMISSION - NOT FOR CONSTRUCTION
UPGRADE ELECTRICAL DISTRIBUTION SYSTEMS
VARIOUS BUILDINGS

MARK	DATE	DESCRIPTION
REVISIONS		
1	12/05/03	PROJECT NO. 12290
2	12/05/03	DATE
3	12/05/03	SCALE
4	12/05/03	DESIGNED BY: T.O. KIRKINZ
5	12/05/03	CHECKED BY: J.L. ROBBINS, P.E.
NO ALTERATION PERMITTED HEREON EXCEPT AS PROVIDED UNDER SECTION 7203 SUBDIVISION 2 OF THE NEW YORK EDUCATION LAW		

ELECTRICAL
LEHMAN HALL
BASEMENT &
SECOND FLOOR
PLANS

E-100-30

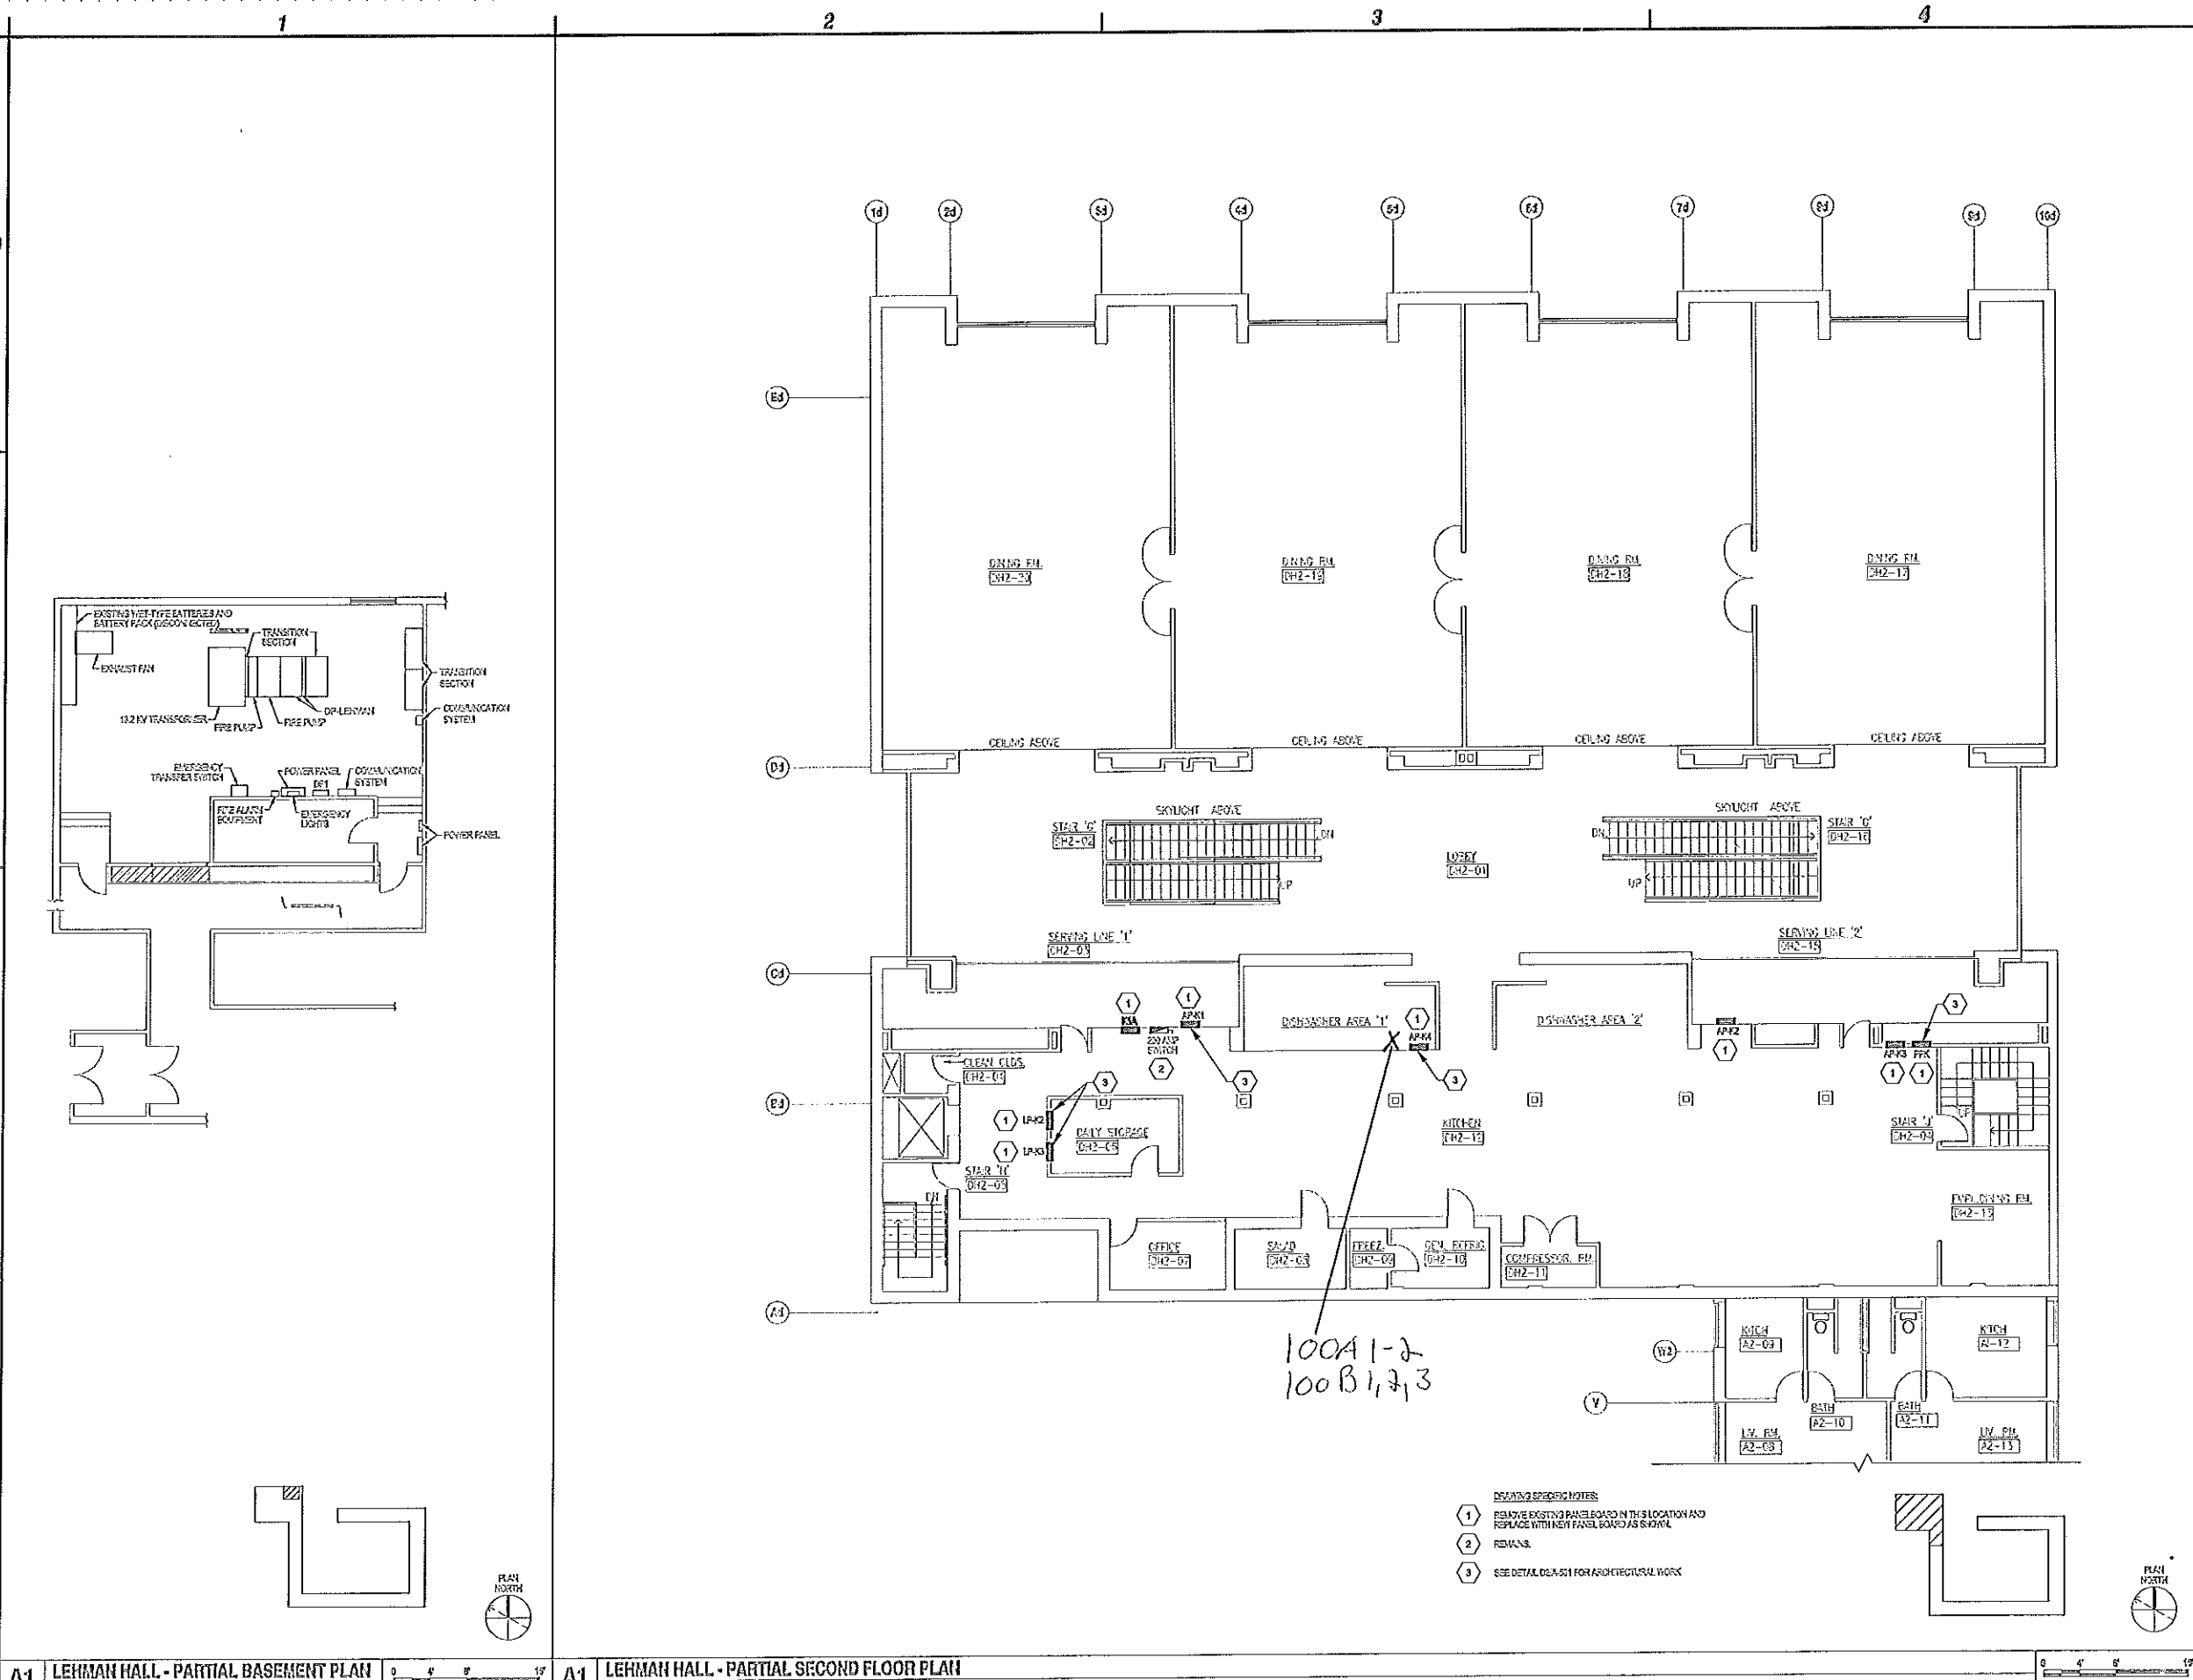

A1 LEHMAN HALL - PARTIAL BASEMENT PLAN
SCALE 1/8" = 1'-0"

A1 LEHMAN HALL - PARTIAL SECOND FLOOR PLAN
SCALE 1/8" = 1'-0"